




W. 16' 00" E 100.00

Grading Plan Approved
as shown and/or noted
THOMAS P. GILLES, P.E.
Lake County Engineer

BY me Date 7-24-9

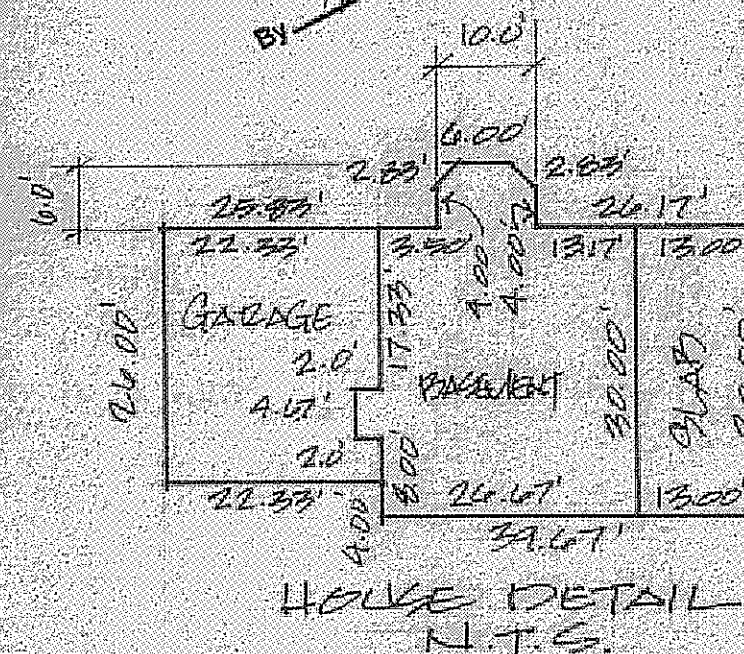

Concord LAKE COUNTY, OHIO

for: HILLIARD HOMES
 CLIENT OWNER
15341 KIDPATH AVE CLEVELAND 44144
 ADDRESS STREET CITY ZIP

<u>FORESTWOOD</u>		<u>LOT</u>	<u>TRACT</u>
<u>SUBDIVISION</u>	<u>Y-20 NAME</u>	<u>VOLUME</u>	<u>PAGE</u>
<u>4</u>	<u>WOL-PC</u>		
<u>SUBLOT NO.</u>	<u>STREET</u>	<u>PERM. PARCEL NO.</u>	<u>STREET</u>
	<u>HINDREA</u>		

SANITARY MANHOLE	-----		WATER VALVE (GAS)	-----	
STORM MANHOLE	-----		WATER METER (GAS)	-----	
INLET OR CATCH BASIN	-----		AS BUILT ELEVATION	-----	
HYDRANT	-----				
EXISTING CONTOURS	-----		INDICATES		
PROPOSED CONTOURS	-----		DIRECTION OF		
EXIST. ELEV.	-----		SURFACE DRAINAGE		

ALL BOUNDARY DATA SHOWN WAS OBTAINED FROM IDEADS, RECORDED
SUPERVISION PLAT OR OTHER PUBLIC RECORDS.

LOCATIONS AS SHOWN OF ADJACENT WELLS AND SEPTIC TANKS OBTAINED FROM
LAKE COUNTY HEALTH DEPARTMENT

THIS PLAT WAS PREPARED BY ME, AND IS CORRECT
TO THE BEST OF MY KNOWLEDGE AND BELIEF.

NAME	SURVEYOR	REGISTRATION NO.

NO. OF BEDROOMS	WATER MAIN SIZE, LOCATION
DIMENSIONS	SAN. SEWER SIZE % GR. LOC.
BEARINGS	SAN. MH. CAST. ELEV. INV. ELEV.
TIE TO NEAREST STREET	SAN. CONN. SIZE, LOC. DPTH.
SUBLOT NO. PARCEL NO.	STORM SEWER SIZE % GR. LOC.
SURROUNDING OWNERS	STORM MH. CAST. ELEV. INV. ELEV.
BLD. DIMENSIONS FIN. GR.	PAV'T TYPE GRADE CURBS
BLDG. TIES FLR. GRADES	GA. LINE LOC. SIZE PRESSURE
APRON TYPE WIDTH THICKNESS	SEPTIC TANK LOCATION & DUPLICATION AREA
SIDEWALK TYPE WIDTH THICKNESS	WELL LOCATION
CULVERT TYPE DIA. LENGTH	ISOLATION RADIUS FROM WELL
ROCK OUTCROPPINGS	

REVISIONS			PLAN PREPARED BY:		
NO.	DATE	BY	DEBEVEC • SALO & ASSOCIATES, INC.		
1	7/15/81	KEW	125 E ERIE ST. PAINESVILLE, OHIO		
2			DRAWN BY	SCALE	PHONE NO.
3			C.H.K.	1" = 10'	352-8250
4			CHECK'D	DATE	DRAWING NO.
5				10/1/81	
6			CREW	APP'D.	5750-4
7			CHIEF		

I, HEREBY CERTIFY THAT THE CIRCLED GRADES ARE EXISTING
FINISH GRADES CHECKED IN THE FIELD ON _____ 19 _____
AND ARE CORRECT TO THE BEST OF MY KNOWLEDGE AND BELIEF

REGISTERED SURVEYOR REG NO.

NOTE:

1. DRIVEWAY LOCATION PROVIDED BY CLIENT
2. INSURE THAT DRIVEWAY CLEARS HYDRANT BY MINIMUM OF 2'

ZONING PERMIT #4369

ISSUED 7-20-81

SUBJECT TO APPROVAL BY:

Lake County Sanitary Eng. ☐

Lake County Eng. Dept. ☒

Lake County Planning Comm.

Lake County Bldg. Dept. ☒

Teno A Marano

0750-1000