


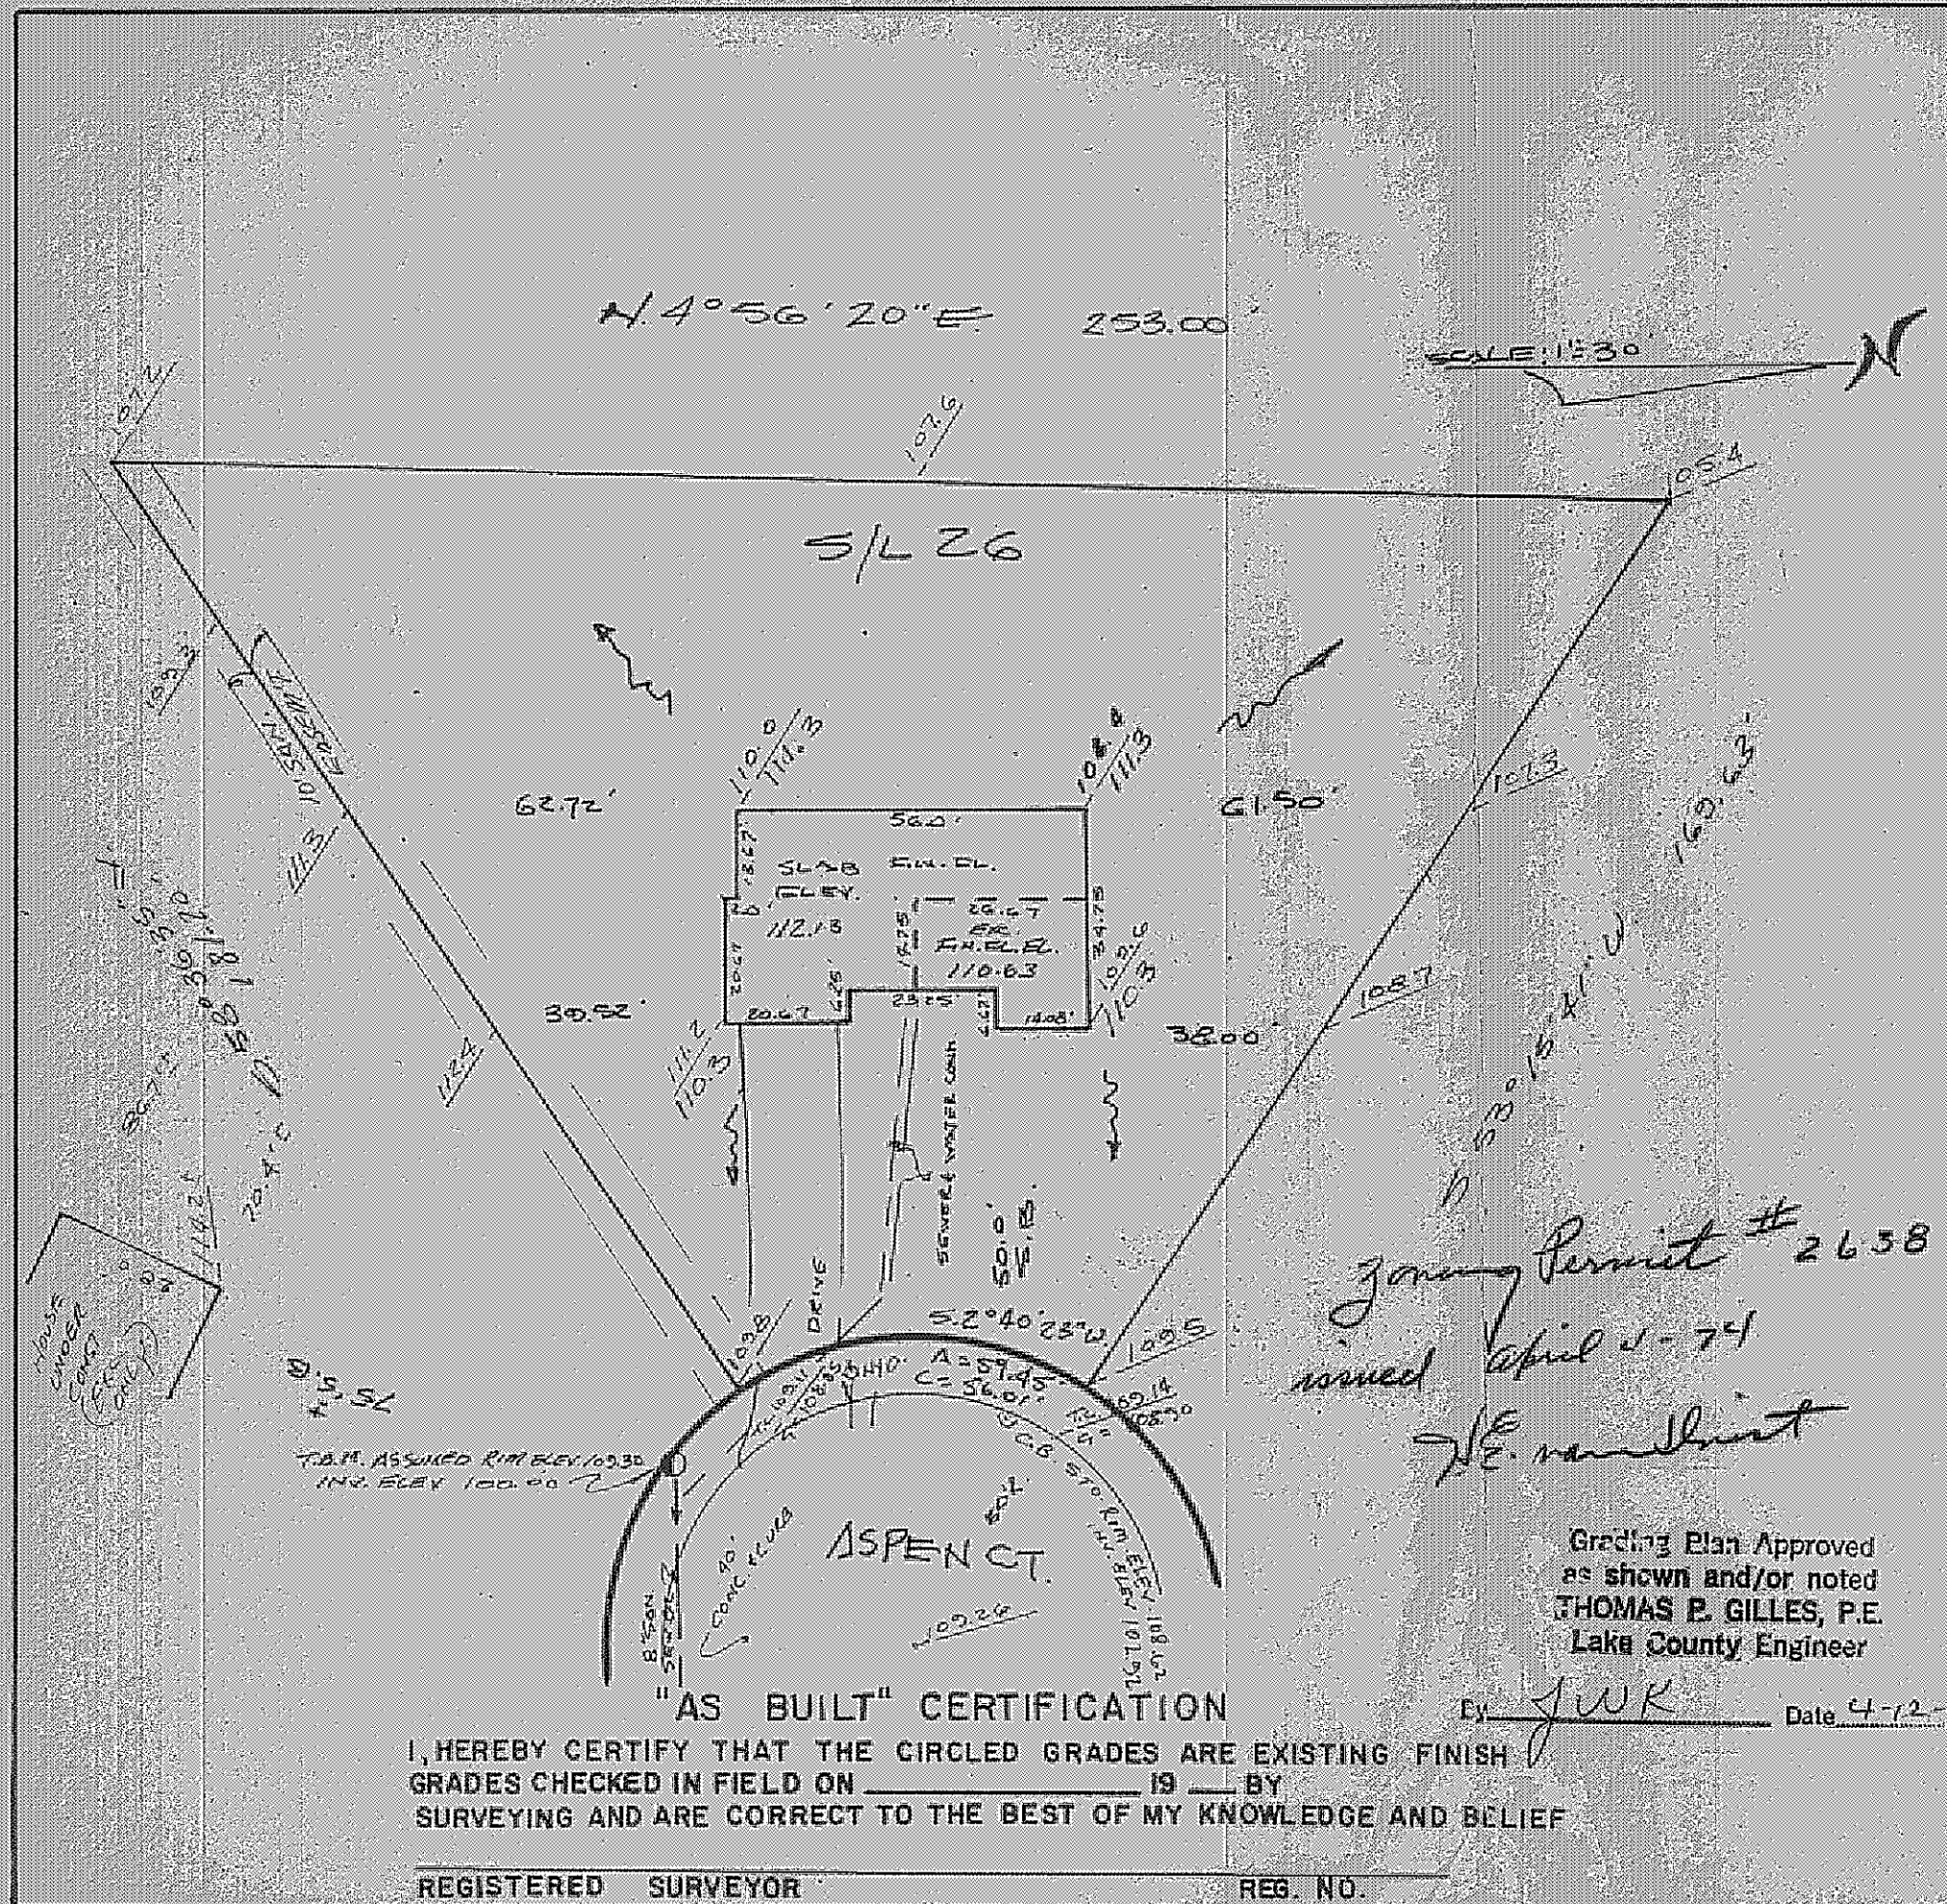

SITE PLAN	
CONCORD TOWNSHIP LAKE COUNTY, OHIO	
for: CLIENT OWNER	
ADDRESS STREET CITY ZIP	
MORLEY HILLS EST.	
SUBDIVISION 2-41 NAME	
VOL. - PG. 26 151EN CT.	
SUBLOT NO. STREET 20	
LOT TRACT	
VOLUME PAGE	
PERM. PARCEL # STREET	
LEGEND	
SANITARY MANHOLE --- (1)	
STORM MANHOLE --- (2)	
INLET OR CATCH BASIN --- (3)	
HYDRANT --- (4)	
EXISTING CONTOURS --- (5)	
PROPOSED CONTOURS --- (6)	
EXIST. ELEV. 100.0	
100.0 2 PROP. ELEV.	
WATER VALVE (GAS) --- (7)	
WATER METER (GAS) --- (8)	
AS BUILT ELEVATION	
INDICATES DIRECTION OF SURFACE DRAINAGE	
REMARKS	
ALL BOUNDARY DATA SHOWN WAS OBTAINED FROM (DEEDS, RECORDED SUBDIVISION PLAT OR OTHER PUBLIC RECORDS)	
DESIGN CERTIFICATION	
THIS PLAT WAS PREPARED BY ME, AND IS CORRECT TO THE BEST OF MY KNOWLEDGE AND BELIEF	
NAME SURVEYOR REGISTRATION NO. PS #5244	
CHECK LIST	
DIMENSIONS	
BEARINGS	
TIE TO NEAREST STREET	
SUBLOT NO. PARCEL NO.	
SURROUNDING OWNERS	
BLDG. DIMENSIONS FIN. GR.	
BLDG. TIES FLR. GRADES	
APRON TYPE WIDTH THICKNESS	
SIDEWALK TYPE WIDTH THICKNESS	
CULVERT TYPE DIA. LENGTH	
WATER MAIN SIZE LOCATION	
SAN. SEWER SIZE % GR. LOC.	
SAN. MH CAST ELEV. INV. ELEV.	
SAN. CONN. SIZE LOC. DEPTH	
STORM SEWER SIZE % GR. LOC.	
STORM MH CAST ELEV. INV. ELEV.	
PAVT. TYPE GRADE CURBS	
GAS LINE LOC. SIZE PRESSURE	
SEPTIC TANK SIZE LOC.	
WELL LOCATION	
REVISIONS	
PLAN PREPARED BY:	
DEBEVEC-SALO & ASSOC, INC.	
130 EAST JACKSON ST. PAINESVILLE	
DRAWN BY	
SCALE 1" = 30'	
PHONE NO.	
DATE 4-2-74	
DRAWING NO.	
APPD	
4135	