

SITE PLAN

Colcord Township Lake County, Ohio
 for: DI SILESTRO BUILDERS

ADDRESS: STREET CITY: ST ZIP: 43001

PROJECT: 240
 VOLUME: 19
 SHEET: 19

LEGEND
 SANITARY MANHOLE
 WATER VALVE (GAS)
 WATER METER (GAS)
 AS BUILT ELEVATION
 INLET OR CATCH BASIN
 EXISTING CONTOURS
 PROPOSED CONTOURS
 TRUST ELEV.
 100% PROP. ELEV.
 INDICATES DIRECTION OF SURFACE DRAINAGE

REMARKS
 ALL BOUNDARY DATA SHOWN WAS OBTAINED FROM IDEEDS, RECORDED SUBDIVISION PLAT OR OTHER PUBLIC RECORDS.
 LOCATIONS AS SHOWN OF ADJACENT WELLS AND SEPTIC TANKS OBTAINED FROM LAKE COUNTY HEALTH DEPARTMENT

DESIGN CERTIFICATION
 THIS PLAT WAS PREPARED BY ME, AND IS CORRECT TO THE BEST OF MY KNOWLEDGE AND BELIEF.
 NAME: HARRY S. JONES, JR. REGISTRATION NO.: 56343

CHECK LIST
 NO. OF BEDROOMS
 DIMENSIONS
 TIE TO NEAREST STREET
 SURVEY NO. PARCEL NO.
 SURROUNDING CORNERS
 BLOCK DIMENSIONS
 ADJACENT TYPE WIDTH THICKNESS
 SEPTIC TANK LOCATION & DIMENSIONS
 WELL LOCATION
 ISOLATION WALLS FROM WELL

PLAN PREPARED BY:
 BABCOCK & JONES & ASSOCIATES, INC.
 PAINESVILLE, OHIO
 DRAWN BY: HJ SCALE: 1" = 30' PHONE NO.: 357-1811
 CHECKED BY: HJ DATE: 11/28/88 DRAWING NO.: 88-238-19

"AS BUILT" CERTIFICATION
 I, HEREBY CERTIFY THAT THE CIRCLED GRADES ARE EXISTING FINISH GRADES CHECKED IN THE FIELD ON 19 AND ARE CORRECT TO THE BEST OF MY KNOWLEDGE AND BELIEF.


REGISTERED SURVEYOR
 REG. NO. 56343

7001 - Rm 504 M.H.
 ELEV. - 611.8
 # 6044
 ZONING PERMIT
 12-30-88

STATE OF OHIO
 HARRY S. JONES, JR.
 56343
 SURVEYOR

Lake County Trustee's Office
 Lake County Sigs Dept.

Tenn. I. Marano

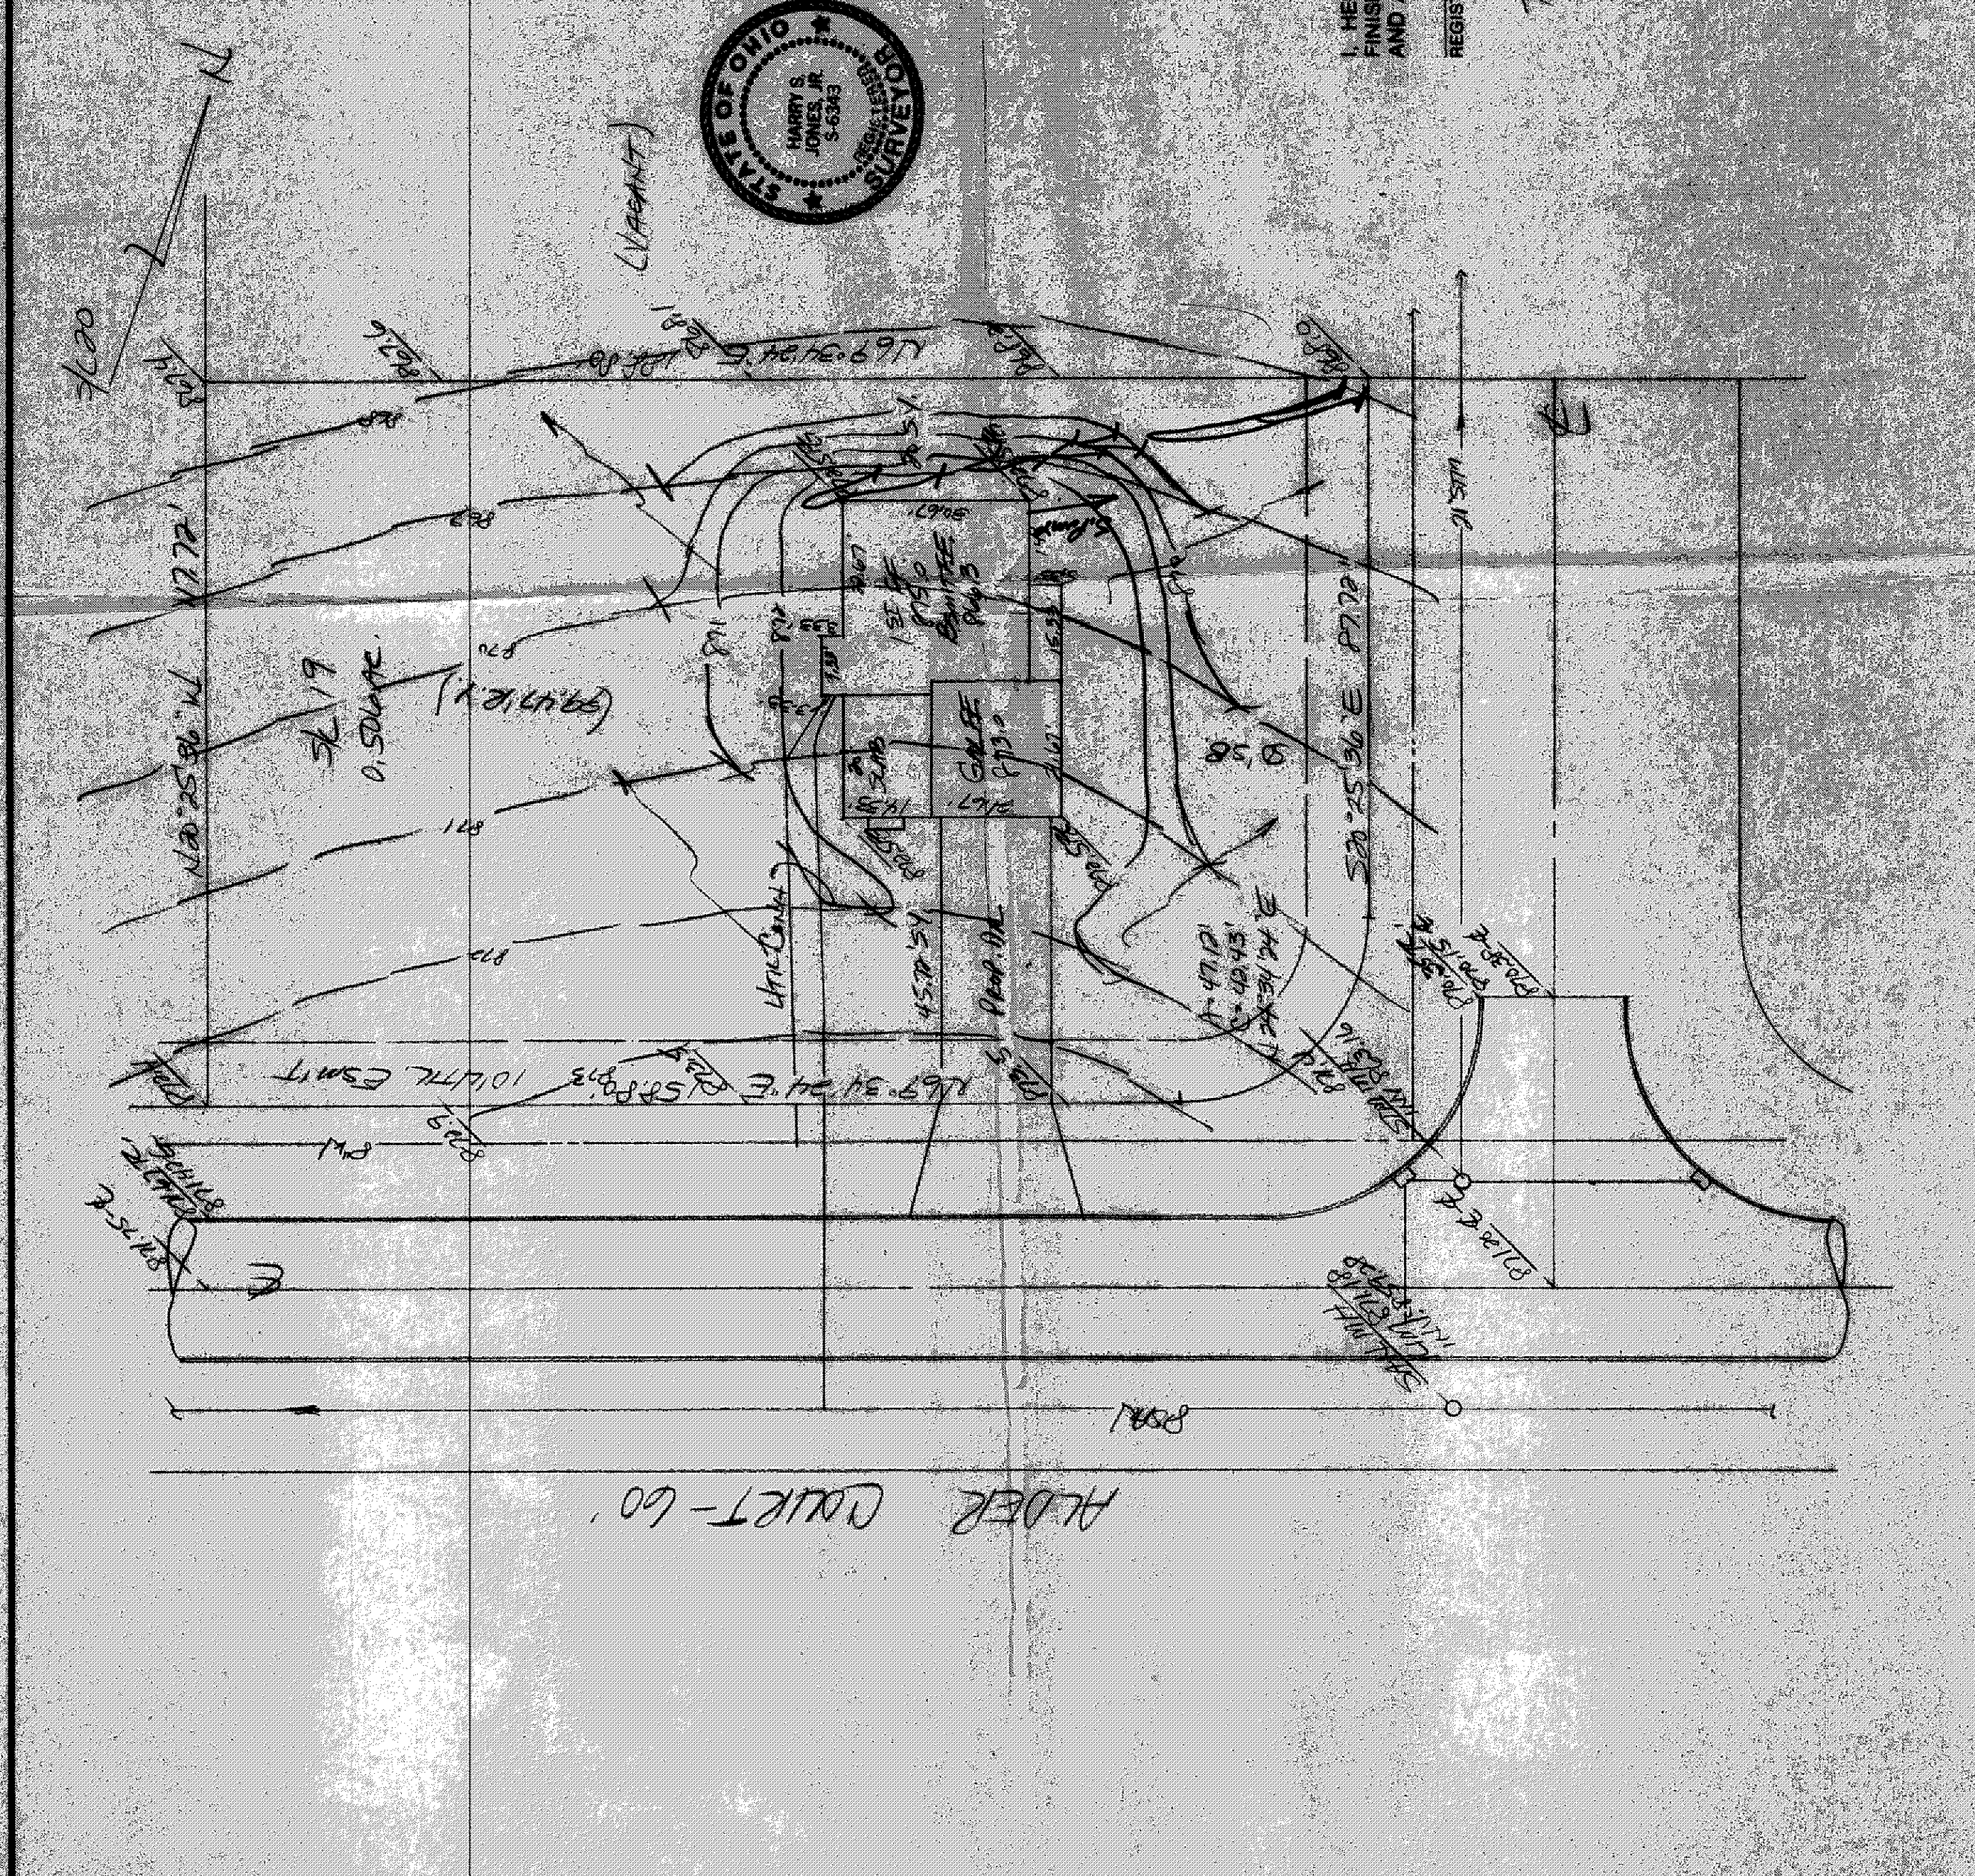

SITE PLAN

Collected Township Lake County, Ohio

for: 11 Silvestro Builders

CLIENT OWNER

ADDRESS STREET CITY ST

Plot # 11 Silvestro Sub 449

TRACT

SECTION 19

PAGE

SUBLOT NO. STREET

STREET

LEGEND

INDICATES DIRECTION OF SURFACE DRAINAGE

EXIST. ELEV. 1000

PROF. ELEV.

REMARKS

ALL SURVEY DATA SHOWN WAS OBTAINED FROM (JEEDS, RECORDED SUBDIVISION PLAT ON OTHER PUBLIC RECORDS) LOCATIONS AS SHOWN OF ADJACENT WELLS AND SEPTIC TANKS OBTAINED FROM LAKE COUNTY HEALTH DEPARTMENT

DESIGN CERTIFICATION

THIS PLAT WAS PREPARED BY ME, AND IS CORRECT TO THE BEST OF MY KNOWLEDGE AND BELIEF

CHECK LIST

NAME SURVEYOR REGISTRATION NO.

NO. OF BEDROOMS

WATER MAIN SIZE, LOCATION

SEWER SIZE, OR, LOC.

PLAN PREPARED BY:

REVISIONS

DATE BY

NO. OF SEWERS

DATE BY

NO. OF CATCH BASINS

DATE BY

NO. OF HYDRANTS

DATE BY

NO. OF EXISTING CONTOURS

DATE BY

NO. OF PROPOSED CONTOURS

DATE BY

NO. OF EXIST. ELEV.

DATE BY

NO. OF PROF. ELEV.

DATE BY

NO. OF EXIST. ELEV.

DATE BY

NO. OF PROF. ELEV.

DATE BY

NO. OF EXIST. ELEV.

DATE BY



NO. OF PROF. ELEV.

DATE BY

NO. OF EXIST. ELEV.

DATE BY

ALDER COURT-60'

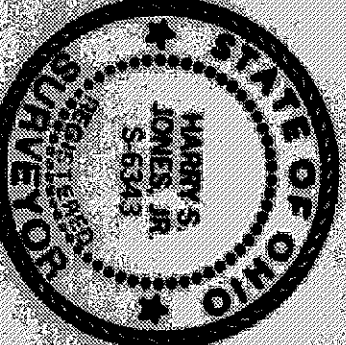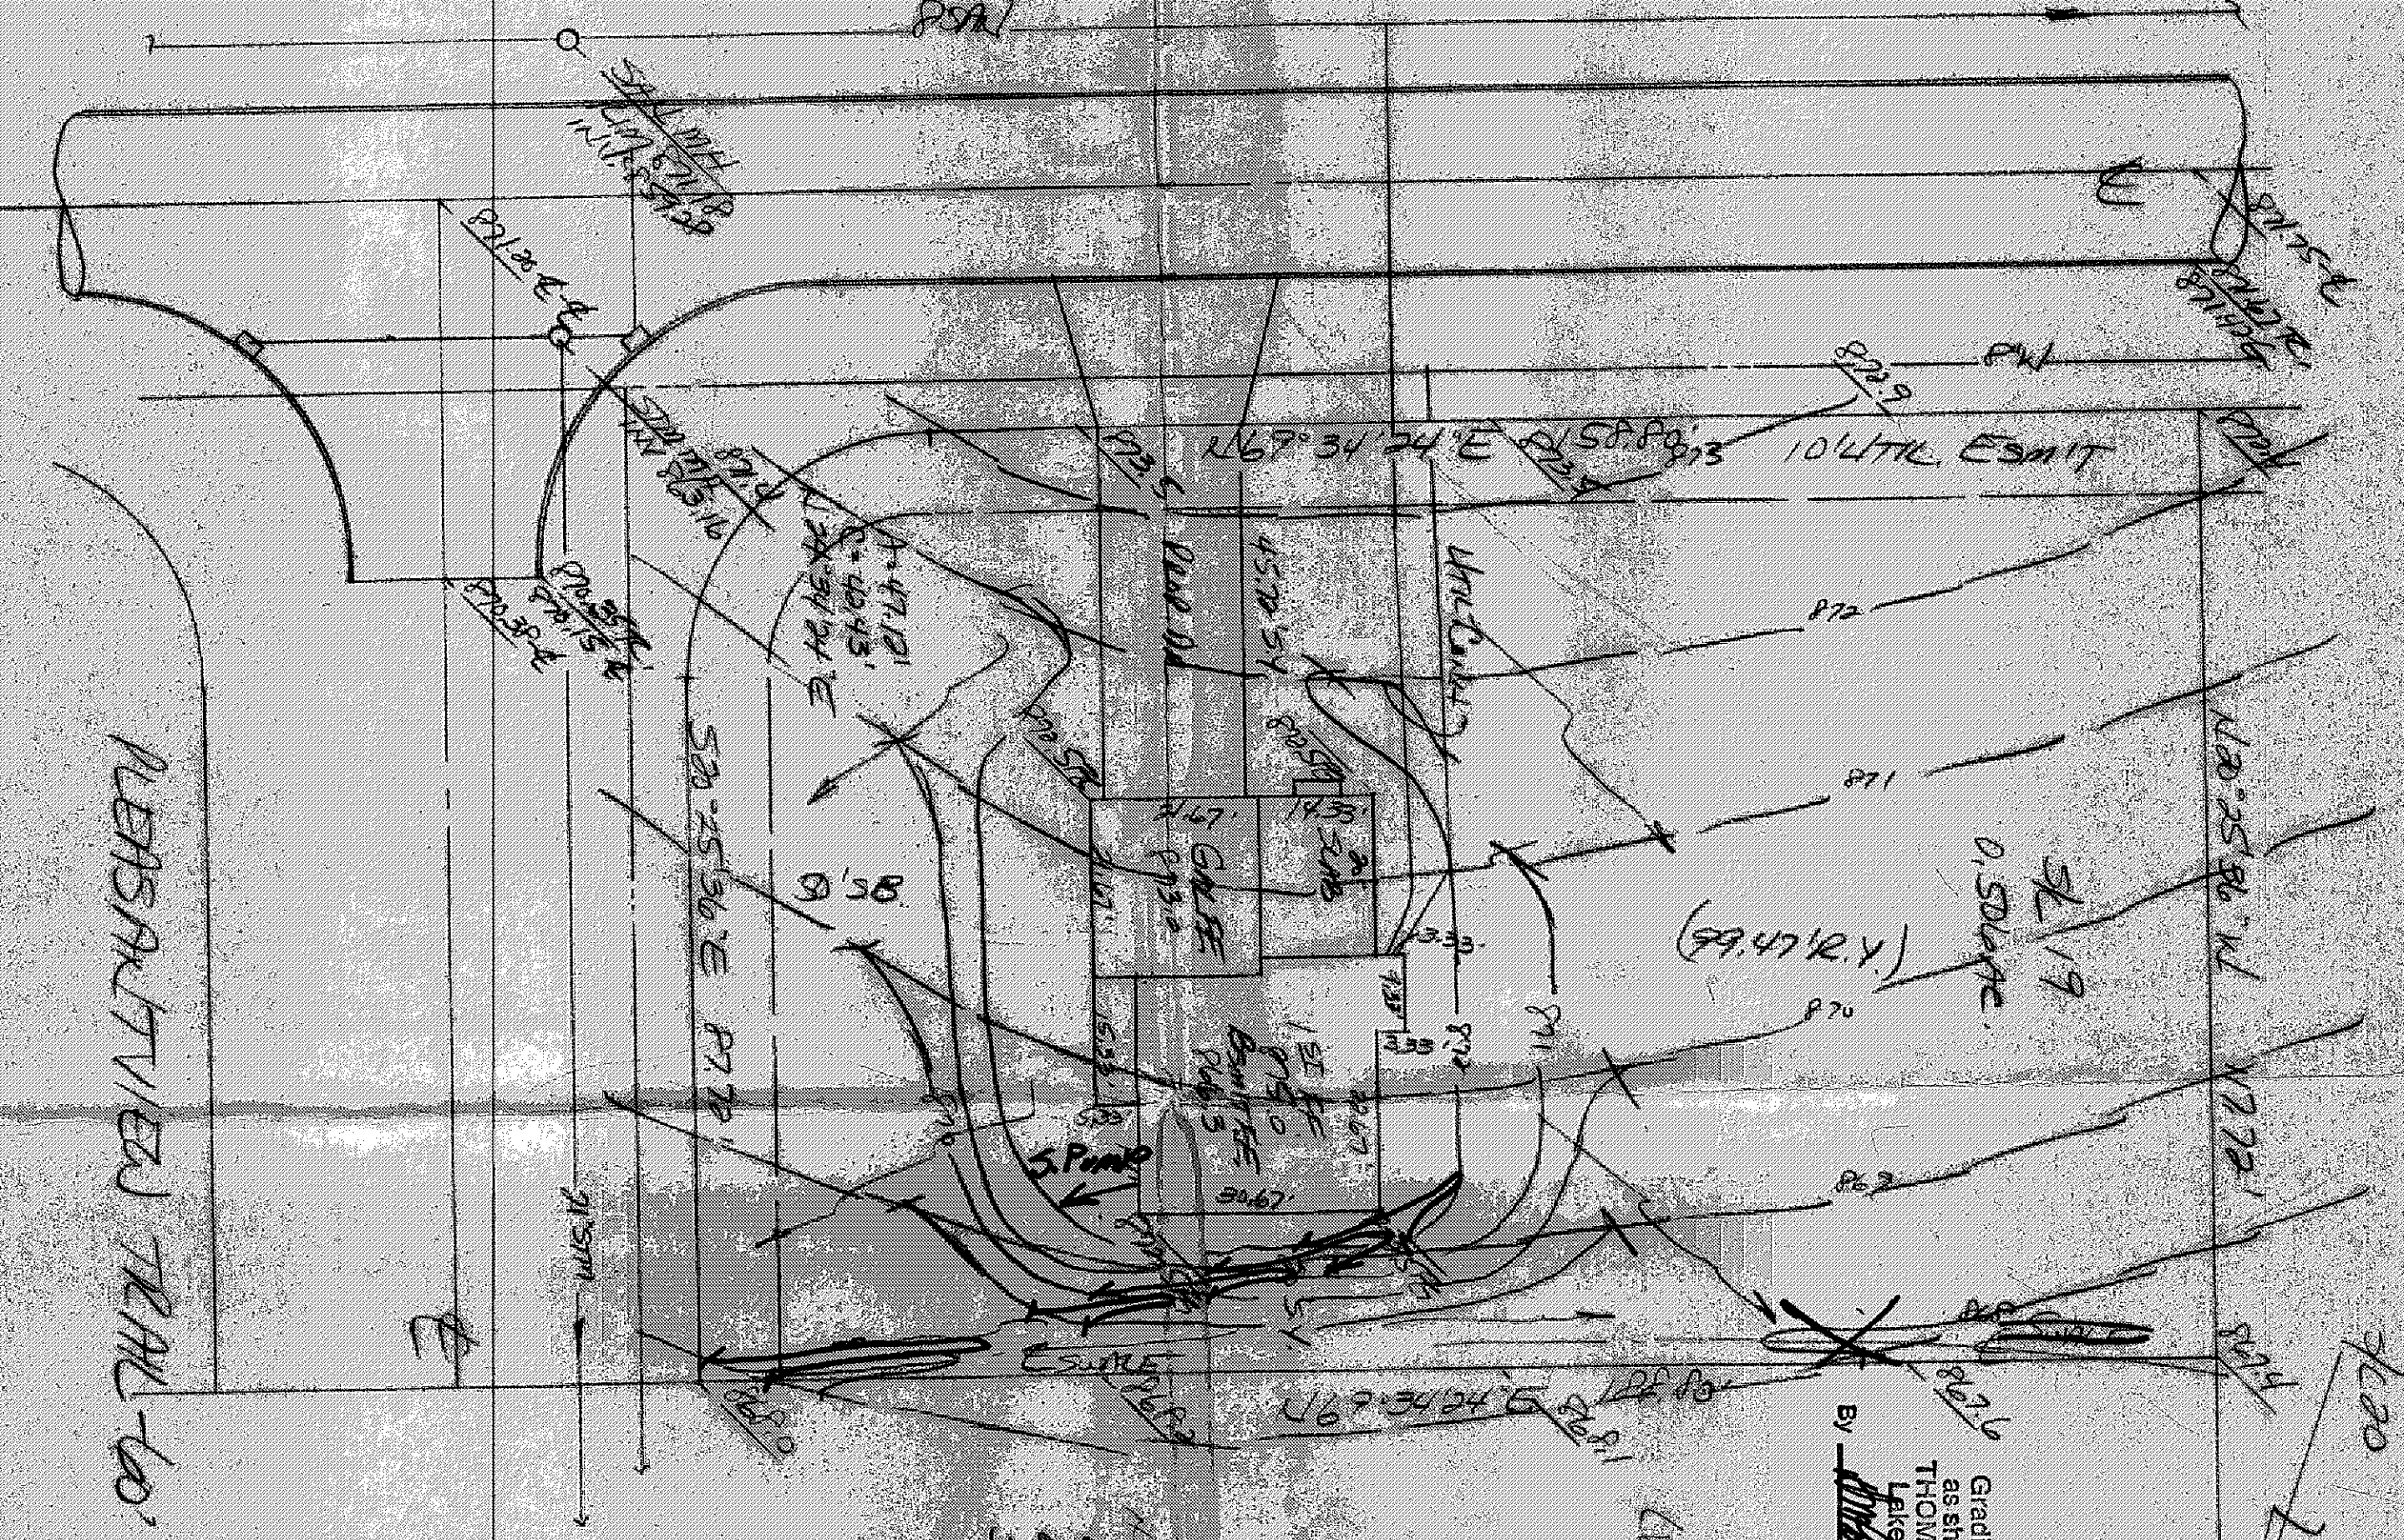

Grading Plan Approved as shown and/or noted
THOMAS P. GILLES, P.E.
Lake County Engineer
By: [Signature] Date: 1/1/89

NOTE: Sewer Pump Discharge & Downspouts to Surface to be determined by owner.

"AS BUILT" CERTIFICATION
I, HEREBY CERTIFY THAT THE CIRCLED GRADES ARE EXISTING FINISH GRADES CHECKED IN THE FIELD ON 1/1/89 AND ARE CORRECT TO THE BEST OF MY KNOWLEDGE AND BELIEF.

REGISTERED SURVEYOR REG. NO.

7801 - Long Sand M.H.

CR. 11 - PM. 18

Grading # 6044