



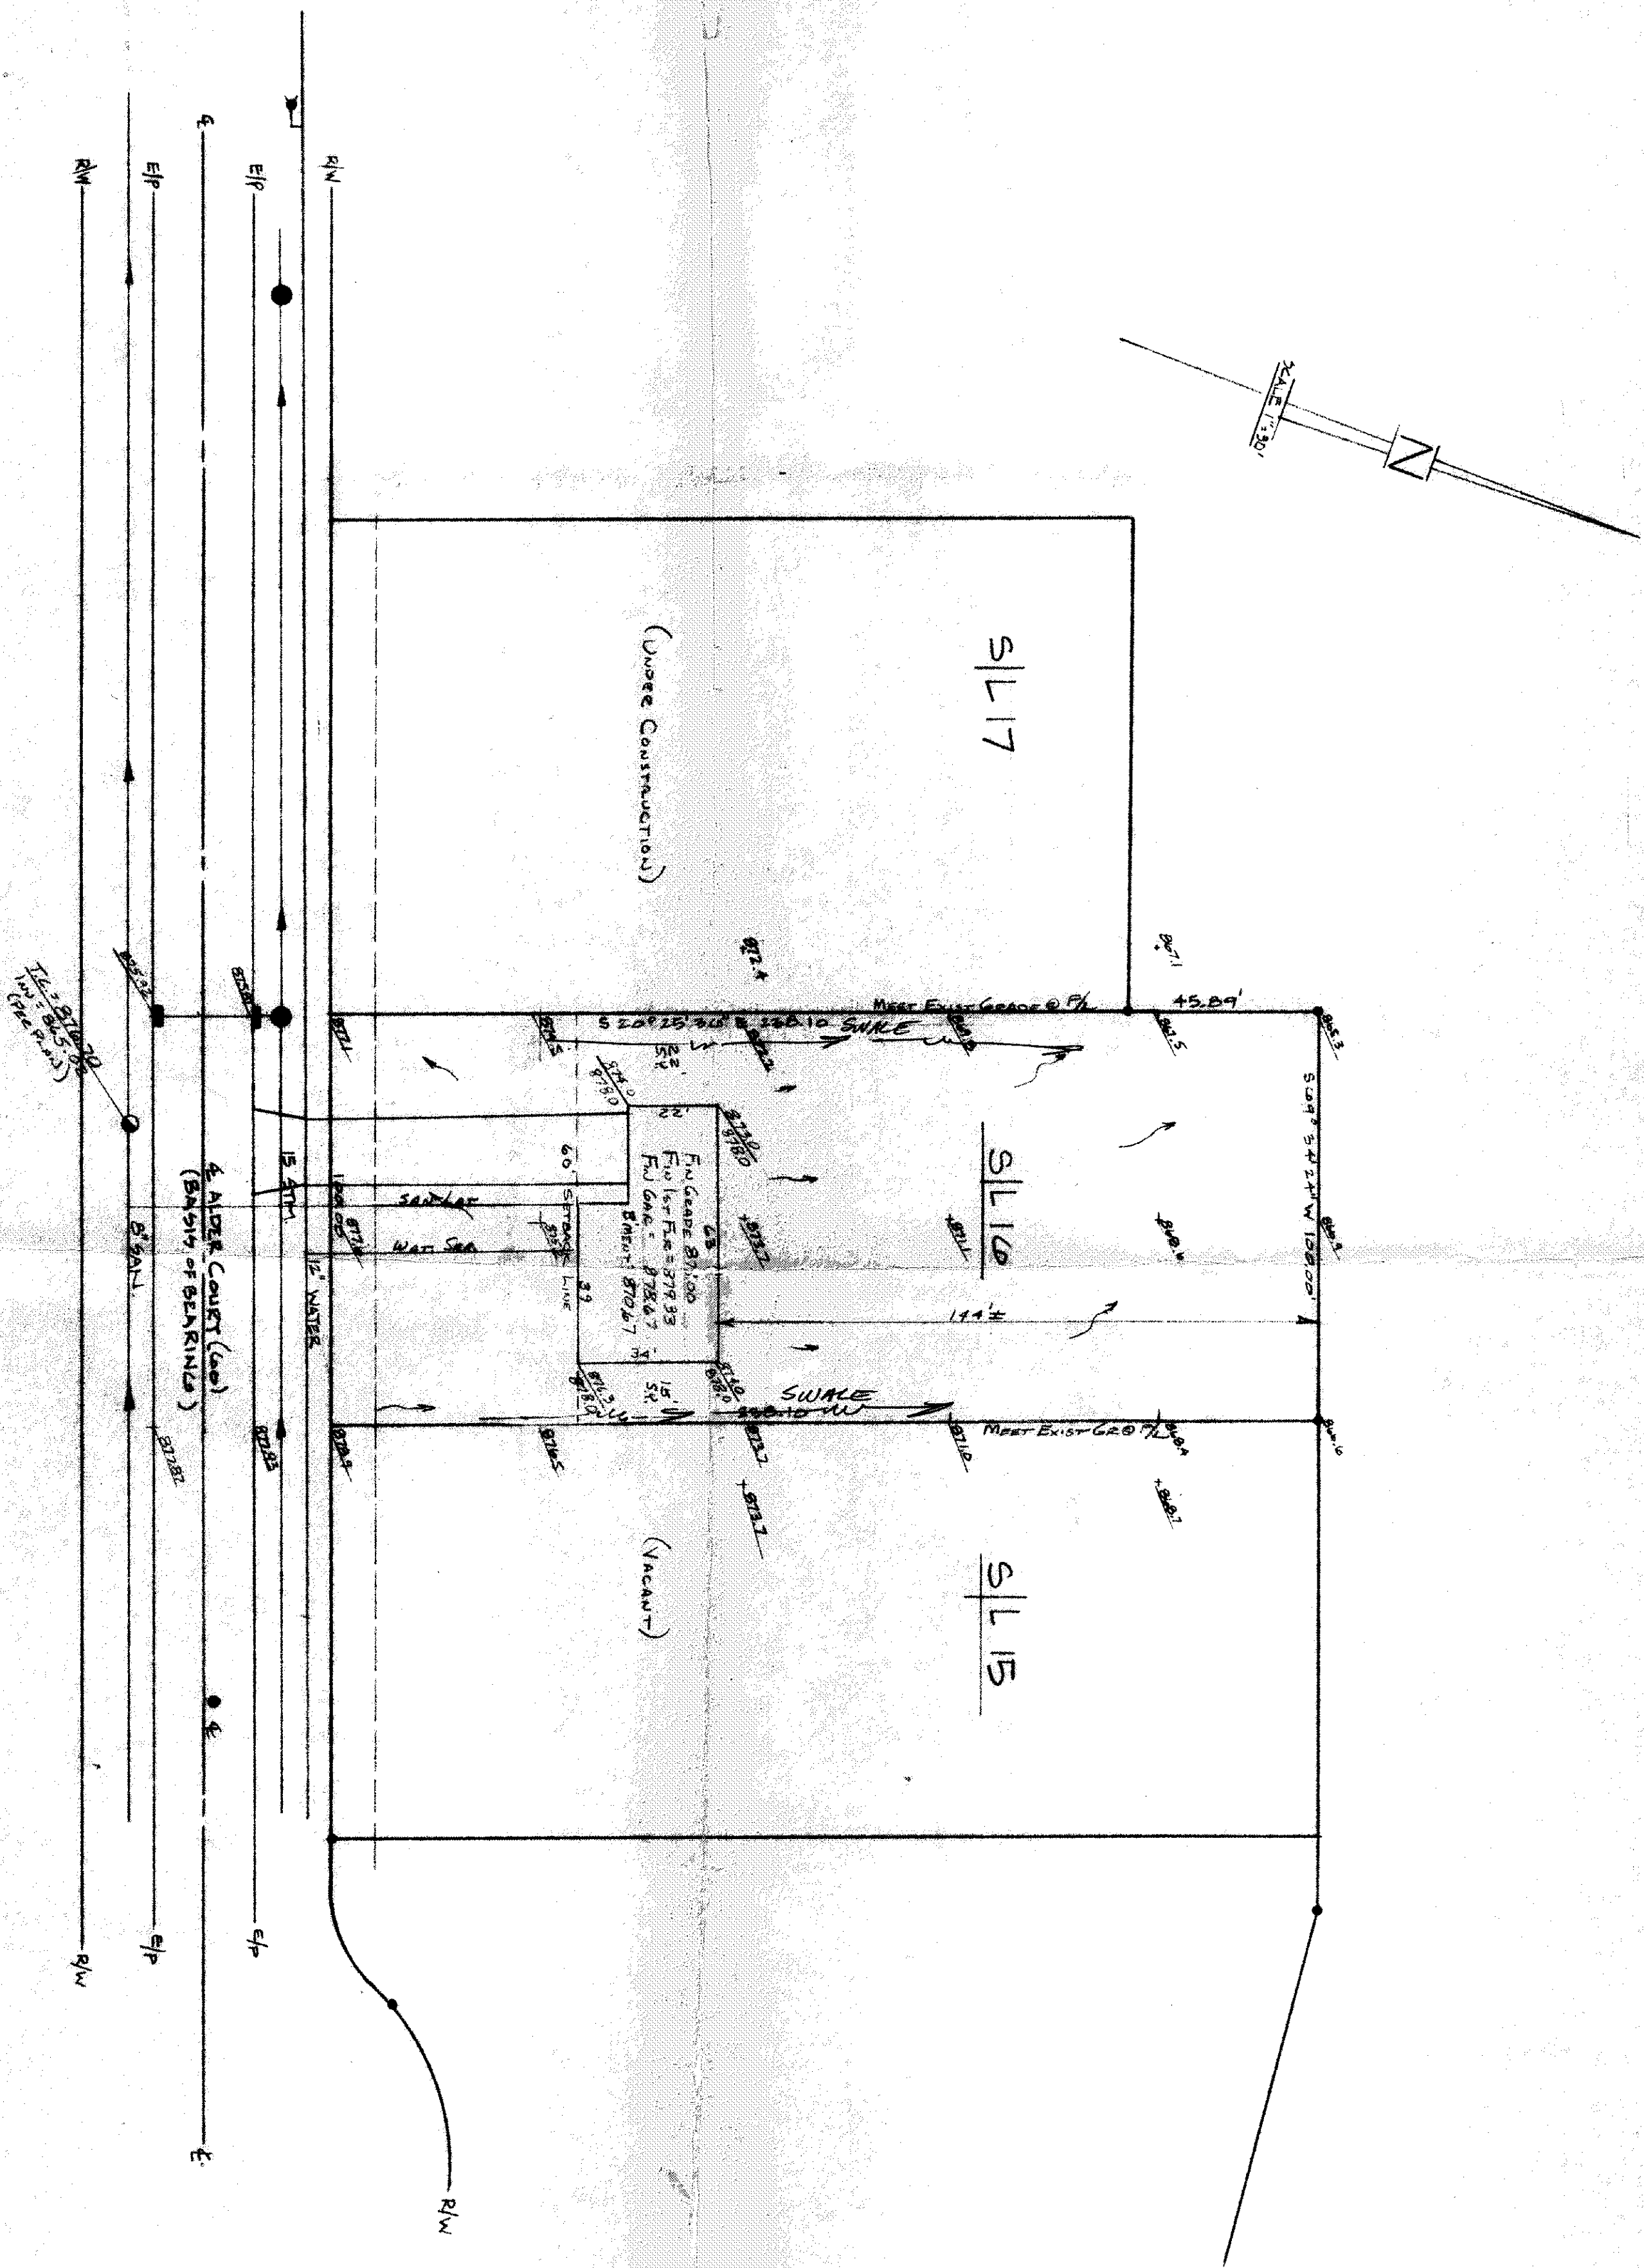

Grading Plan Approved
as shown and/or noted
THOMAS P. GILLES, P.E.
Lake County Engineer
By *[Signature]* Date 11/21/88
Elevated from 11/19/88

ZONING PERMIT # 6030
ISSUED 11-18-88
SUBJECT TO APPROVAL BY:
Lake County Engineer ☒
Lake County Eng. Dept. ☒
Lake County Planning Comm. ☐
Lake County Bldg. Dept. ☒

Leno R. Marano

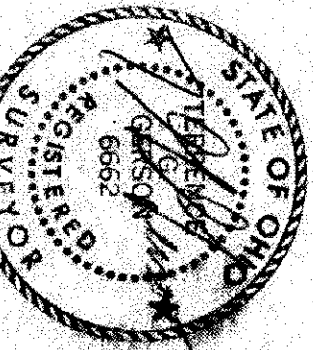


0.00' EXIST. ELEV.
+0.00' FROM ELEV.

CLIFF SHANDLER - SHANDLER CONST. CO. 8353 MENTOR AVE MENTOR, OHIO 44060	TITLE SITE PLAN SL16 MORLEY HILLS ESTATES #4A	DATE 16 Nov 88	DRAWN BY G.G./TGG	CHECKED BY S.D.S.
---	---	-------------------	----------------------	----------------------



WILLIAM R. GRAY ASSOCIATES, INC.
7519 MENTOR AVENUE MENTOR, OHIO 44060 946-1616

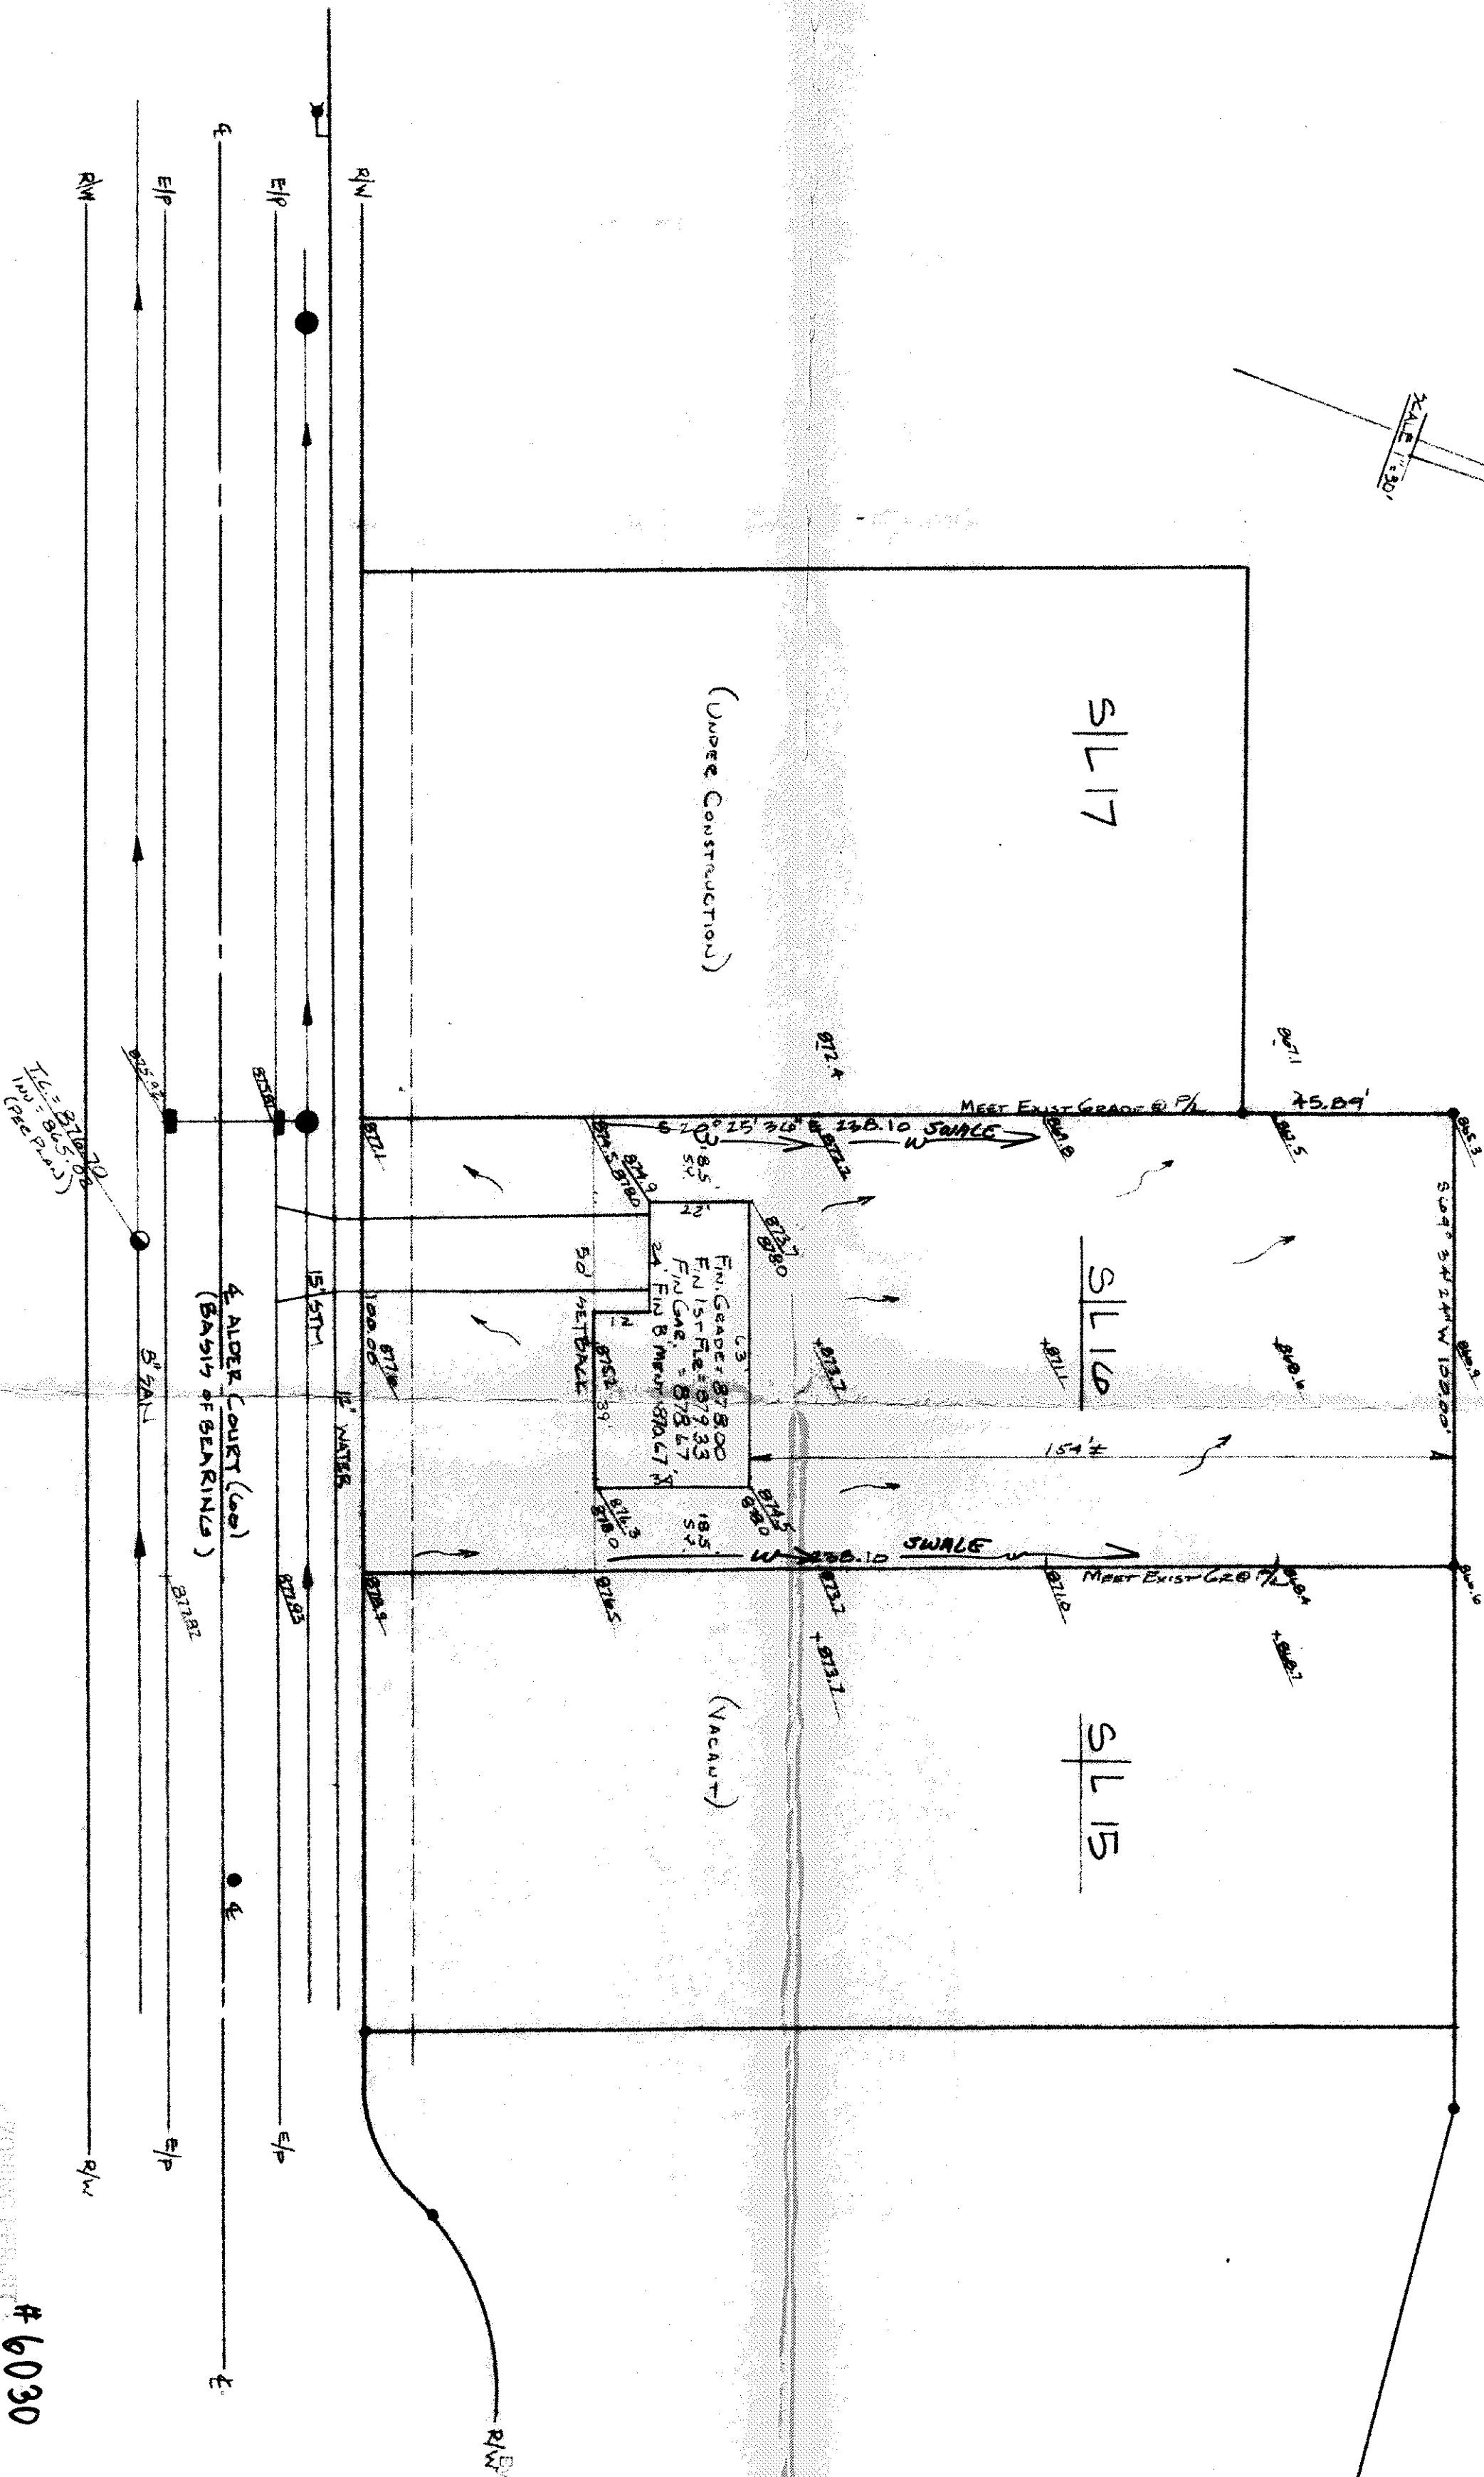

ZONING PERMIT #6030
 11-18-88
 ISSUED
 CLIFF SHANDLE - SHANDLE CONST. CO.
 8353 MENTOR AVE
 MENTOR, OHIO 44060



Grading Plan Approved
 as shown and/or noted
 THOMAS J. MOORE, P.E.
 Lake County Engineer
 Date 11/18/88

CLIFF SHANDLE - SHANDLE CONST. CO. 8353 MENTOR AVE MENTOR, OHIO 44060	TITLE SITE PLAN S/L 16 MORLEY HILLS ESTATES #A
DATE 16 Nov 88	DRAWN BY G.G./TGG



WILLIAM R. GRAY ASSOCIATES, INC.
 7519 MENTOR AVENUE MENTOR, OHIO 44060 946-1616