


5 I. PIN MON

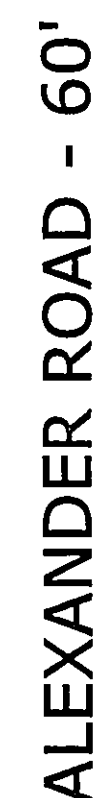

REVIEWED AND ACCEPTED
LAXE COUNTY GENERAL
HEALTH DISTRICT

Date 7-15-4 BY DAW

SEWAGE DISPOSAL PERMIT MUST BE
OBTAINED BY A LAXE COUNTY LICENSED
INSTALLER BEFORE INSTALLATION IS
STARTED




TBM - TOP OF FIRE HYDRANT
ELEV-833.67

STORM WATER DISCHARGEMENT PLAN
Approved as shown
JAMES R. GILLS, P.E.
County Drainage Engineer
By: 6/11 Date: 7/1/04

12" Min
Culvert
Shall be
Shall
ROOF DRAIN
SHALL DISCHARGE
TO SPLASH BLOCK.

STATE OF OHIO
HARRY S. JONES, JR.
P.E. 6343
PROFESSIONAL SURVEYOR
#14194

EXISTING UTILITIES NOTE:
THE SIZE AND LOCATION, BOTH HORIZONTAL AND VERTICAL
OF THE UNDERGROUND UTILITIES SHOWN HEREON, HAVE BEEN
OBTAINED BY A SEARCH OF AVAILABLE RECORDS.
VERIFICATION BY FIELD OBSERVATION HAS BEEN CONDUCTED
WHERE PRACTICAL, HOWEVER, BABCOCK, JONES AND ASSOCI-
INC. DOES NOT GUARANTEE THE COMPLETENESS NOR ACCURA-
THEREOF.

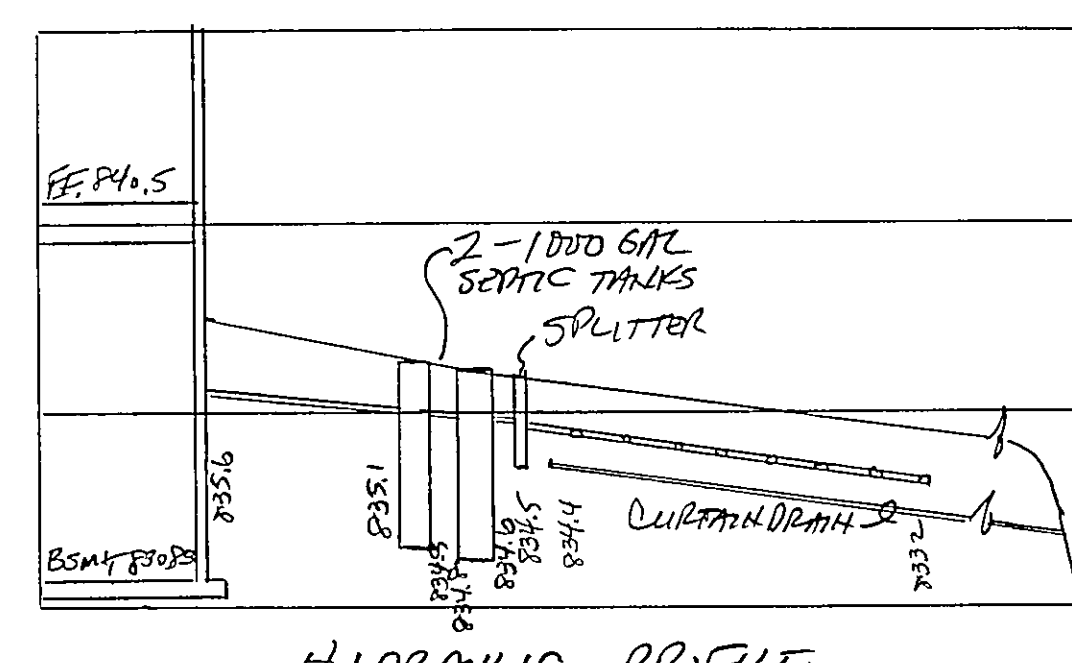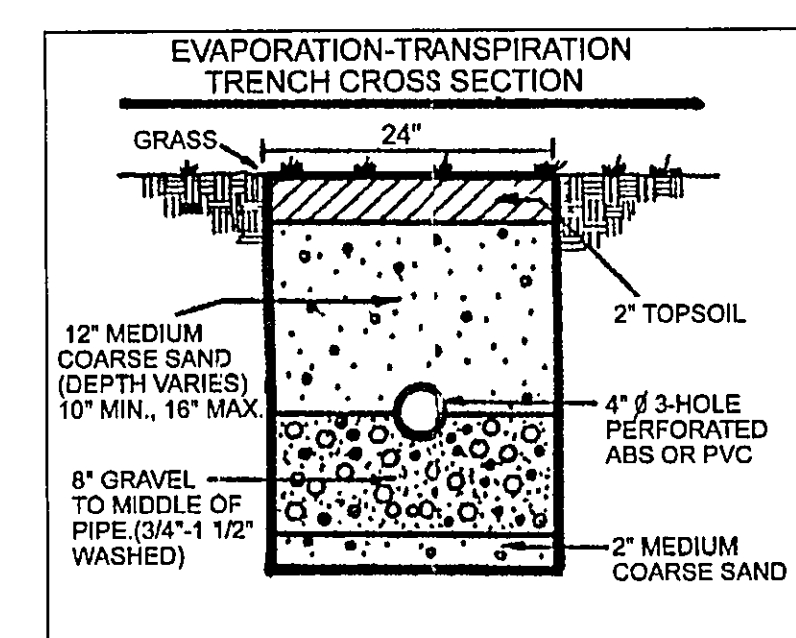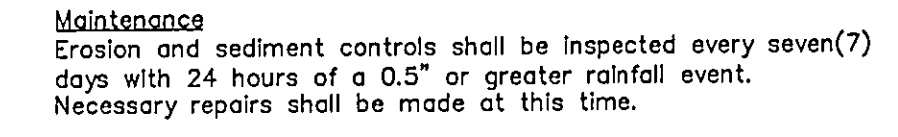

HYDRAULIC PROFILE

SCALE	1"=30'	
JOB NO	89-034-26	
SHEET	/	OF
1		1