



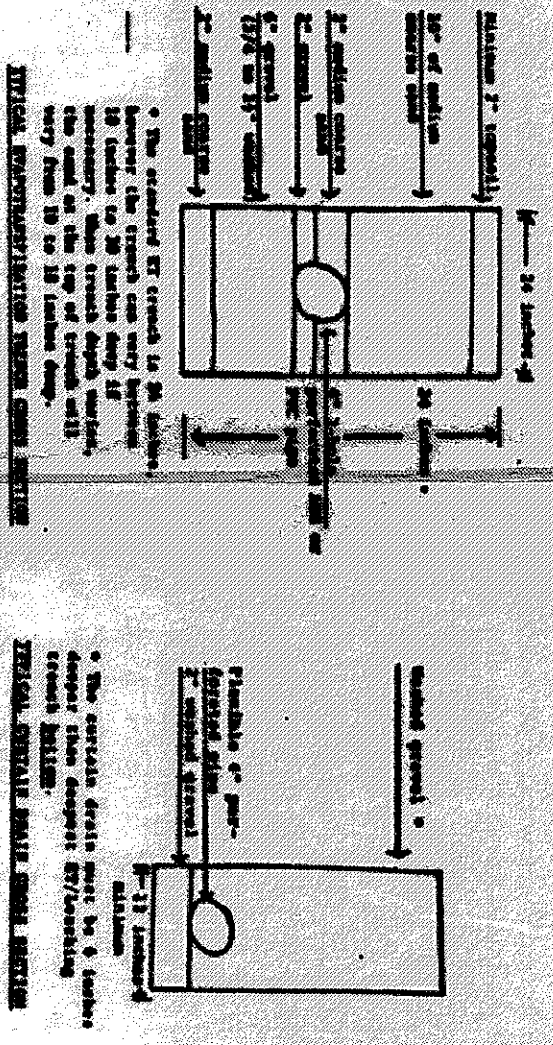

HYDRAULIC PROFILE

SCALE: HORIZ. 1" = 30' VERT. 1" = 5'

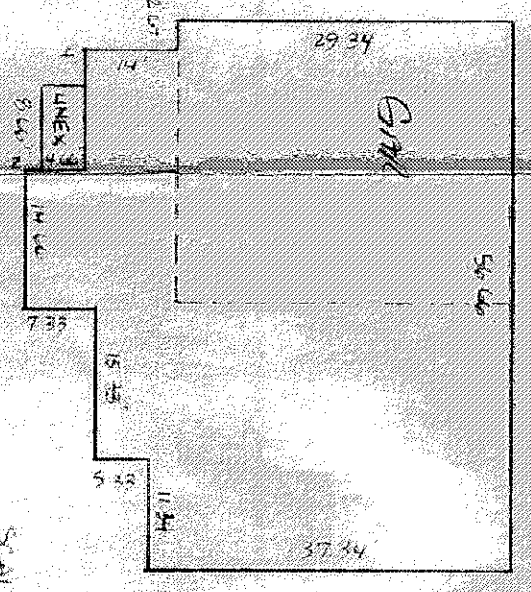

LOW YIELD WATER FIXTURES REQUIRED ON ALL: Shower Head Toilet

Reviewed and Accepted
LAKE COUNTY GENERAL HEALTH DISTRICT
Date: 7-11-90
JOEL LUCKA, R. S., M. P. H.
Health Commissioner



Grading Plan Approved as shown and/or noted
THOMAS P. GILLES, P.E.
Lake County Engineer
Date: 11/16/90
See ATTACHED NOTE

ZONING PERMIT #6499
ISSUED 6-18-90

Tom J. Marano

I, the undersigned hereby certify that this topography indicated by 6" 1" or 2" contours, and elevations shown thereon represent an actual field survey made by me on the day of 11/16/90, and that the elevations were taken at appropriate intervals and that as of that date they extend as indicated hereon.

Harry S. Jones, Jr.
#6343
Eng. No.

SITE PLAN
CARRY SWIVETER

REV. NO.	DESCRIPTION	DATE	BY	CHK'D

SITE PLAN
PAGE

babcock, jones and associates, inc.
CIVIL ENGINEERS - SURVEYORS - LAND PLANNERS
PAINESVILLE OHIO 44077

DATE	DESIGN BY	DRAWN BY	APPROVED BY
6-12-90	HT	R	HT

CONCORD TOWNSHIP, LAKE COUNTY
LEDGEWOOD CROSSING AT THE FALLS SUB
9/4 1 ALEXANDER ROAD

SCALE	JOE NO. 69-034-01	SHEET
1" = 50'	1	1