


TBCURB = 818.45
GUT = 818.09
INV. N.= 813.64
INV. S.= 813.62

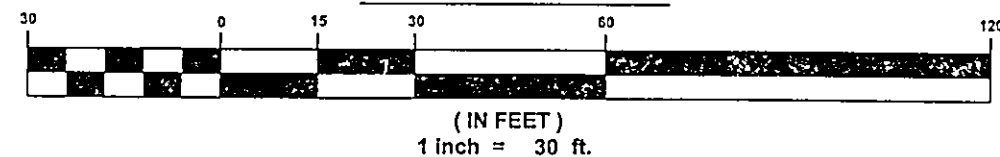

CERT 1246G
 Submitted for Management Plan
 Approval as shown and/or noted
 JAMES R. GILLIS, P.E.
 County Drainage Engineer
 By WJH Date 7/19/04

M. B. HOMES

DRAWN
WSO
CHECKED
OWN
DATE
JUNE 24, 2004
SCALE
1" = 30'
JOB NO
03040-15
SHEET
1/2