


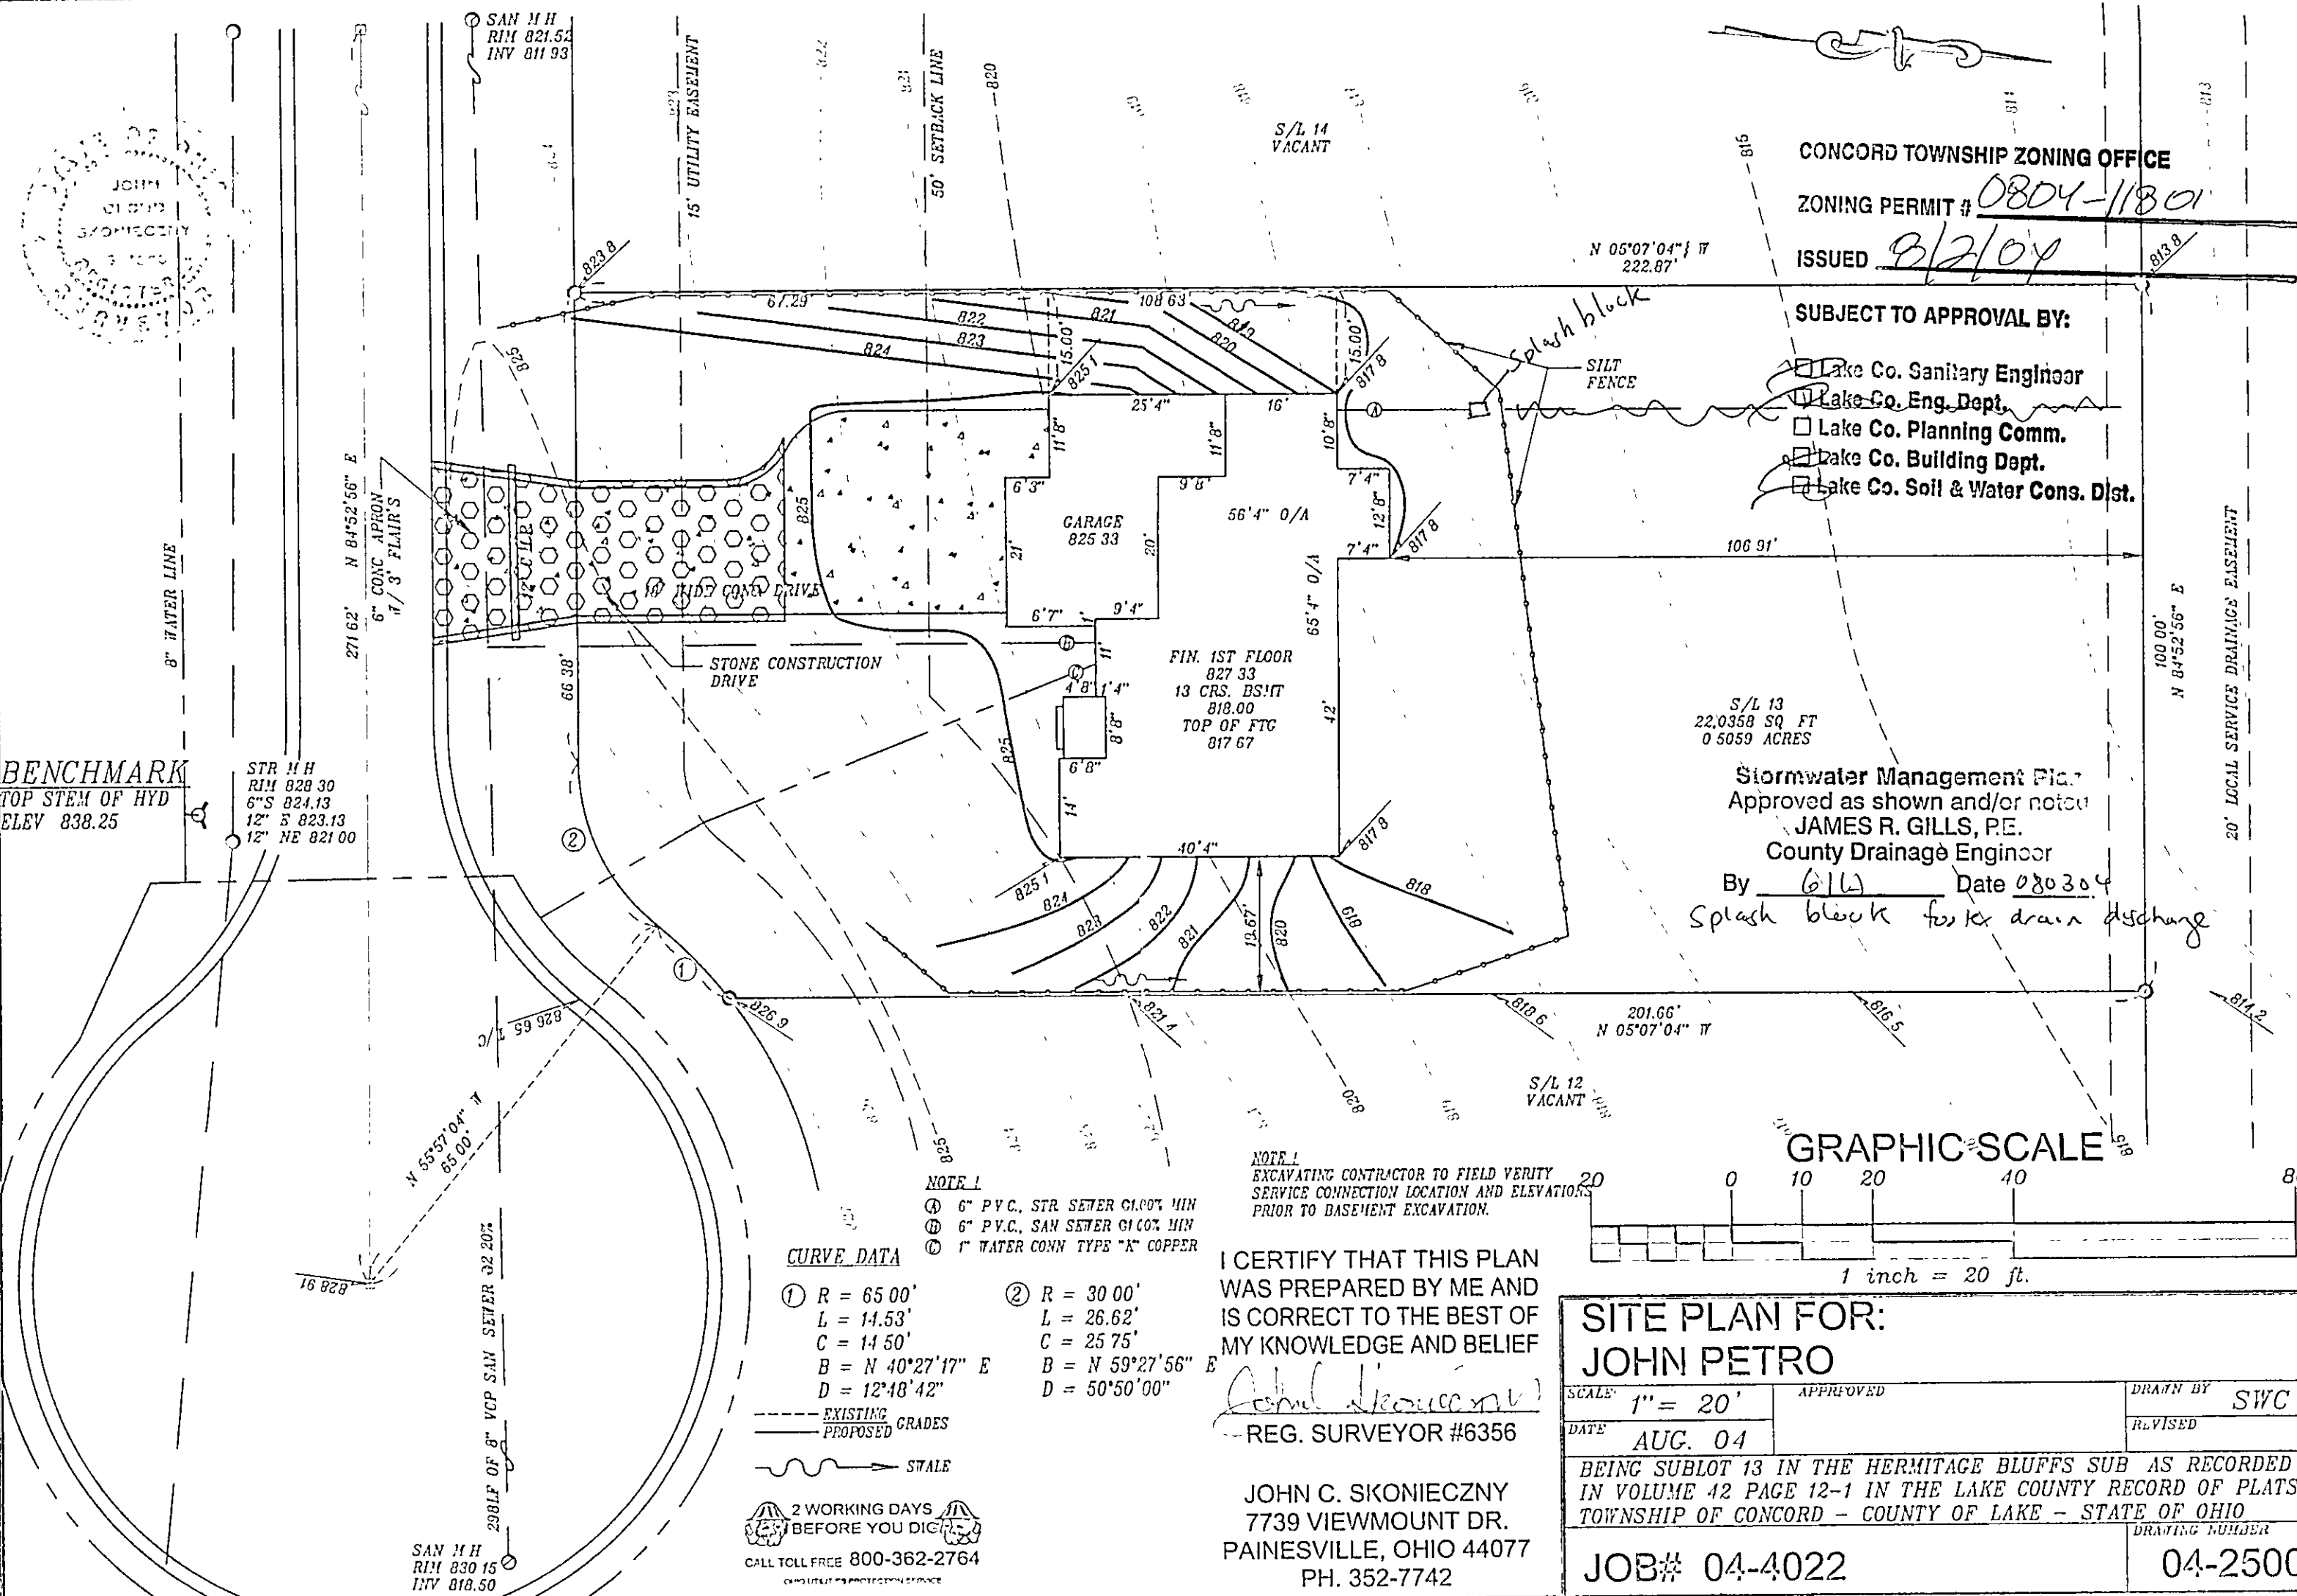

CONCORD TOWNSHIP ZONING OFFICE

ZONING PERMIT # 0804-11801

ISSUED 8/2/04


SUBJECT TO APPROVAL BY:

- ☐ Lake Co. Sanitary Engineer
- ☐ Lake Co. Eng. Dept.
- ☐ Lake Co. Planning Comm.
- ☐ Lake Co. Building Dept.
- ☐ Lake Co. Soil & Water Cons. Dist.

Stormwater Management Plan
Approved as shown and/or noted
JAMES R. GILLS, P.E.
County Drainage Engineer
By GL Date 080304

Splash block for drain discharge

GRAPHIC SCALE

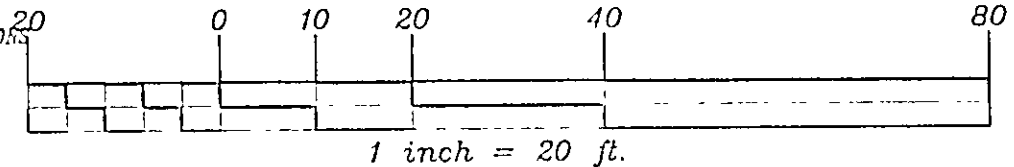

SITE PLAN FOR:
JOHN PETRO

SCALE: 1" = 20'	APPROVED	DRAWN BY: SWC
DATE: AUG. 04		REVISED
BEING SUBLOT 13 IN THE HERMITAGE BLUFFS SUB AS RECORDED IN VOLUME 42 PAGE 12-1 IN THE LAKE COUNTY RECORD OF PLATS TOWNSHIP OF CONCORD - COUNTY OF LAKE - STATE OF OHIO		
JOB# 04-4022		DRAWING NUMBER 04-2500

NOTE 1

- ① 6" P.V.C., STR. SEWER @ 1.00% MIN
- ② 6" P.V.C., SAN SEWER @ 1.00% MIN
- ③ 1" WATER CONN TYPE "K" COPPER

CURVE DATA

- ① R = 65.00'
L = 14.53'
C = 14.50'
B = N 40°27'17" E
D = 12°48'42"
- ② R = 30.00'
L = 26.62'
C = 25.75'
B = N 59°27'56" E
D = 50°50'00"

EXISTING GRADES
PROPOSED GRADES
SCALE

2 WORKING DAYS
BEFORE YOU DIG
CALL TOLL FREE 800-362-2764

NOTE 1

EXCAVATING CONTRACTOR TO FIELD VERIFY SERVICE CONNECTION LOCATION AND ELEVATIONS PRIOR TO BASEMENT EXCAVATION.

I CERTIFY THAT THIS PLAN WAS PREPARED BY ME AND IS CORRECT TO THE BEST OF MY KNOWLEDGE AND BELIEF

John Skonieczny
REG. SURVEYOR #6356

JOHN C. SKONIECZNY
7739 VIEWMOUNT DR.
PAINESVILLE, OHIO 44077
PH. 352-7742