


LITTLE MOUNTAIN PARK ESTATES  
NO. 4 SUBDIVISION

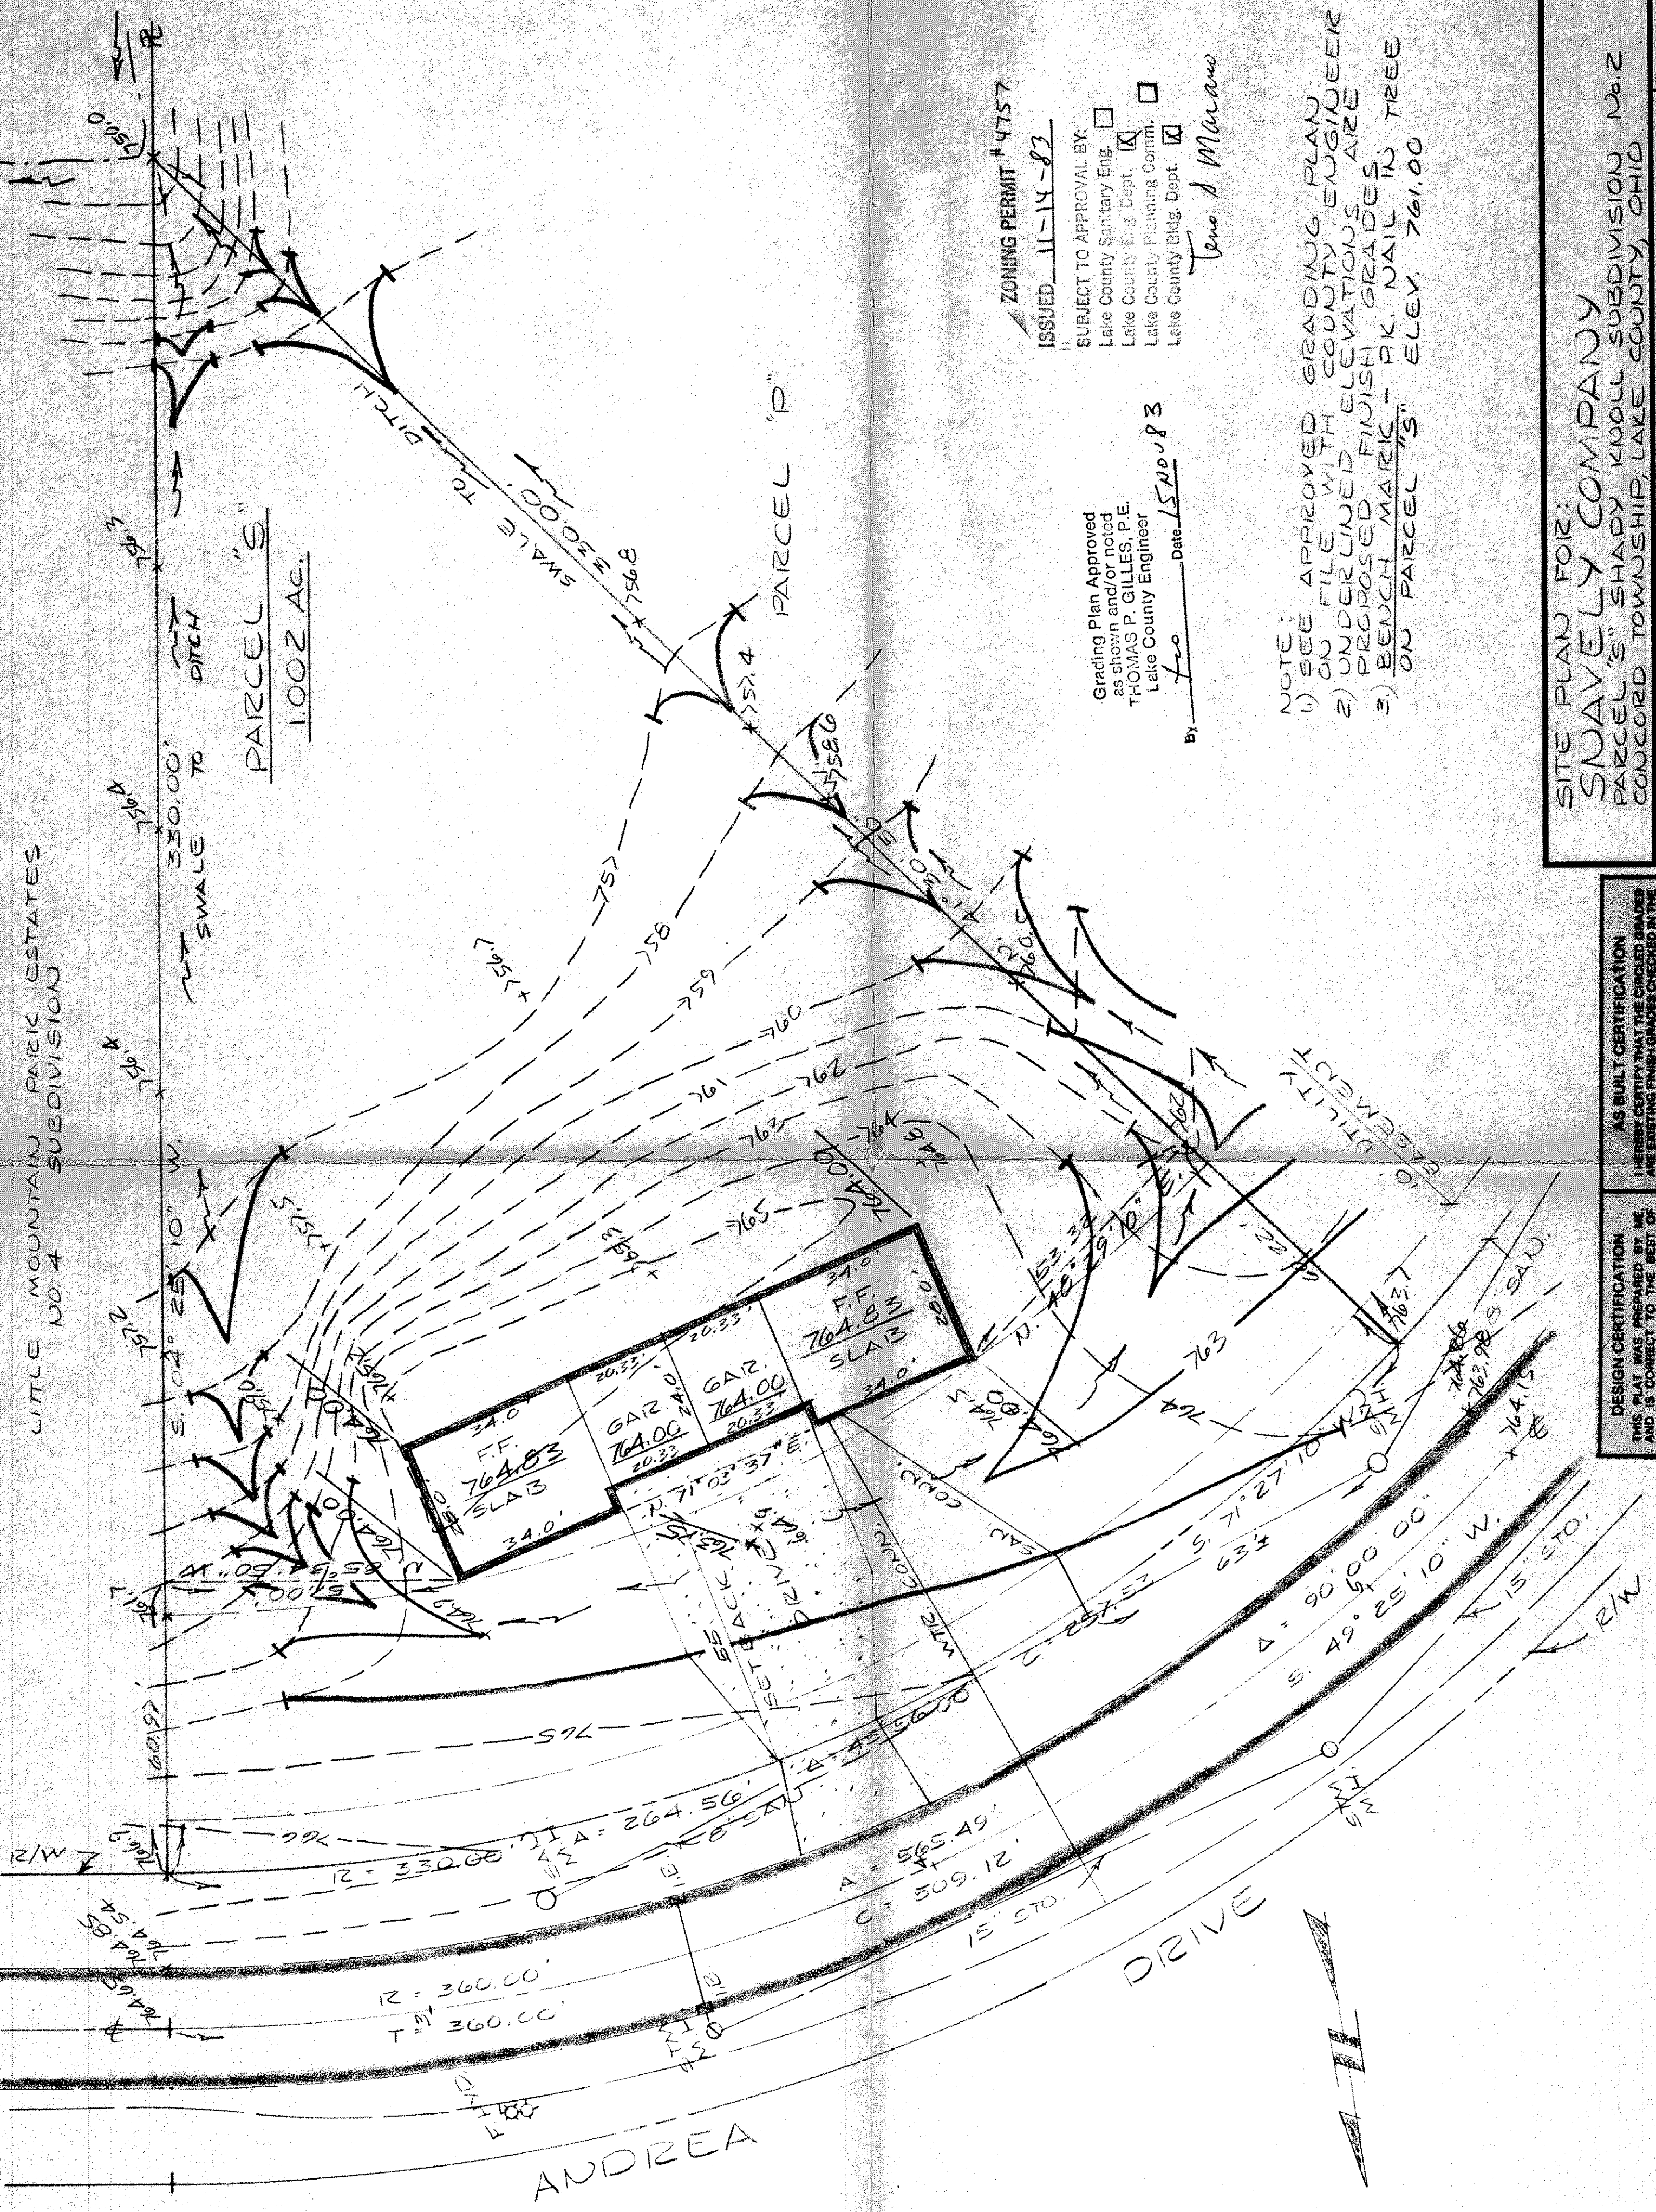

ZONING PERMIT #4757

ISSUED 11-14-83

SUBJECT TO APPROVAL BY:

- ☐ Lake County Sanitary Eng.
- ☒ Lake County Eng. Dept.
- ☐ Lake County Planning Comm.
- ☒ Lake County Bldg. Dept.

Grading Plan Approved  
as shown and/or noted  
THOMAS P. GILLES, P.E.  
Lake County Engineer

By Two Date 15 Nov 83

Teno & Marano

NOTE:  
1) SEE APPROVED GRADING PLAN  
ON FILE WITH COUNTY ENGINEER  
2) UNDERLINED ELEVATIONS ARE  
PROPOSED FINISH GRADES  
3) BENCH MARK - P.K. NAIL IN TREE  
ON PARCEL 'S' ELEV. 761.00

SITE PLAN FOR:

SWAVELEY COMPANY

PARCEL 'S' SHADY KNOLL SUBDIVISION No. 2

CONCORD TOWNSHIP, LAKE COUNTY, OHIO



**COLPETZER WOODS**  
CONSULTANTS, INC.  
MENTOR, OHIO 44060

SHEET 1 OF 1  
CONTRACT NO. 83-520

AS BUILT CERTIFICATION

I HEREBY CERTIFY THAT THE CIRCLED GRADES  
AND EXISTING FINISH GRADES CHECKED IN THE  
FIELD ON 11-14-83 ARE CORRECT TO THE BEST OF MY  
KNOWLEDGE AND BELIEF

DESIGN CERTIFICATION

THIS PLAN WAS PREPARED BY ME  
AND IS CORRECT TO THE BEST OF  
MY KNOWLEDGE AND BELIEF

Thomas P. Gilles  
P.E.  
DATE 11-14-83