


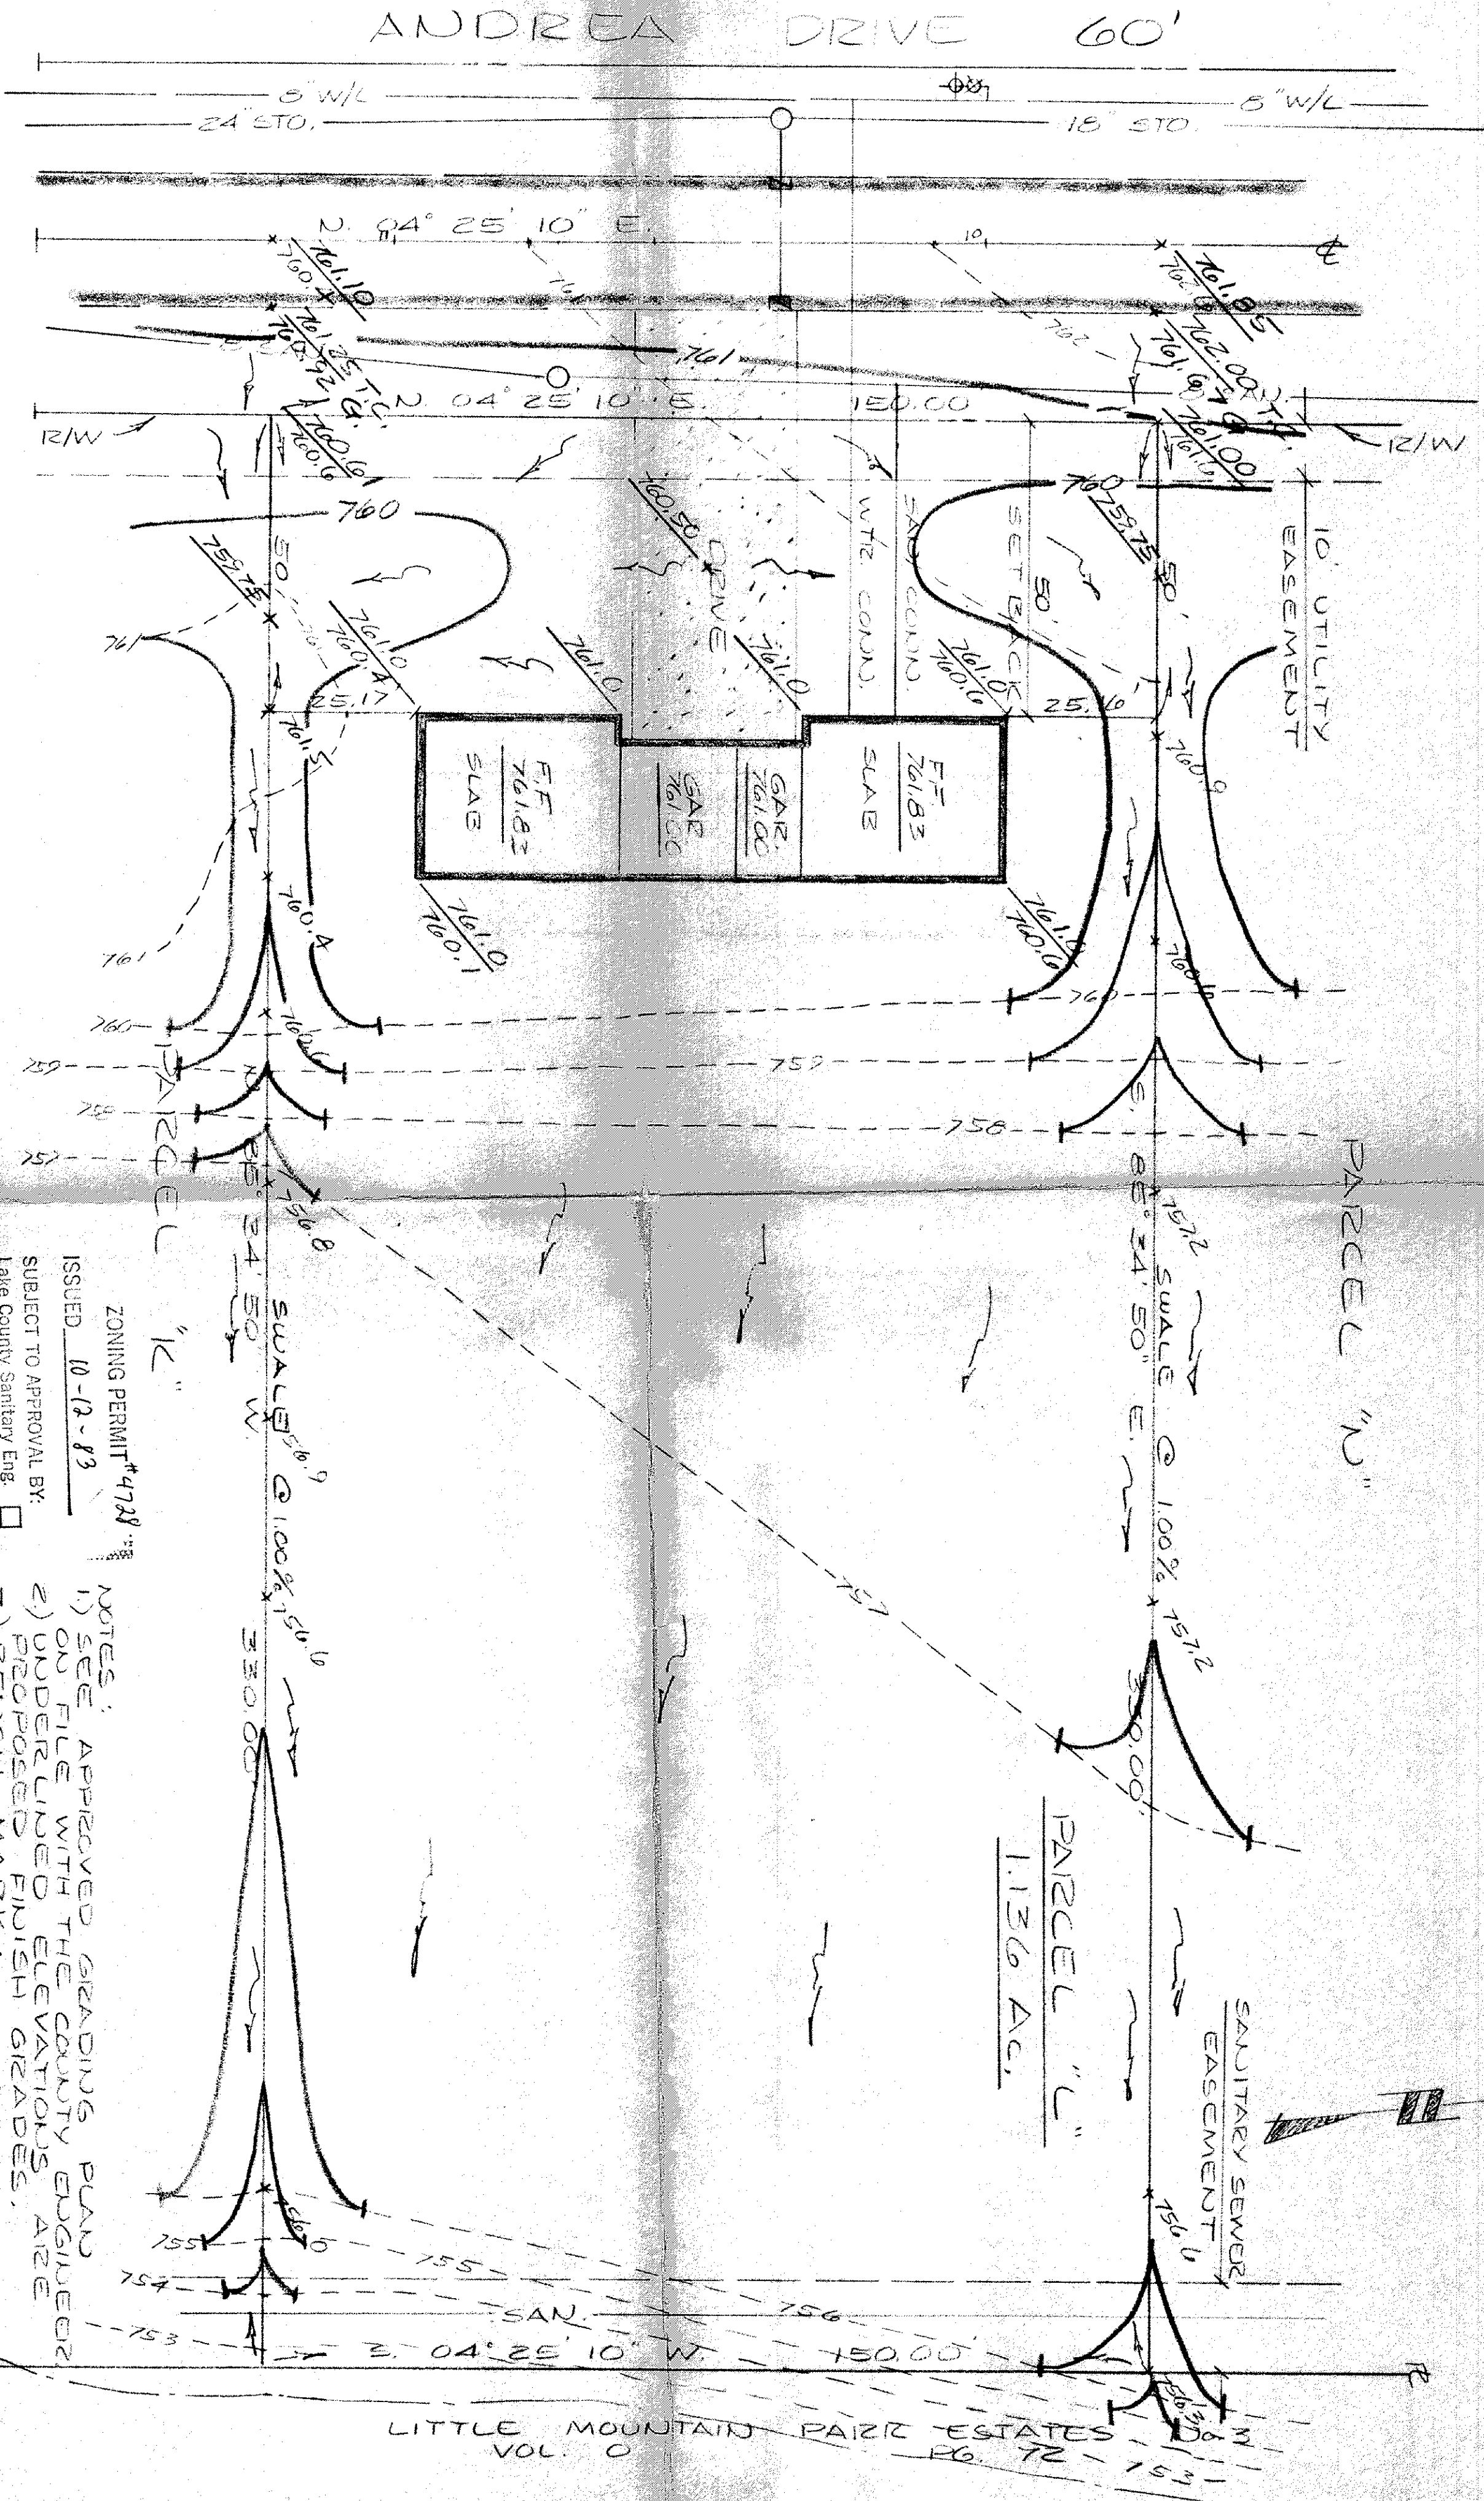

ZONING PERMIT #4781
ISSUED 10-12-83
SUBJECT TO APPROVAL BY:
Lake County Sanitary Eng. ☐
Lake County Eng. Dept. ☒
Lake County Planning Comm. ☐
Lake County Bldg. Dept. ☒
Tune J. Marcano

NOTES:
1) SEE APPROVED GRADING PLAN
ON FILE WITH THE COUNTY ENGINEER
2) UNDERLINED ELEVATIONS ARE
PROPOSED FINISH GRADES.
3) BENCH MARK:
TOP OF F.H.D. SUBURBAN
THOMAS P. GILLES, P.E.
Lake County Engineer

By: Tune J. Marcano Date: 10-12-83

DESIGN CERTIFICATION
THIS PLAN WAS PREPARED BY ME
AND IS CORRECT TO THE BEST OF
MY KNOWLEDGE AND BELIEF.
Mike J. Marcano
AS BUILT CERTIFICATION
I HEREBY CERTIFY THAT THE CIRCLED GRADES
AND ELEVATIONS SHOWN ON THIS PLAN
ARE CORRECT TO THE BEST OF MY
KNOWLEDGE AND BELIEF.
Mike J. Marcano

SITE PLAN FOR:
SHAVELY COMPANY
PARCEL "N" SHADY KNOLL SUBDIVISION AC
CORCORAN TOWNSHIP, LAKE COUNTY, OHIO
DATE: 10-12-83
SCALE: 1" = 20'
DRAWN BY: THOMAS P. GILLES
CHECKED BY: THOMAS P. GILLES
DATE: 10-12-83
SHEET: 1 OF 1
CONTRACT NO. 10-12-83
COLPETZER, WOODS
CONSULTANTS, INC.