


ANDREA DRIVE 60'

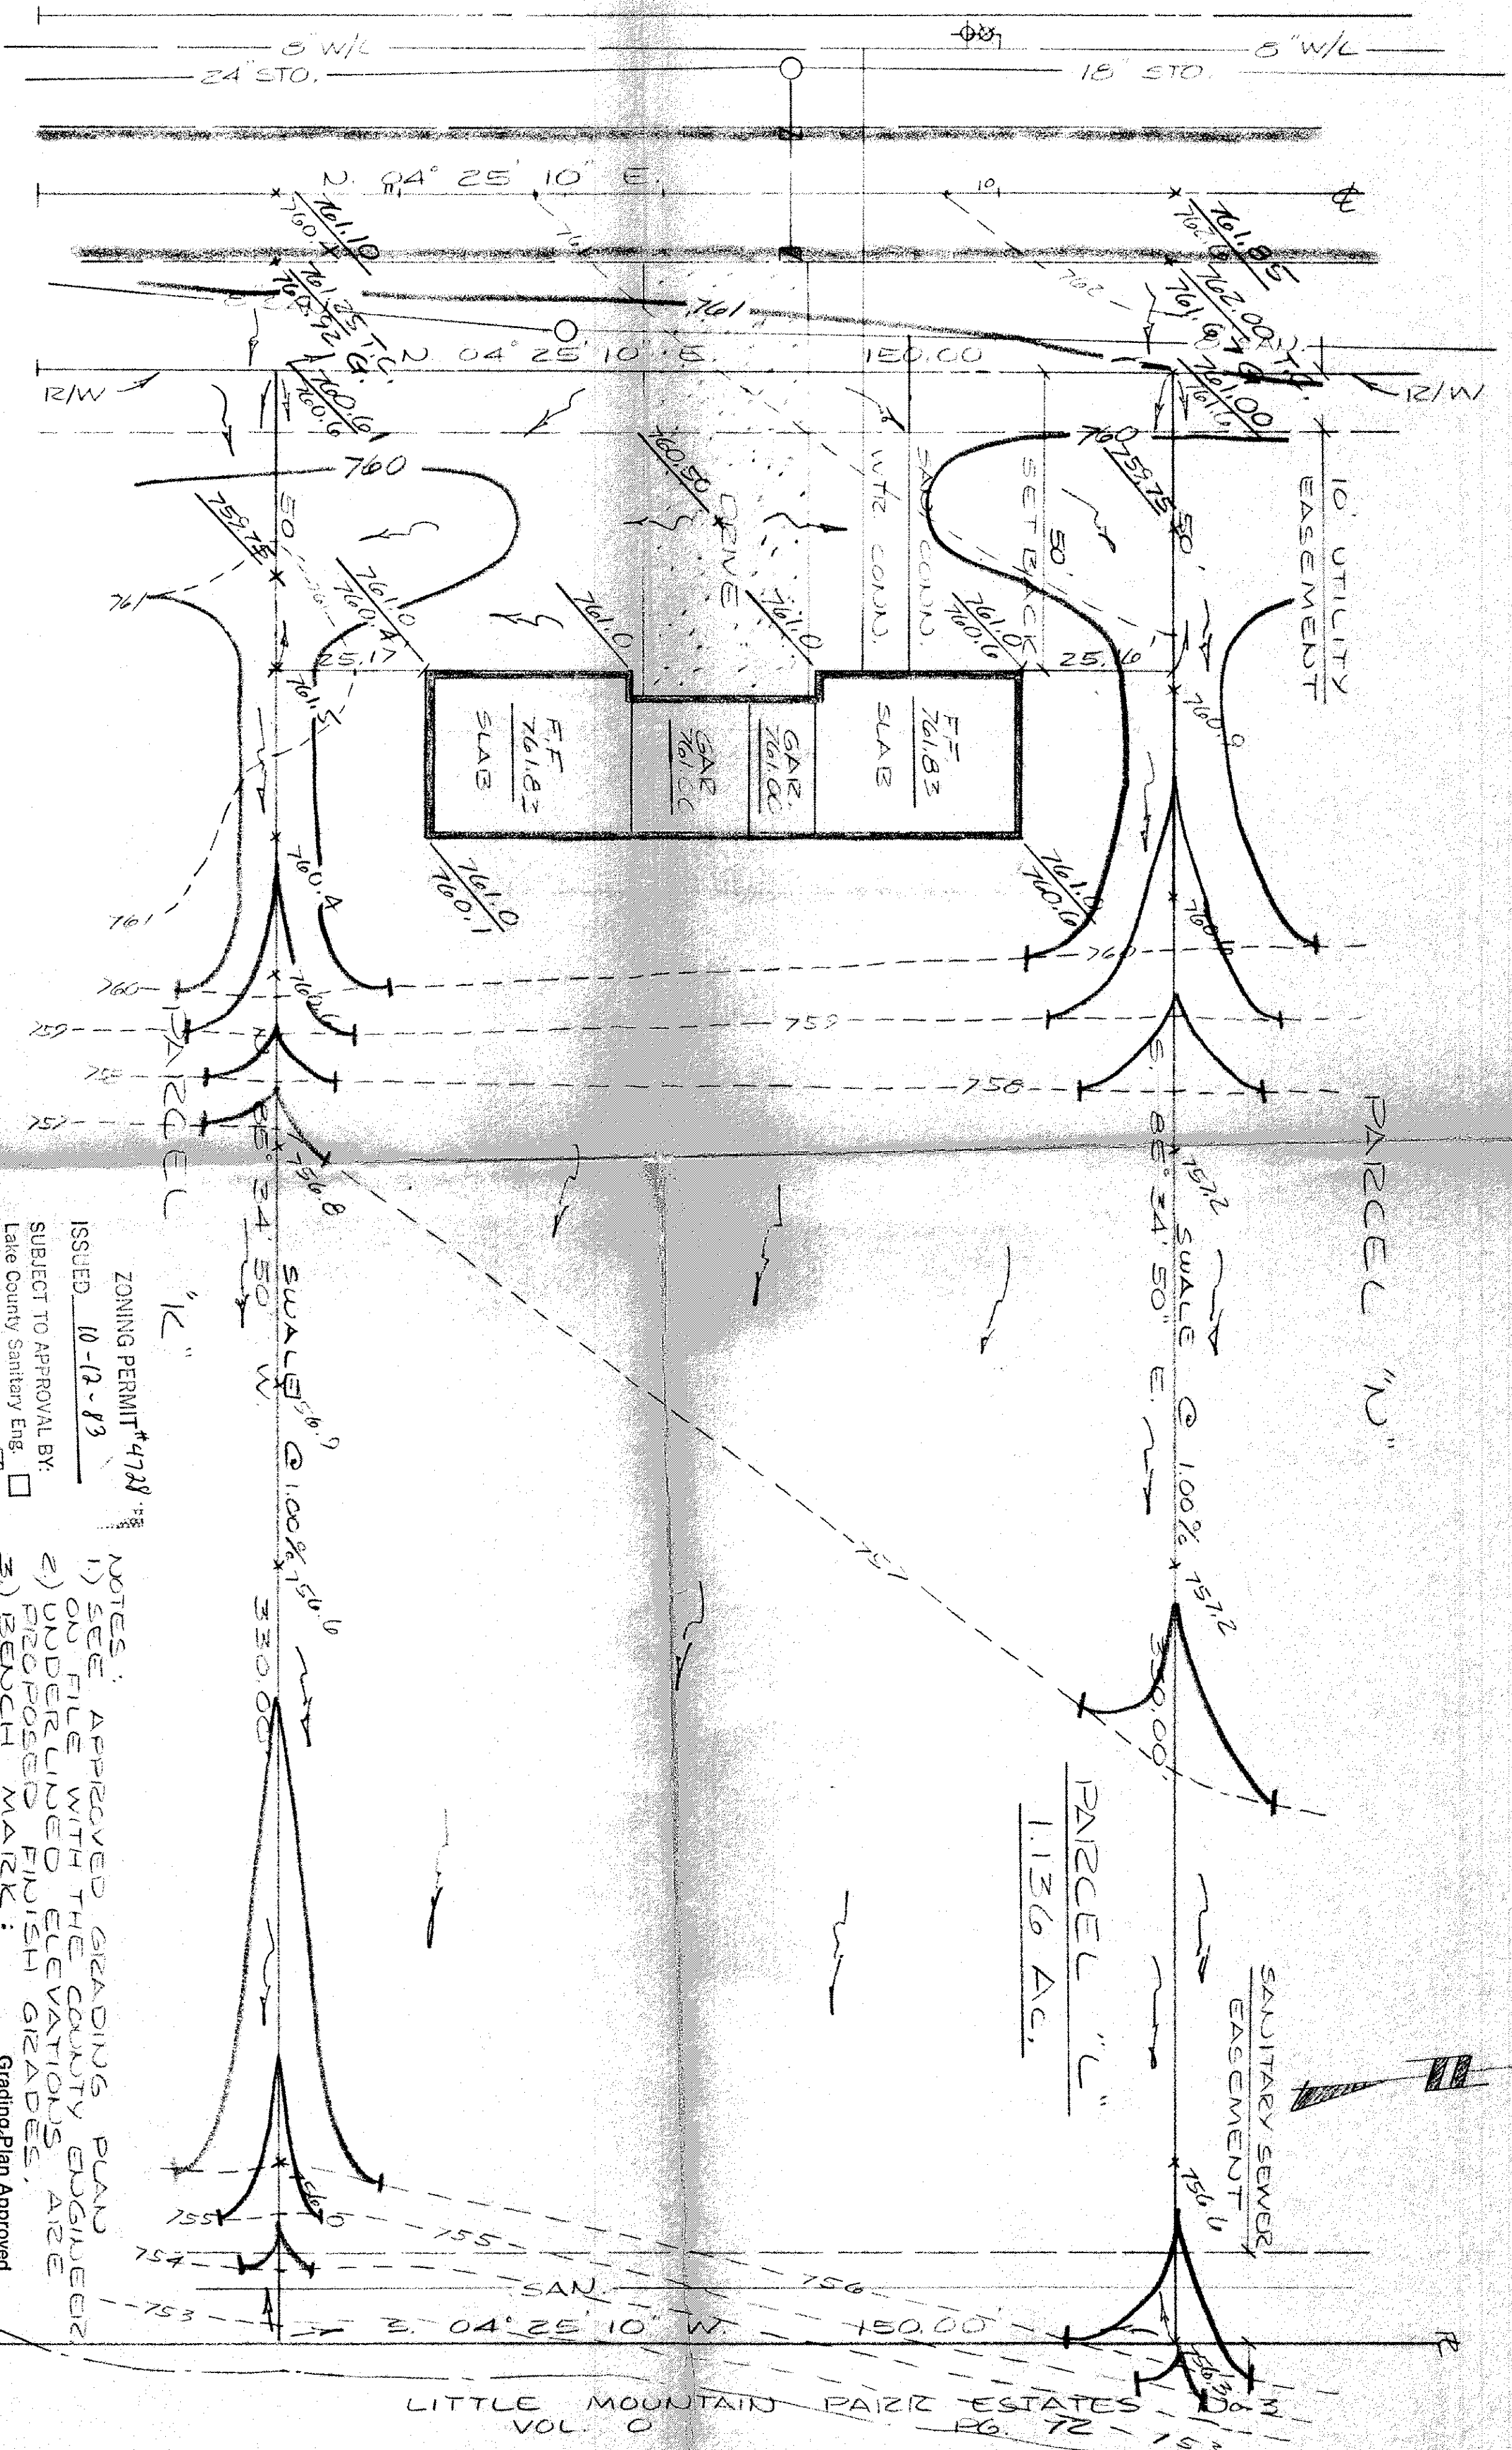

ZONING PERMIT #4728
ISSUED 10-12-83
SUBJECT TO APPROVAL BY:
Lake County Sanitary Eng. ☐
Lake County Eng. Dept. ☒
Lake County Planning Comm. ☐
Lake County Bldg. Dept. ☒
Tom J. Marcano

NOTES:
1) SEE APPROVED GRADING PLAN ON FILE WITH THE COUNTY ENGINEER
2) UNDERLINED ELEVATIONS ARE PROPOSED FINISH GRADES.
3) BENCH MARK: TOP OF F. HYD. SUBSTATION AND/OR NOTED ELEV. 765.86
Grading Plan Approved
THOMAS P. GILLES, P.E.
Lake County Engineer

By: Tom J. Marcano Date: 10-12-83

DESIGN CERTIFICATION
THIS PLAN WAS PREPARED BY ME AND IS CORRECT TO THE BEST OF MY KNOWLEDGE AND BELIEF.
Tom J. Marcano
AS BUILT CERTIFICATION
I HEREBY CERTIFY THAT THE CERTIFICATES AND EXISTING DIMENSIONS CHECKED WITH THE SURVEY IS CORRECT TO THE BEST OF MY KNOWLEDGE AND BELIEF.
Tom J. Marcano

SITE PLAN FOR:
SHADY KNOCK SUBDIVISION
PARCEL "N"
TOWNSHIP LAKE COUNTY OHIO
COLPETZER, WOODS
CONSULTANTS, INC.
MENTOR, OHIO 44060
SHEET 1 OF 1
CONTRACT NO. 83520