


"A" CURVE DATA
 E = 310.61
 A = 120.15'
 Δ = 22° 09' 44"
 T = 60.83'
 C = 119.40'
 N 15° 30' 02" E

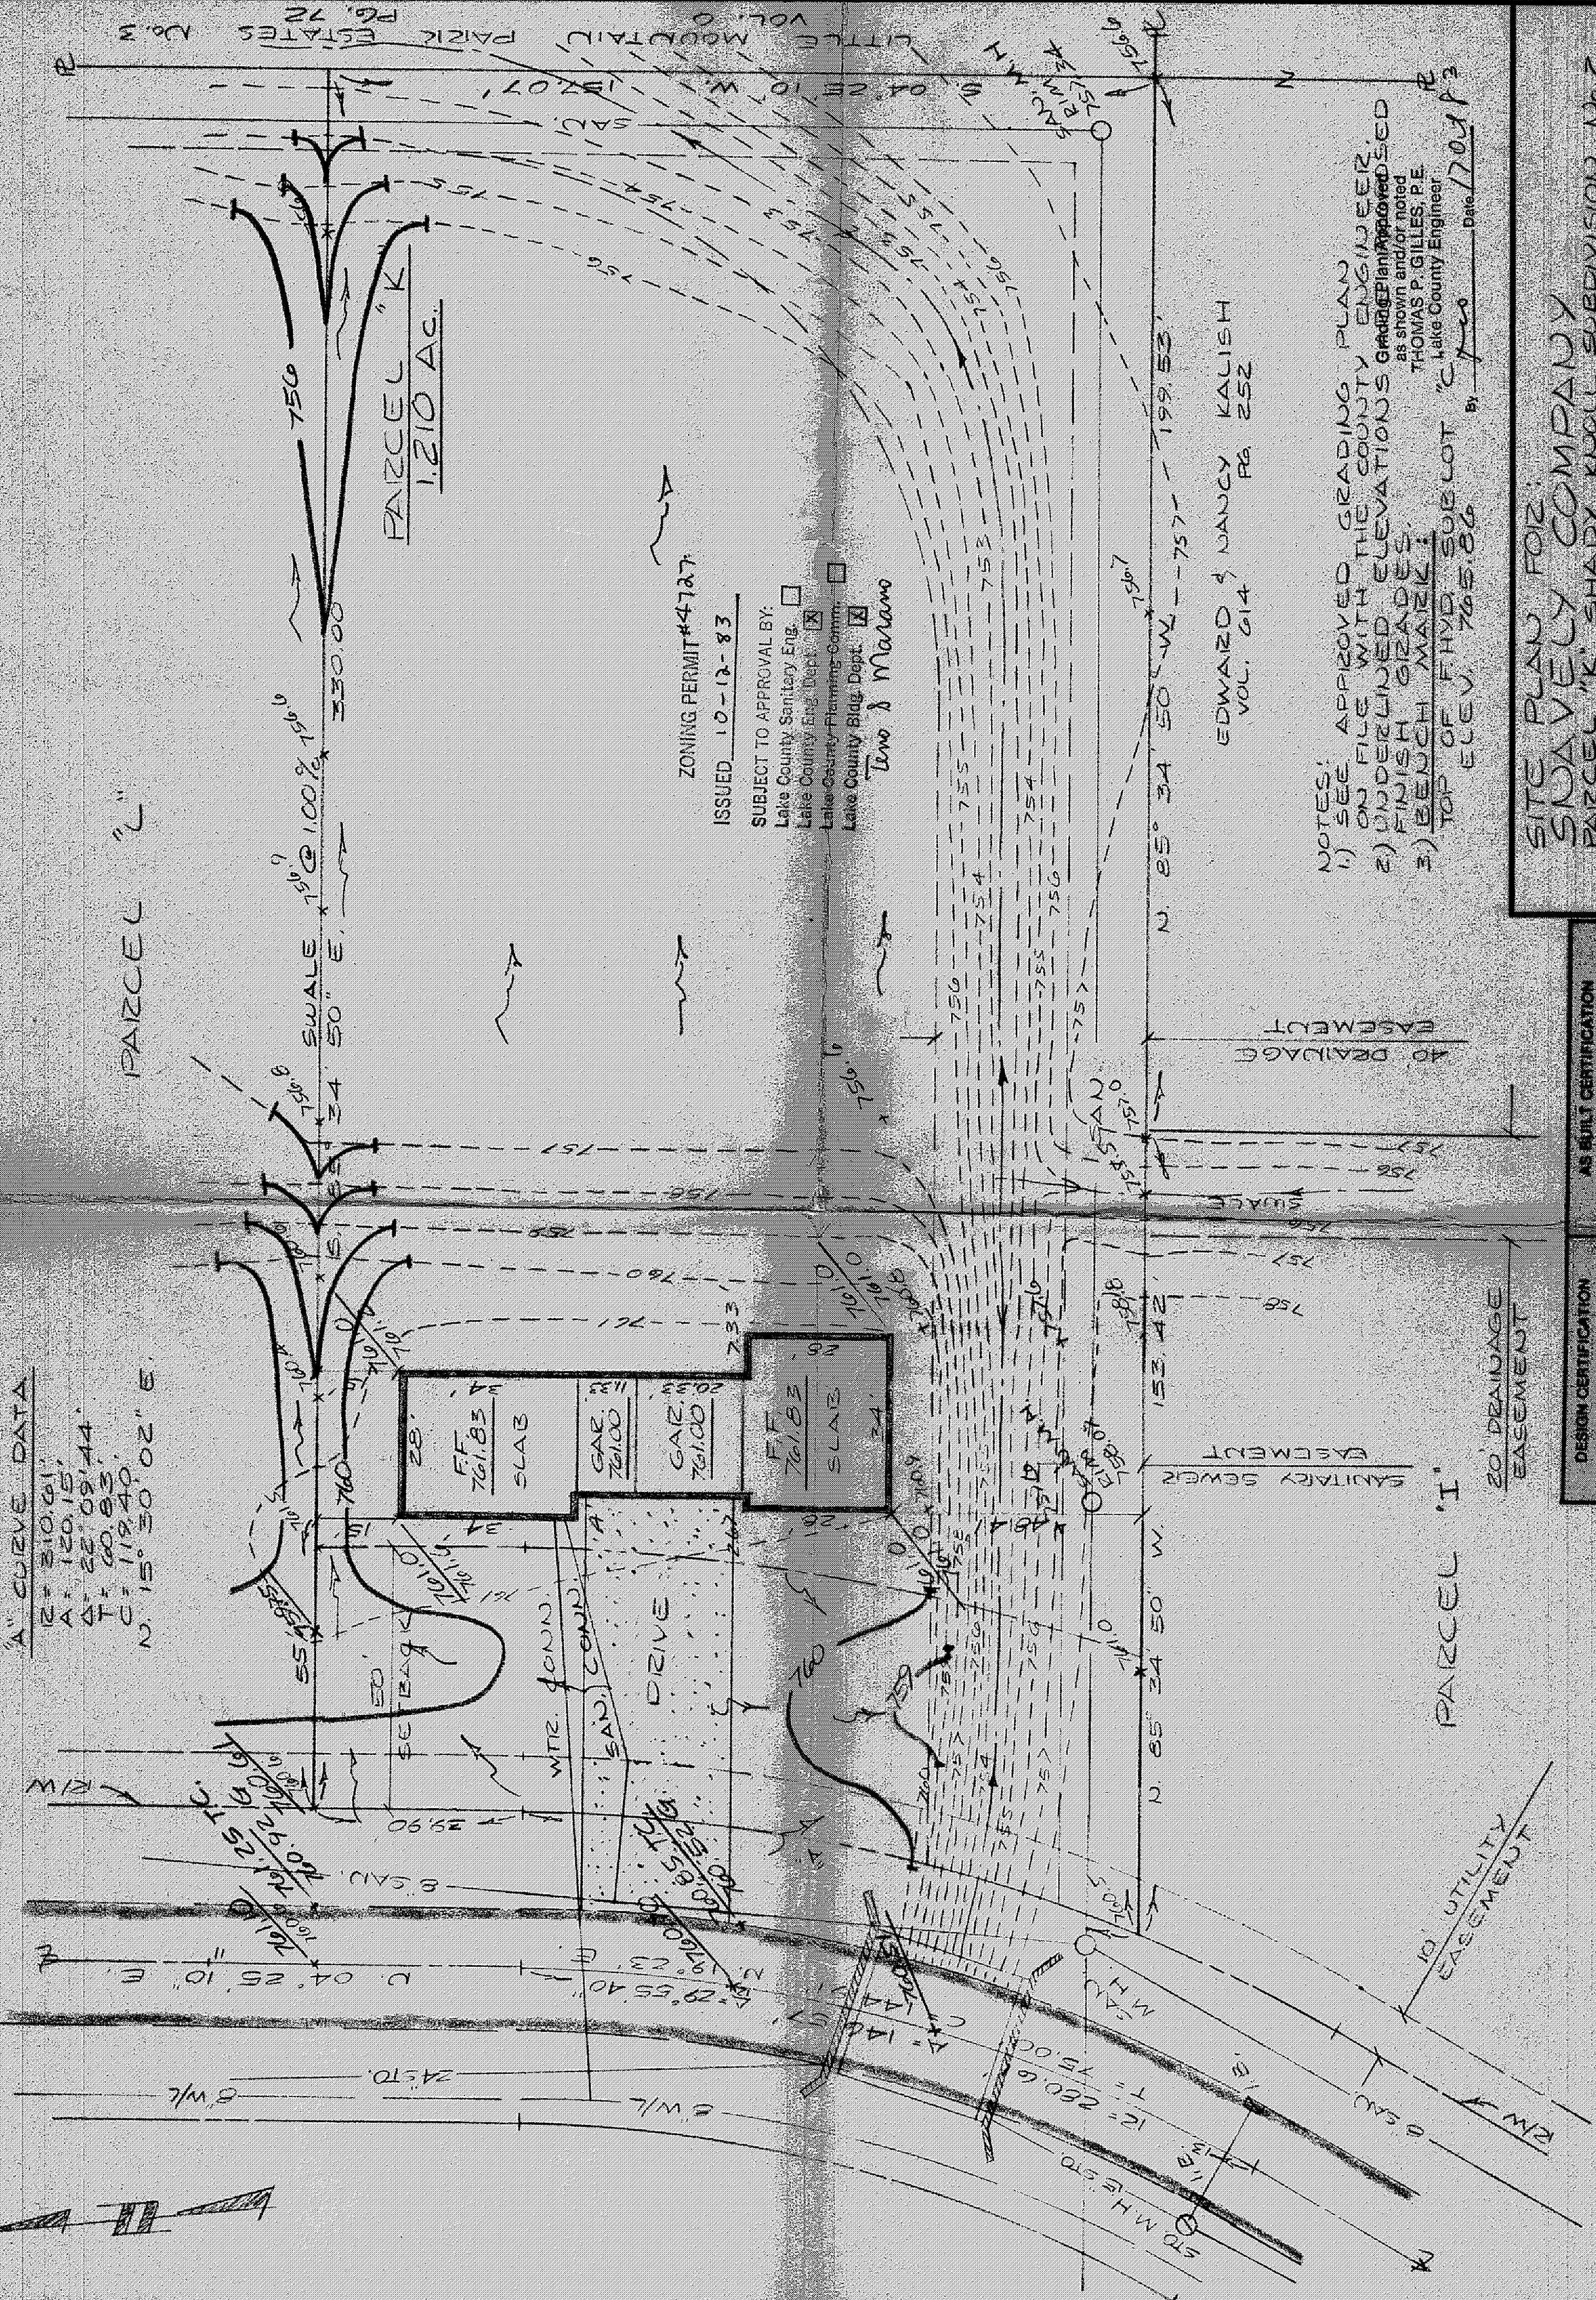

ZONING PERMIT #4727
 ISSUED 10-12-83
 SUBJECT TO APPROVAL BY:
 Lake County Sanitary Eng. ☐
 Lake County Eng. Dept. ☒
 Lake County Planning Comm. ☒
 Lake County Bldg. Dept. ☒
 Teno & Marano

NOTES:
 1) SEE APPROVED GRADING PLAN ON FILE WITH THE COUNTY ENGINEER
 2) ONDERLINED ELEVATIONS GRADING PLAN APPROVED AS SHOWN AND/OR NOTED
 3) BENCH MARK: TOP OF HYD. SUBLOT 'C' ELEV. 745.86
 DATE 10/1/83
 SCALE 1" = 40'
 DRAWN BY T.P.G.
 CHECKED BY T.P.G.
 THOMAS P. GILLES, P.E.
 Lake County Engineer
 1704 P3

SITE PLAN FOR:
SHADY KNOX COMPANY
 PARCEL "K" SHADY KNOX SUBDIVISION No. 2
 CONCORD TOWNSHIP, LAKE COUNTY, OHIO

DATE 10/1/83
SCALE 1" = 40'
DRAWN BY T.P.G.
CHECKED BY T.P.G.

COLPETZER WOODS CONSULTANTS, INC.
 MENTOR, OHIO 44060

CONTRACT NO. 28530

DESIGN CERTIFICATION
 THIS PLAN WAS PREPARED BY ME AND IS CORRECT TO THE BEST OF MY KNOWLEDGE AND BELIEF.

AS BUILT CERTIFICATION
 I HEREBY CERTIFY THAT THE CIRCLED CHANGES ARE EXISTING FIELD CHANGES OR FIELD SURVEY IS CORRECT TO THE BEST OF MY KNOWLEDGE AND BELIEF.

W.P.G.