


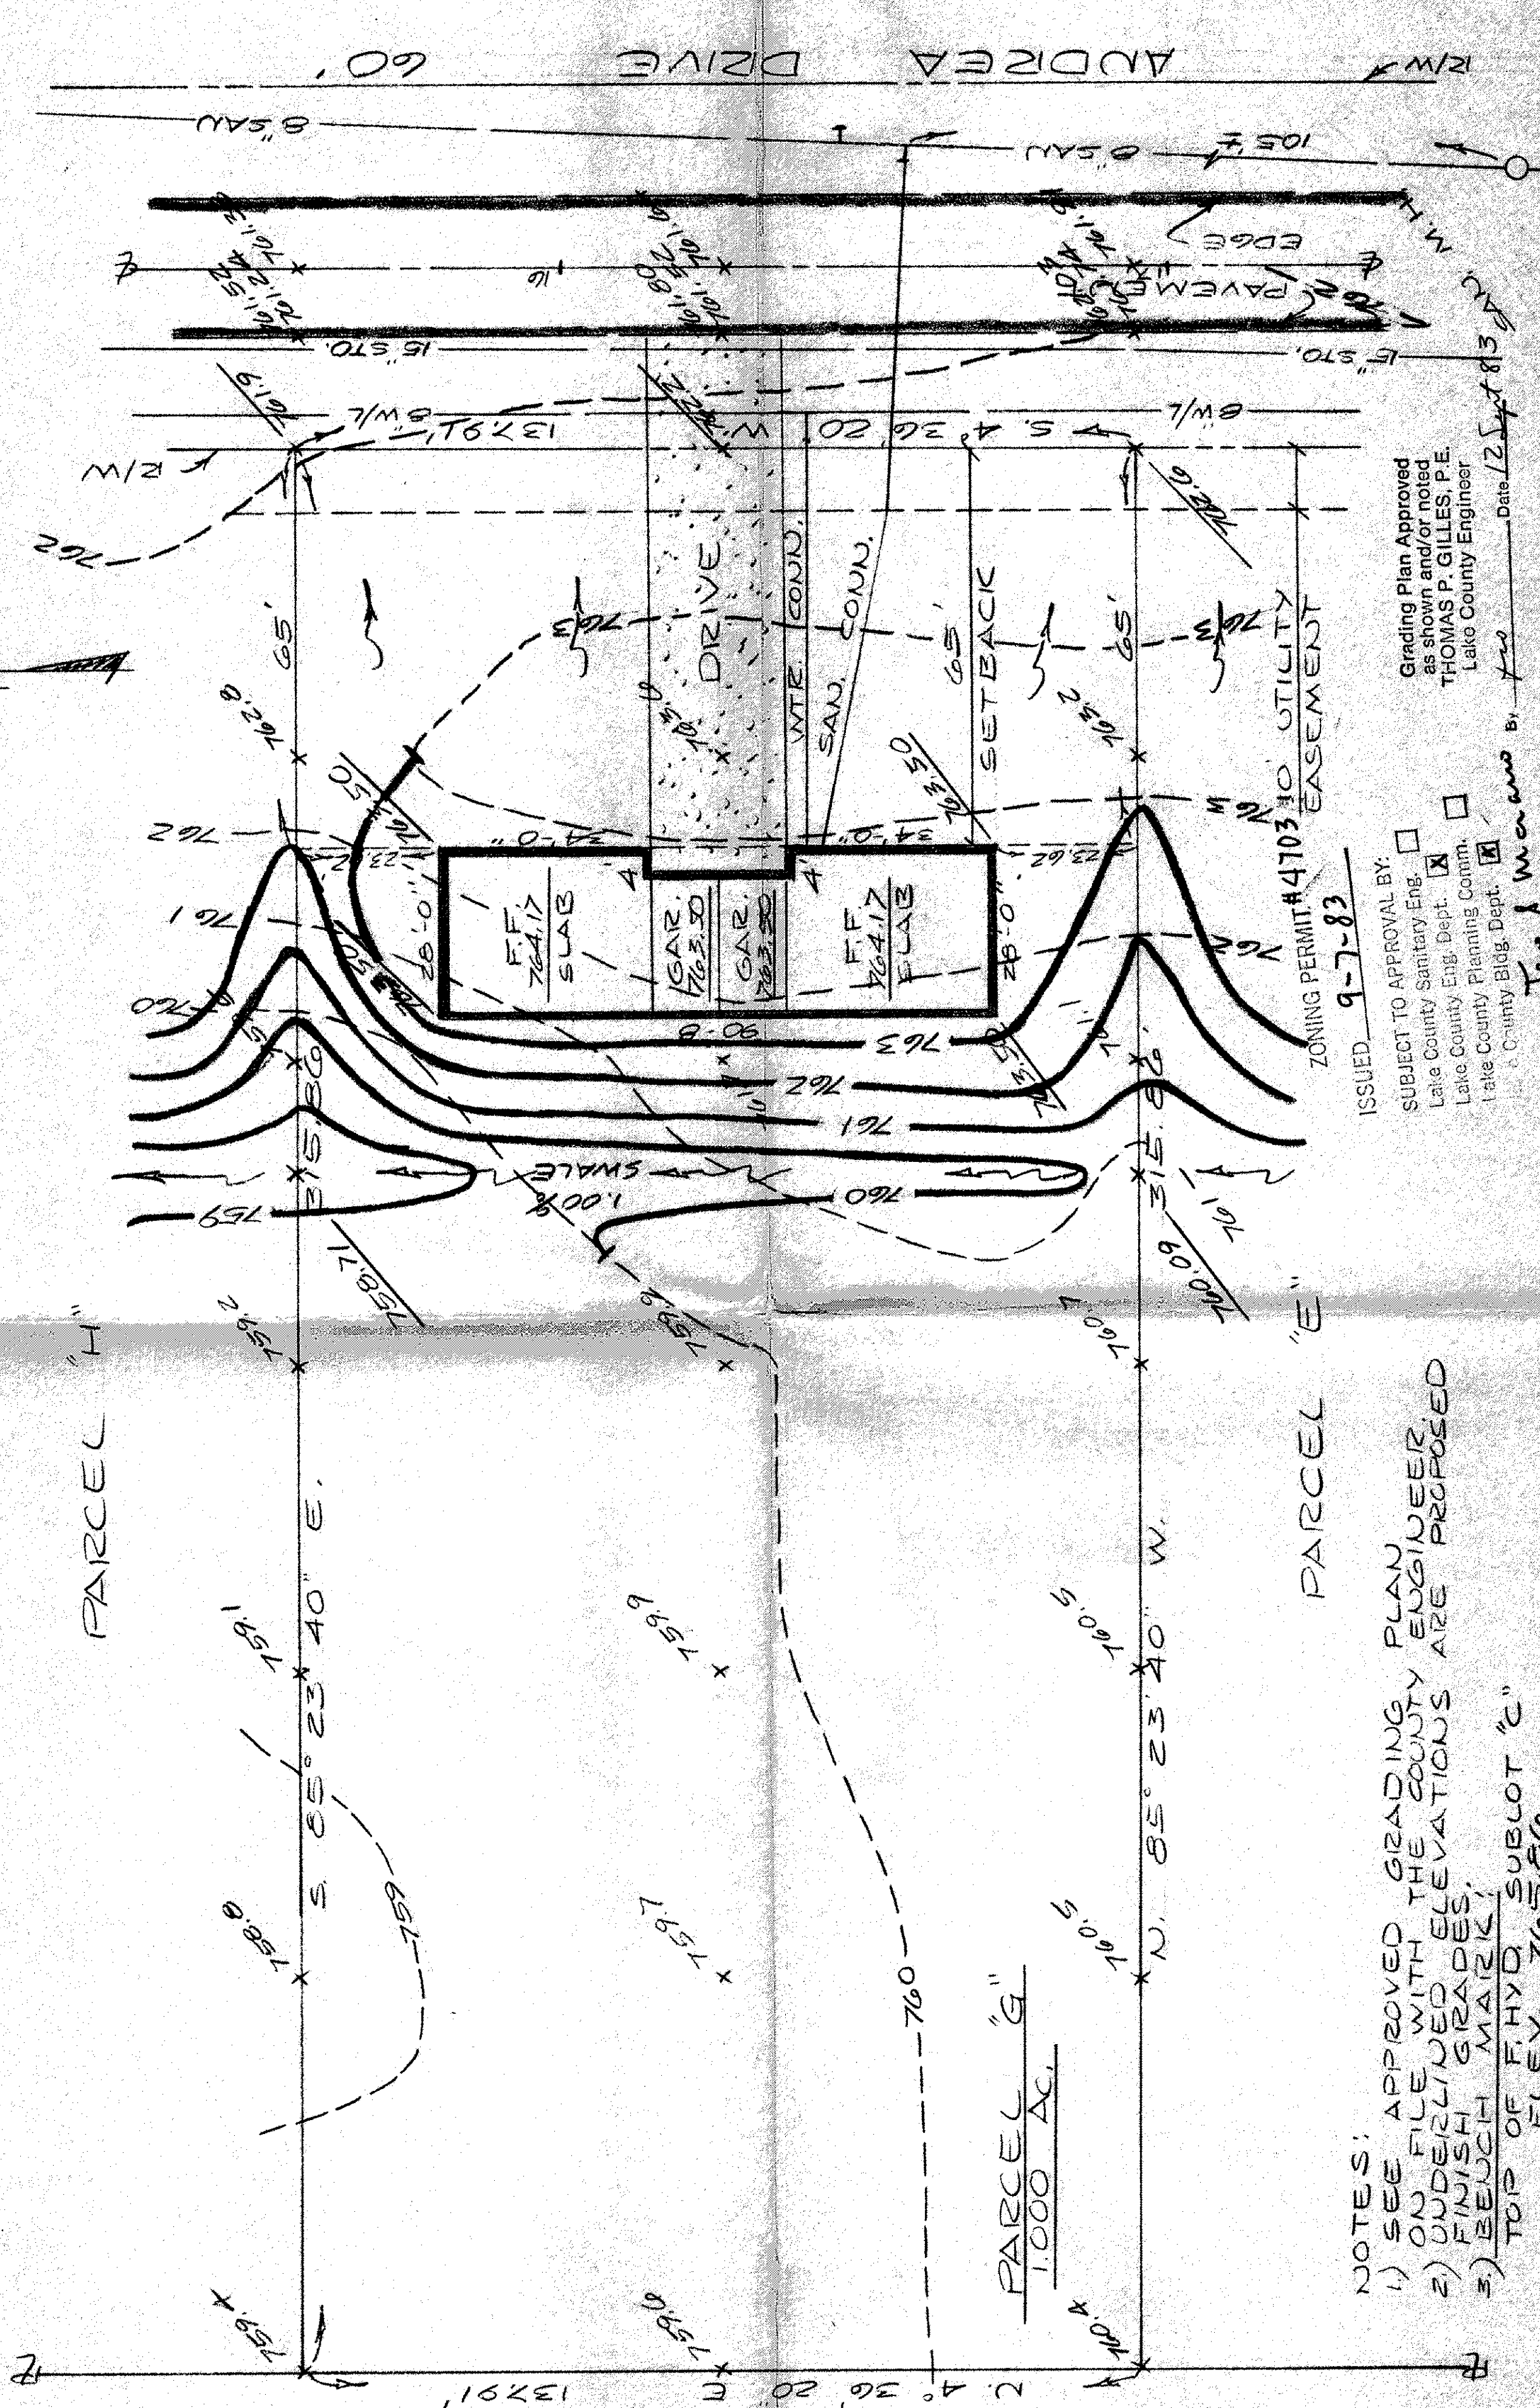

NOTES:
1) SEE APPROVED GRADING PLAN
ON FILE WITH THE COUNTY ENGINEER
2) UNDERLINED ELEVATIONS ARE PROPOSED
3) FINISH GRADES,
BENCH MARK,
TOP OF F.H.V. SUBLOT "C"
ELEV. 765.86

ISSUED 9-7-83
ZONING PERMIT #470310
UTILITY EASEMENT
Grading Plan Approved
as shown and/or noted
THOMAS P. GILLES, P.E.
Lake County Engineer

DESIGN CERTIFICATION
THIS PLAN WAS PREPARED BY ME
AND IS CORRECT TO THE BEST OF
MY KNOWLEDGE AND BELIEF
W. J. G. [Signature]
AS BUILT CERTIFICATION
I HEREBY CERTIFY THAT THE CIRCLED ELEVATIONS
ARE EXISTING FINISH GRADES AND THAT THE
UNCIRCLED ELEVATIONS ARE PROPOSED FINISH GRADES
AND BELIEF

SITE PLAN FOR:
SNAVELLY COMPANY
PARCEL "G" SHADY KNOLL SUBDIVISION
CONCORD TOWNSHIP, LAKE COUNTY, OHIO

COLPETZER WOODS
CONSULTANTS, INC.
MENTOR, OHIO 44060

DATE 9-7-83
SCALE 1"=20'
DRAWN BY [Signature]
CHECKED BY [Signature]
SHEET 1 OF 1
CONTRACT # 83-520