


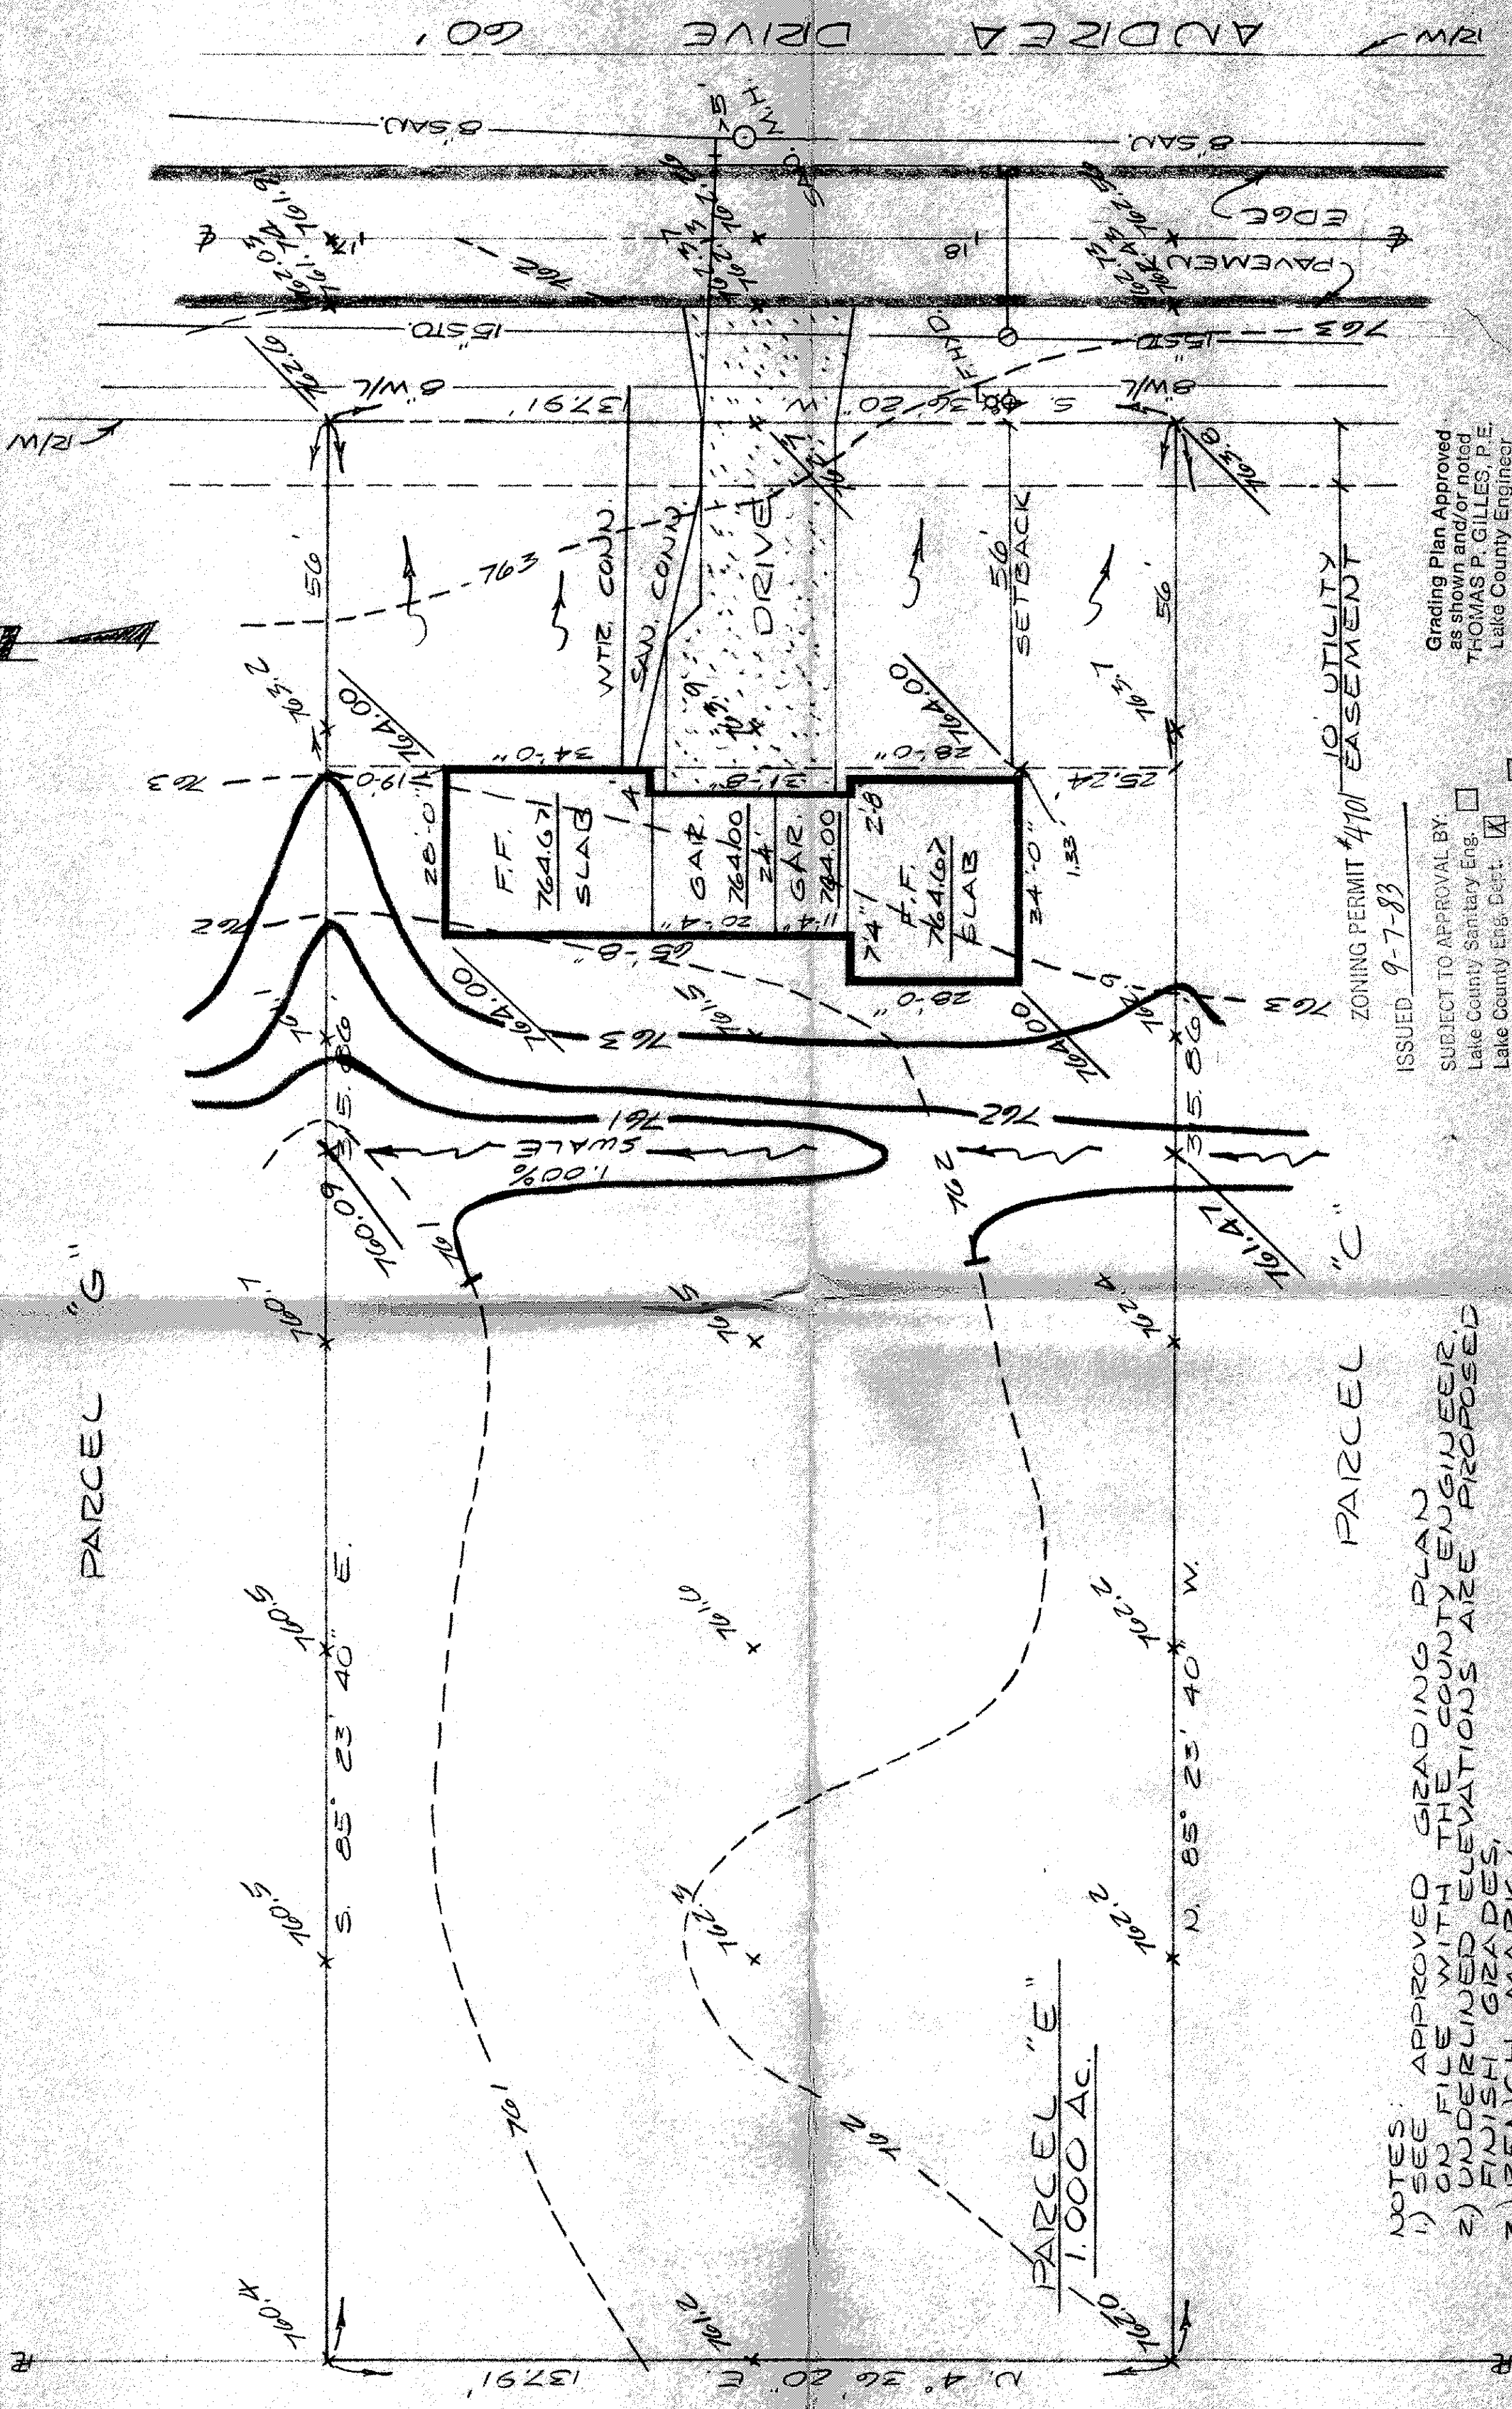

NOTES:
1) SEE APPROVED GRADING PLAN ON FILE WITH THE COUNTY ENGINEER.
2) UNDERLINED ELEVATIONS ARE PROPOSED FINISH GRADES.
3) BENCH MARK, TOP OF F HYD. SUBLOT "C" ELEV. 765.68

ISSUED 9-7-83
ZONING PERMIT #1701 EASEMENT
Grading Plan Approved as shown and/or noted
THOMAS P. GILLES, P.E.
Lake County Engineer
By Joe J. Marano Date 12 Sept 83
SUBJECT TO APPROVAL BY:
☐ Lake County Sanitary Eng.
☒ Lake County Eng. Dept.
☐ Lake County Planning Comm.
☒ Lake County Bldg. Dept.

SITE PLAN FOR:
SNAVELLY COMPANY
PARCEL "E" SHADY KNOLL SUBDIVISION
CONCORD TOWNSHIP LAKE COUNTY, OHIO

COLPETZER WOODS CONSULTANTS, INC.
MENTOR, OHIO 44060

DATE 9-7-83
SCALE 1"=20'
DRAWN BY JD
CHECKED BY JD
SHEET 1 OF 1
CONTRACT NO. 83-520

DESIGN CERTIFICATION
THIS PLAN WAS PREPARED BY ME AND IS CORRECT TO THE BEST OF MY KNOWLEDGE AND BELIEF.
Joe J. Marano
REG. SURVEYOR NO. 4444

AS BUILT CERTIFICATION
I HEREBY CERTIFY THAT THE CHANGED GRADES ARE EXISTING FINISH GRADES CHECKED IN THE FIELD ON 9-7-83 AND ARE CORRECT TO THE BEST OF MY KNOWLEDGE AND BELIEF.
Joe J. Marano
REG. SURVEYOR NO. 4444

HOLLY HILLS DEVELOPMENT CO. INC.
VOL. 602
Pg. 7