


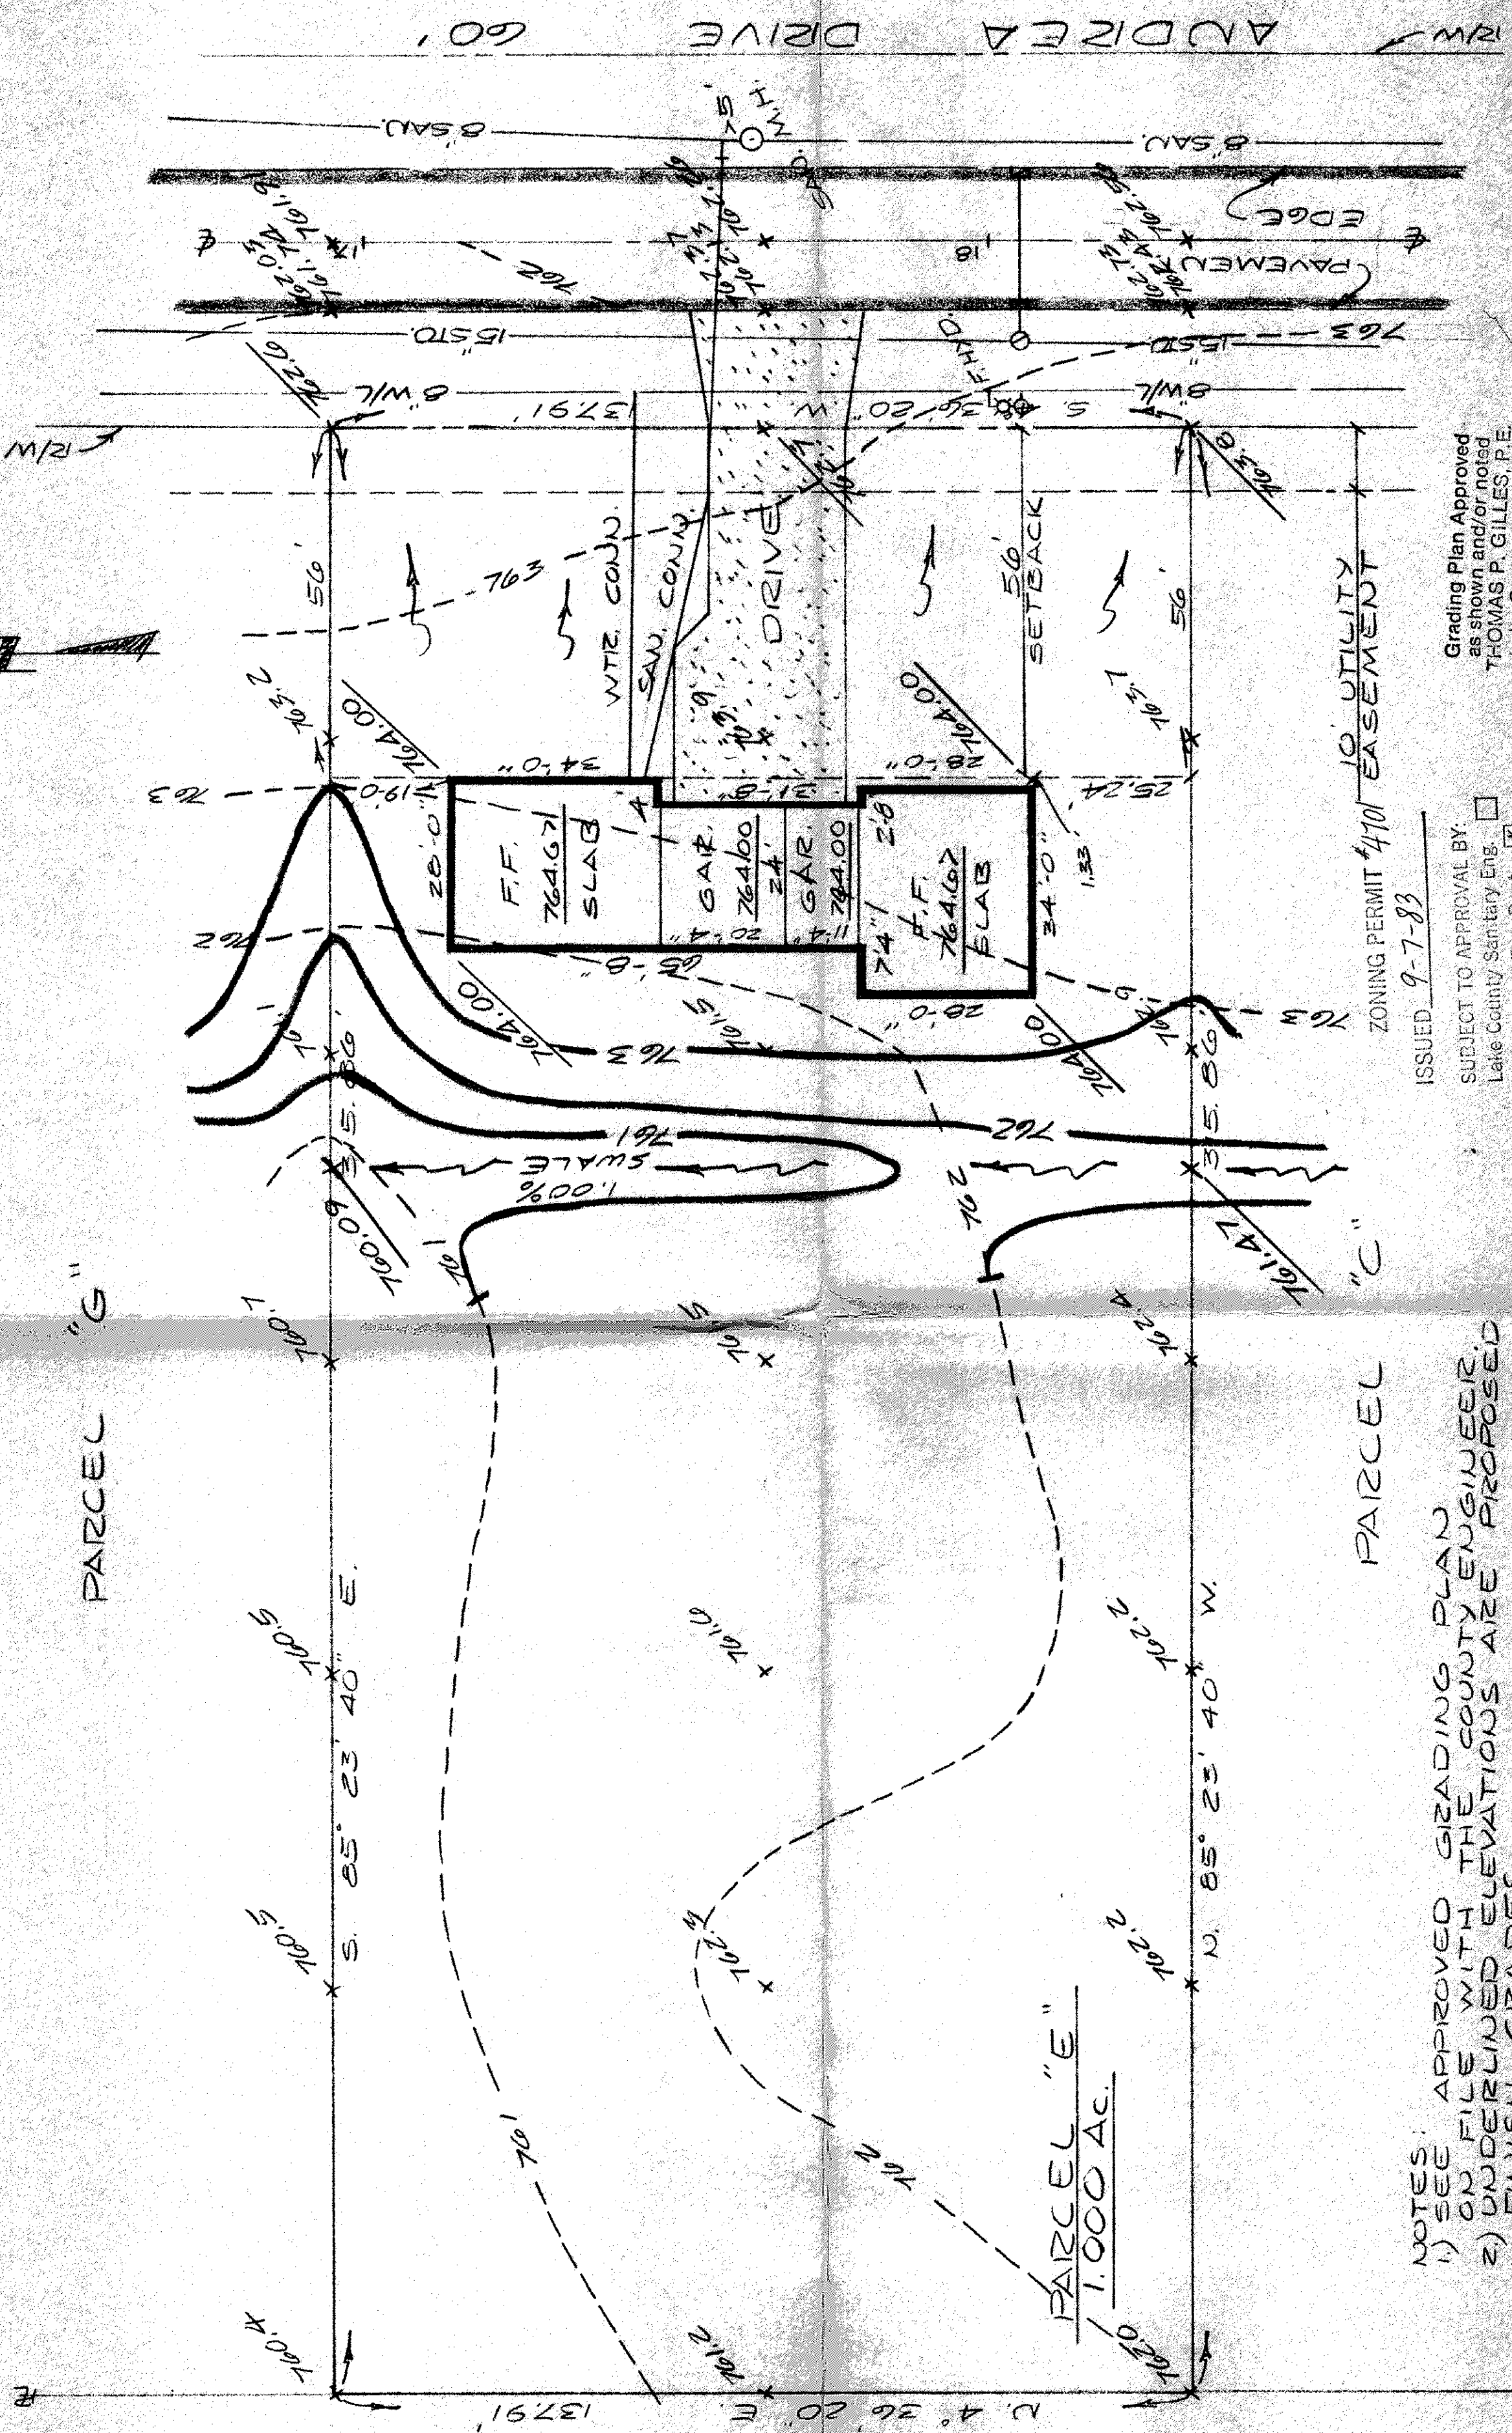

NOTES:
1) SEE APPROVED GRADING PLAN ON FILE WITH THE COUNTY ENGINEER.
2) UNDERLINED ELEVATIONS ARE PROPOSED
3) FINISH GRADES, BENCH MARK, TOP OF F.H.D. SUBLOT "C" ELEV. 765.68

ISSUED 9-7-83
ZONING PERMIT #4101 EASEMENT
Grading Plan Approved as shown and/or noted
THOMAS P. GILLES, P.E.
Lake County Engineer
By Yeo Date 12 Sept 83
SUBJECT TO APPROVAL BY:
☐ Lake County Sanitary Eng.
☒ Lake County Eng. Dept.
☐ Lake County Planning Comm.
☒ Lake County Bldg. Dept.
Don J. Marano

DESIGN CERTIFICATION
THIS PLAN WAS PREPARED BY ME AND IS CORRECT TO THE BEST OF MY KNOWLEDGE AND BELIEF.
Thomas P. Gilles
P.E.
DATE 9-7-83

AS BUILT CERTIFICATION
I HEREBY CERTIFY THAT THE CROOKED GRADES ARE EXISTING FINISH GRADES CHECKED IN THE FIELD AND ARE CORRECT TO THE BEST OF MY KNOWLEDGE AND BELIEF.
Don J. Marano
P.E.
DATE 12-9-83

SITE PLAN FOR:
SWAVELEY COMPANY
PARCEL "E" SHADY KNOLL SUBDIVISION
CONCORD TOWNSHIP LAKE COUNTY, OHIO
COLPETZER WOODS
CONSULTANTS, INC.
MENTOR, OHIO 44060
DATE 9-7-83
SCALE 1"=20'
DRAWN BY Yeo
CHECKED BY Yeo
P.E.
SHEET 1 OF 1
CONTRACT NO. 03-520

HOLLY HILLS DEVELOPMENT CO. INC.
VOL. 662
Pg. 7