


- NOTES:
- 1) SEE APPROVED GRADING PLAN ON FILE WITH THE COUNTY ENGINEER.
 - 2) UNDERLINED ELEVATIONS ARE PROPOSED FINISH GRADES.
 - 3) BENCH MARK:

SAN. AN. E.V.M. AT SOUTH SIDE OF PARCEL "B".
ELEV. 705.85.

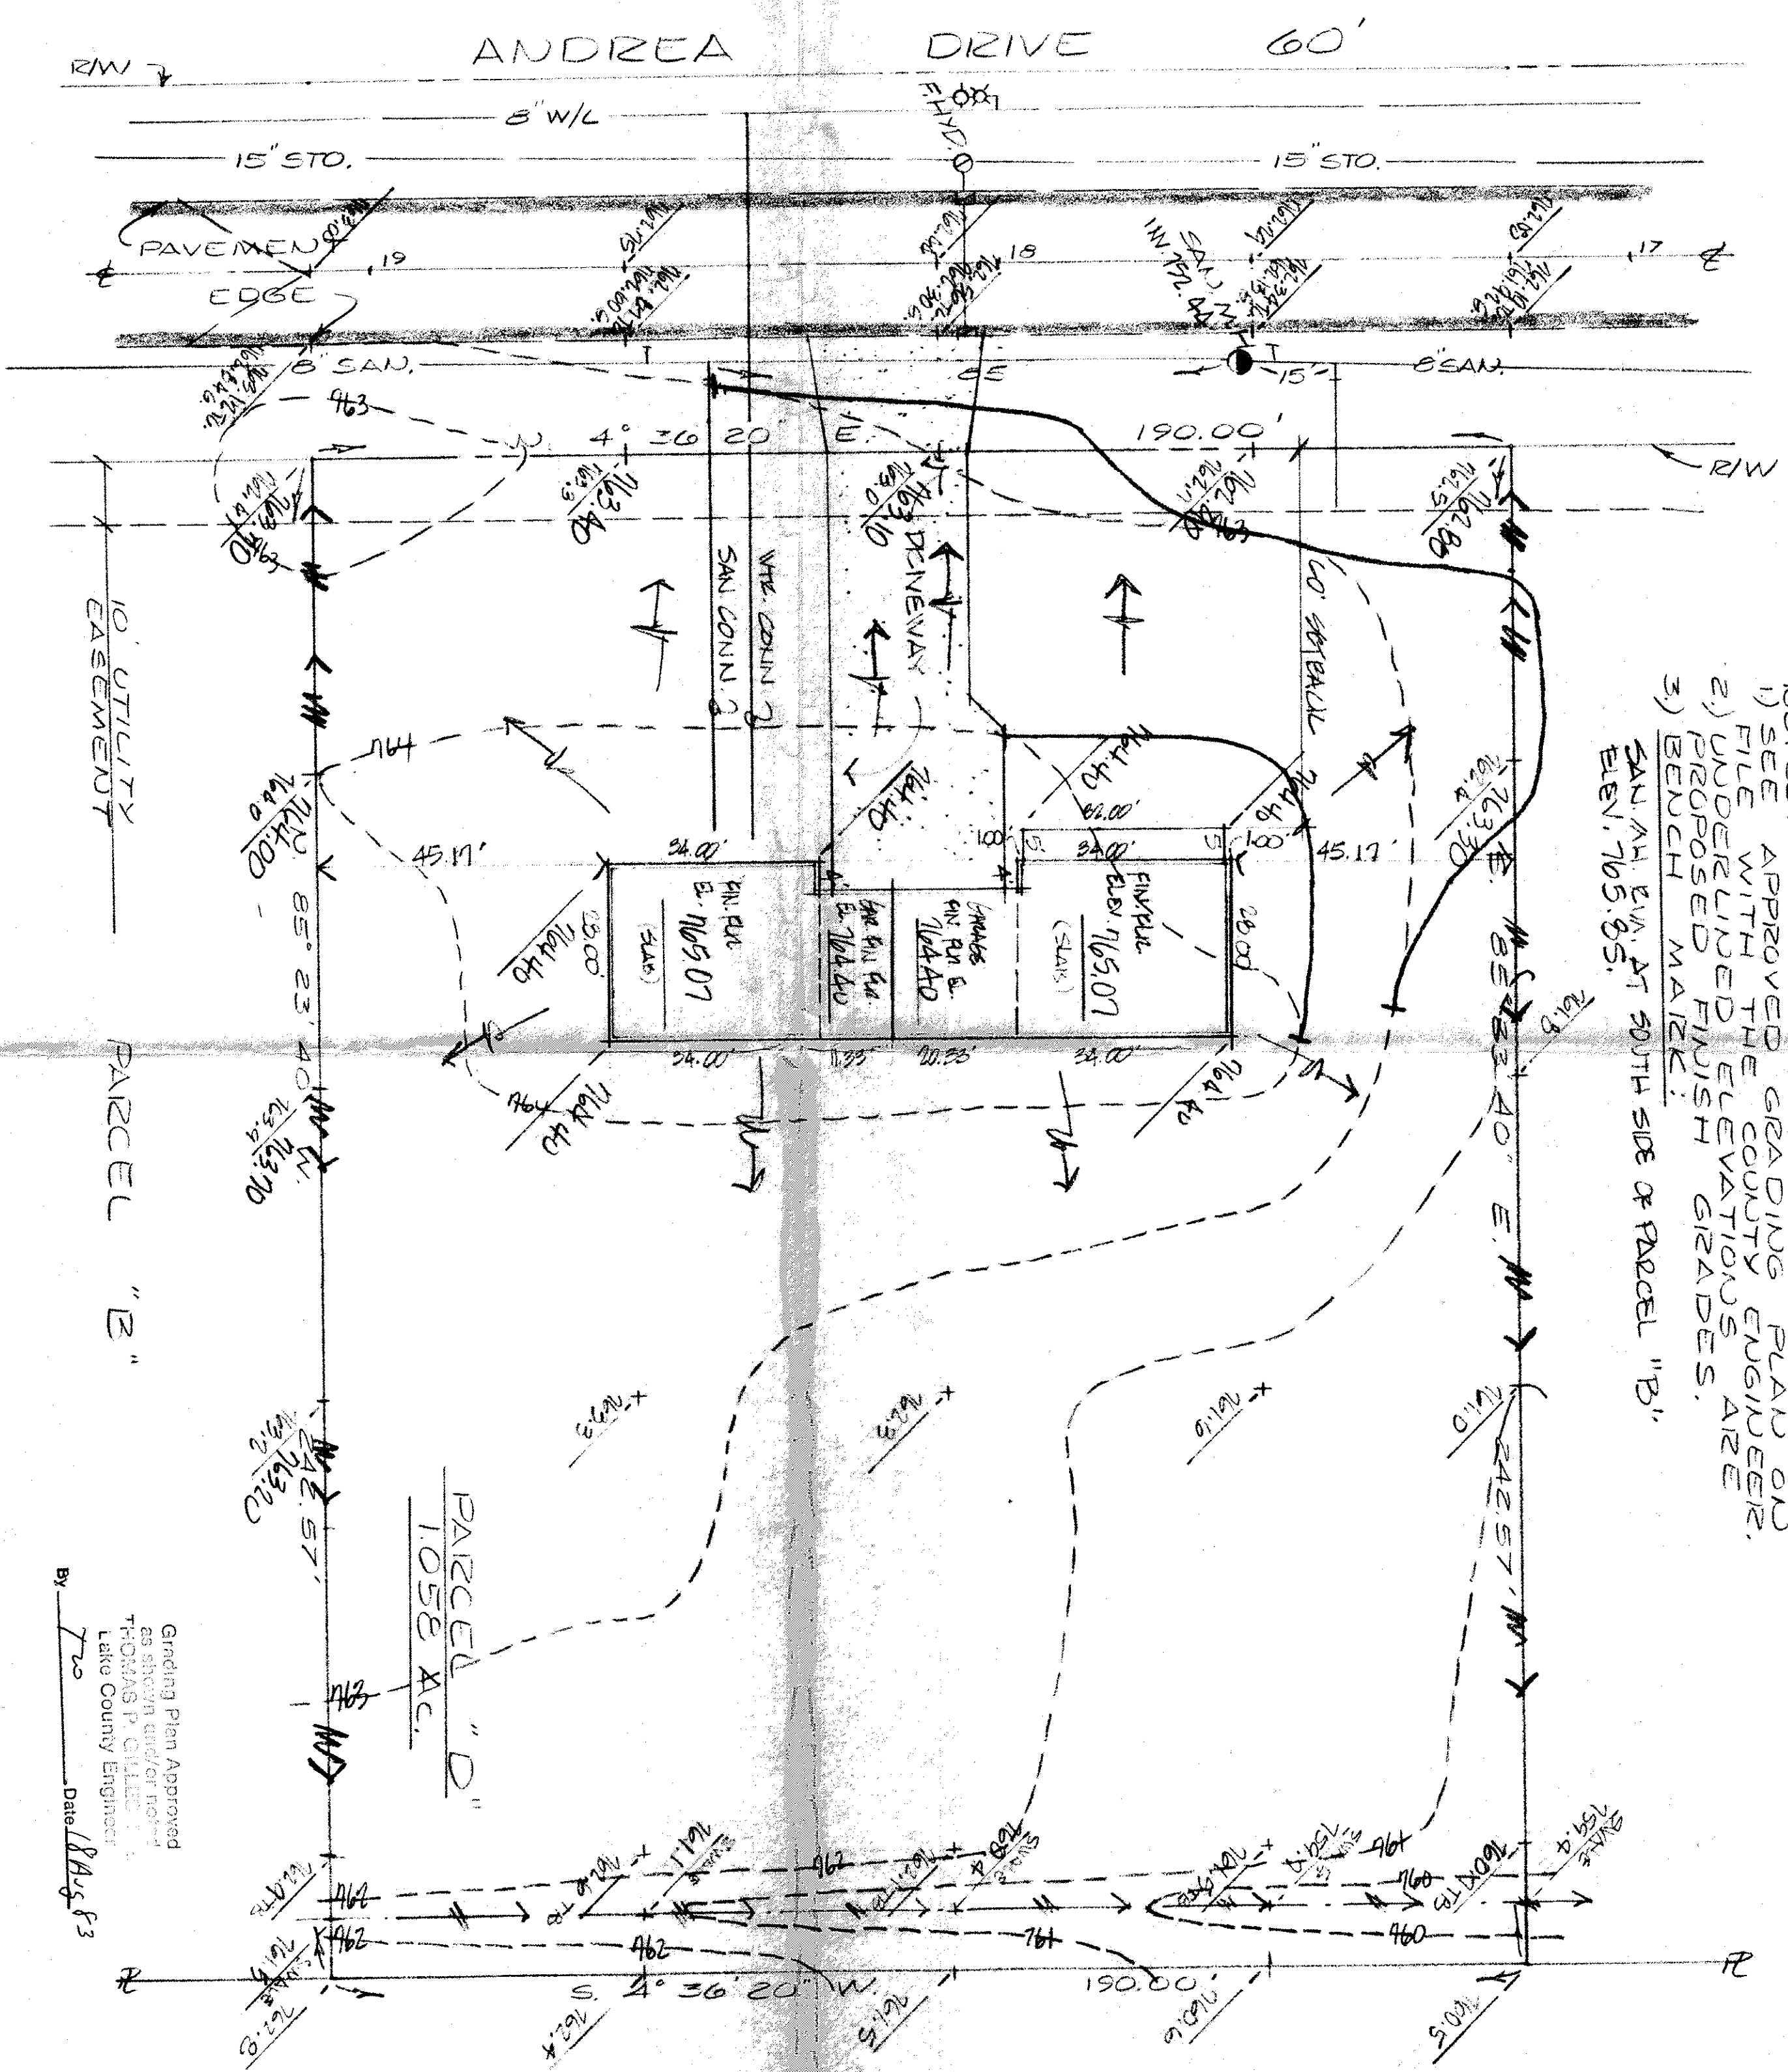

RALPH W. JR. & JEANNETTE B. BELL
VOL. 756 PG. 1092, VOL. 757 PG. 233

ZONING PERMIT #4688
ISSUED 8-17-83

SUBJECT TO APPROVAL BY:
☐ Lake County Sanitary Eng.
☒ Lake County Eng. Dept.
☐ Lake County Planning Comm.
☒ Lake County Bldg. Dept.
Tom J. Mearns

Grading Plan Approved
as shown and/or noted
THOMAS P. GILLES
Lake County Engineer
By *Tom* Date *18 Aug 83*

LEGEND:

- 100.00 --- PROPOSED GRADES
- 700.0 --- EXISTING ELEVATIONS
- EXISTING CONTOUR LINES
- PROPOSED CONTOUR LINES
- DRIVE LANE AND DIRECTION

DESIGN CERTIFICATION
THIS PLAN WAS PREPARED BY ME
AND IS CORRECT TO THE BEST OF
MY KNOWLEDGE AND BELIEF

AS BUILT CERTIFICATION
I HEREBY CERTIFY THAT THE CIRCLED GRADES
ARE EXISTING FINISH GRADES CHECKED IN THE
FIELD ON _____ AND THAT
THE SURVEY IS CORRECT TO THE BEST OF MY
KNOWLEDGE AND BELIEF

SITE PLAN FOR
SNAVELLY COMPANY
PARCEL "D" SHADY LAKE SUBDIVISION
COLUMBIANA TOWNSHIP, OHIO

COLPETZER & WOODS
CONSULTANTS, INC.
MENTOR, OHIO 44060

DATE *8/16/83*
SCALE *1"=50'*
DRAWN BY *AGB*
CHECKED BY *WJ*
F&E NO. *14*

SHEET *1* OF *1*
CONTRACT NO. *83-501*