

Grading Plan Approved
as shown and/or noted
THOMAS P. GILLESPIE
Lake County Eng.

By TMP Date 11-8-84

SITE PLAN
for NEIL SHIPLEY of
S/L 8 IN THE FOREST WOOD SUBD.
(VOL Y PG 40) NOW IN

CONCORD TWP
LAKE COUNTY
OHIO

SCALE 1"=30' NOV 1984

7675 S Andrea
Concord Twp.



ZONING PERMIT #4954

ISSUED 11-7-84

SUBJECT TO APPROVAL BY:


Lake County Sanitary Eng. ☐

Lake County Eng. Dept. ☒

Lake County Planning Comm. ☐

Lake County Bldg. Dept. ☒

Teno & Marano

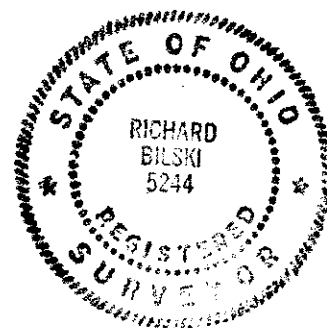

DESIGN CERTIFICATION

THIS PLAT WAS PREPARED BY ME,
AND IS CORRECT TO THE BEST OF
MY KNOWLEDGE AND BELIEF.

R. Bilski

REG. SURVEYOR NO. 5244

AS BUILT CERTIFICATION

I HEREBY CERTIFY THAT THE CIRCLED GRADES
ARE EXISTING FINISH GRADES CHECKED IN THE
FIELD ON AND THAT
SURVEY IS CORRECT TO THE BEST OF MY
KNOWLEDGE AND BELIEF.

REG. SURVEYOR NO. _____



COLPETZER · WOODS
CONSULTANTS, INC.

9470 MENTOR AVENUE • MENTOR, OHIO 44060 • (216) 357-7569

DATE 11/5/84

SCALE 1"=30'

DRWN BY JSB

CHKD BY JSB

JOB NO. 88-0

FB _____ PG _____