


SITE PLAN

OKLAHOMA TOWNSHIP LAKE COUNTY, OHIO

for: WILHELM BULLOCKS

ADDRESS	STREET	CITY	ZIP
Subdivision: <u>Forest Hills Sub.</u> Volume: <u>11</u> Page: <u>11</u> Sheet: <u>11</u>			

Surveying Plan Approved
 as shown and/or noted
 THOMAS P. GILLES, P.E.
 Lake County Engineer
 Date: 10/18/87

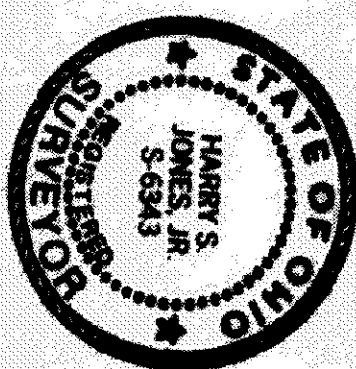

LEGEND	
SANITARY MANHOLE	WATER VALVE (GAS)
STORM MANHOLE	WATER METER (GAS)
INLET OR CATCH BASIN	AS BUILT ELEVATION
HYDRANT	INDICATES DIRECTION OF SURFACE DRAINAGE
EXISTING CONTOURS	
PROPOSED CONTOURS	
EXIST. ELEV. 100.0	PROP. ELEV. 100.0

REMARKS

ALL BOUNDARY DATA SHOWN WAS OBTAINED FROM (DEEDS, RECORDED SUBDIVISION PLAT OR OTHER PUBLIC RECORDS)
 LOCATIONS AS SHOWN OF ADJACENT WELLS AND SEPTIC TANKS OBTAINED FROM LAKE COUNTY HEALTH DEPARTMENT

DESIGN CERTIFICATION
 THIS PLAT WAS PREPARED BY ME, AND IS CORRECT TO THE BEST OF MY KNOWLEDGE AND BELIEF

NAME: William Bullucks REGISTRATION NO.: 16343

CHECK LIST

NO. OF ROOMS	NO. OF SEPTIC TANKS	NO. OF WELLS	NO. OF ADJACENT WELLS	NO. OF ADJACENT SEPTIC TANKS
1	1	1	1	1
2	2	2	2	2
3	3	3	3	3
4	4	4	4	4
5	5	5	5	5

PLAN PREPARED BY:

BABCOCK • JONES & ASSOCIATES, INC.

PAINEVILLE, OHIO

NO.	DATE	BY	SCALE	PHONE NO.
1			1" = 20'	357-1811
2				
3				
4				
5				

"AS BUILT" CERTIFICATION

I, HEREBY CERTIFY THAT THE CIRCLED GRADES ARE EXISTING FINISH GRADES CHECKED IN THE FIELD ON 10/18/87 AND ARE CORRECT TO THE BEST OF MY KNOWLEDGE AND BELIEF.

REGISTERED SURVEYOR

REG. NO.

TBM - LCM SAL M.H.
 221 - 770.11

ZONING PERMIT #6017
 100-27-88

SUBJECT TO APPROVAL BY:
☐ Lake County Planning Dept.
☒ Lake County Eng. Dept.
☐ Lake County Health Dept.
☐ Lake County Eng. Dept.

Town of Mansura

ADDRESS DRIVE - 00'

