


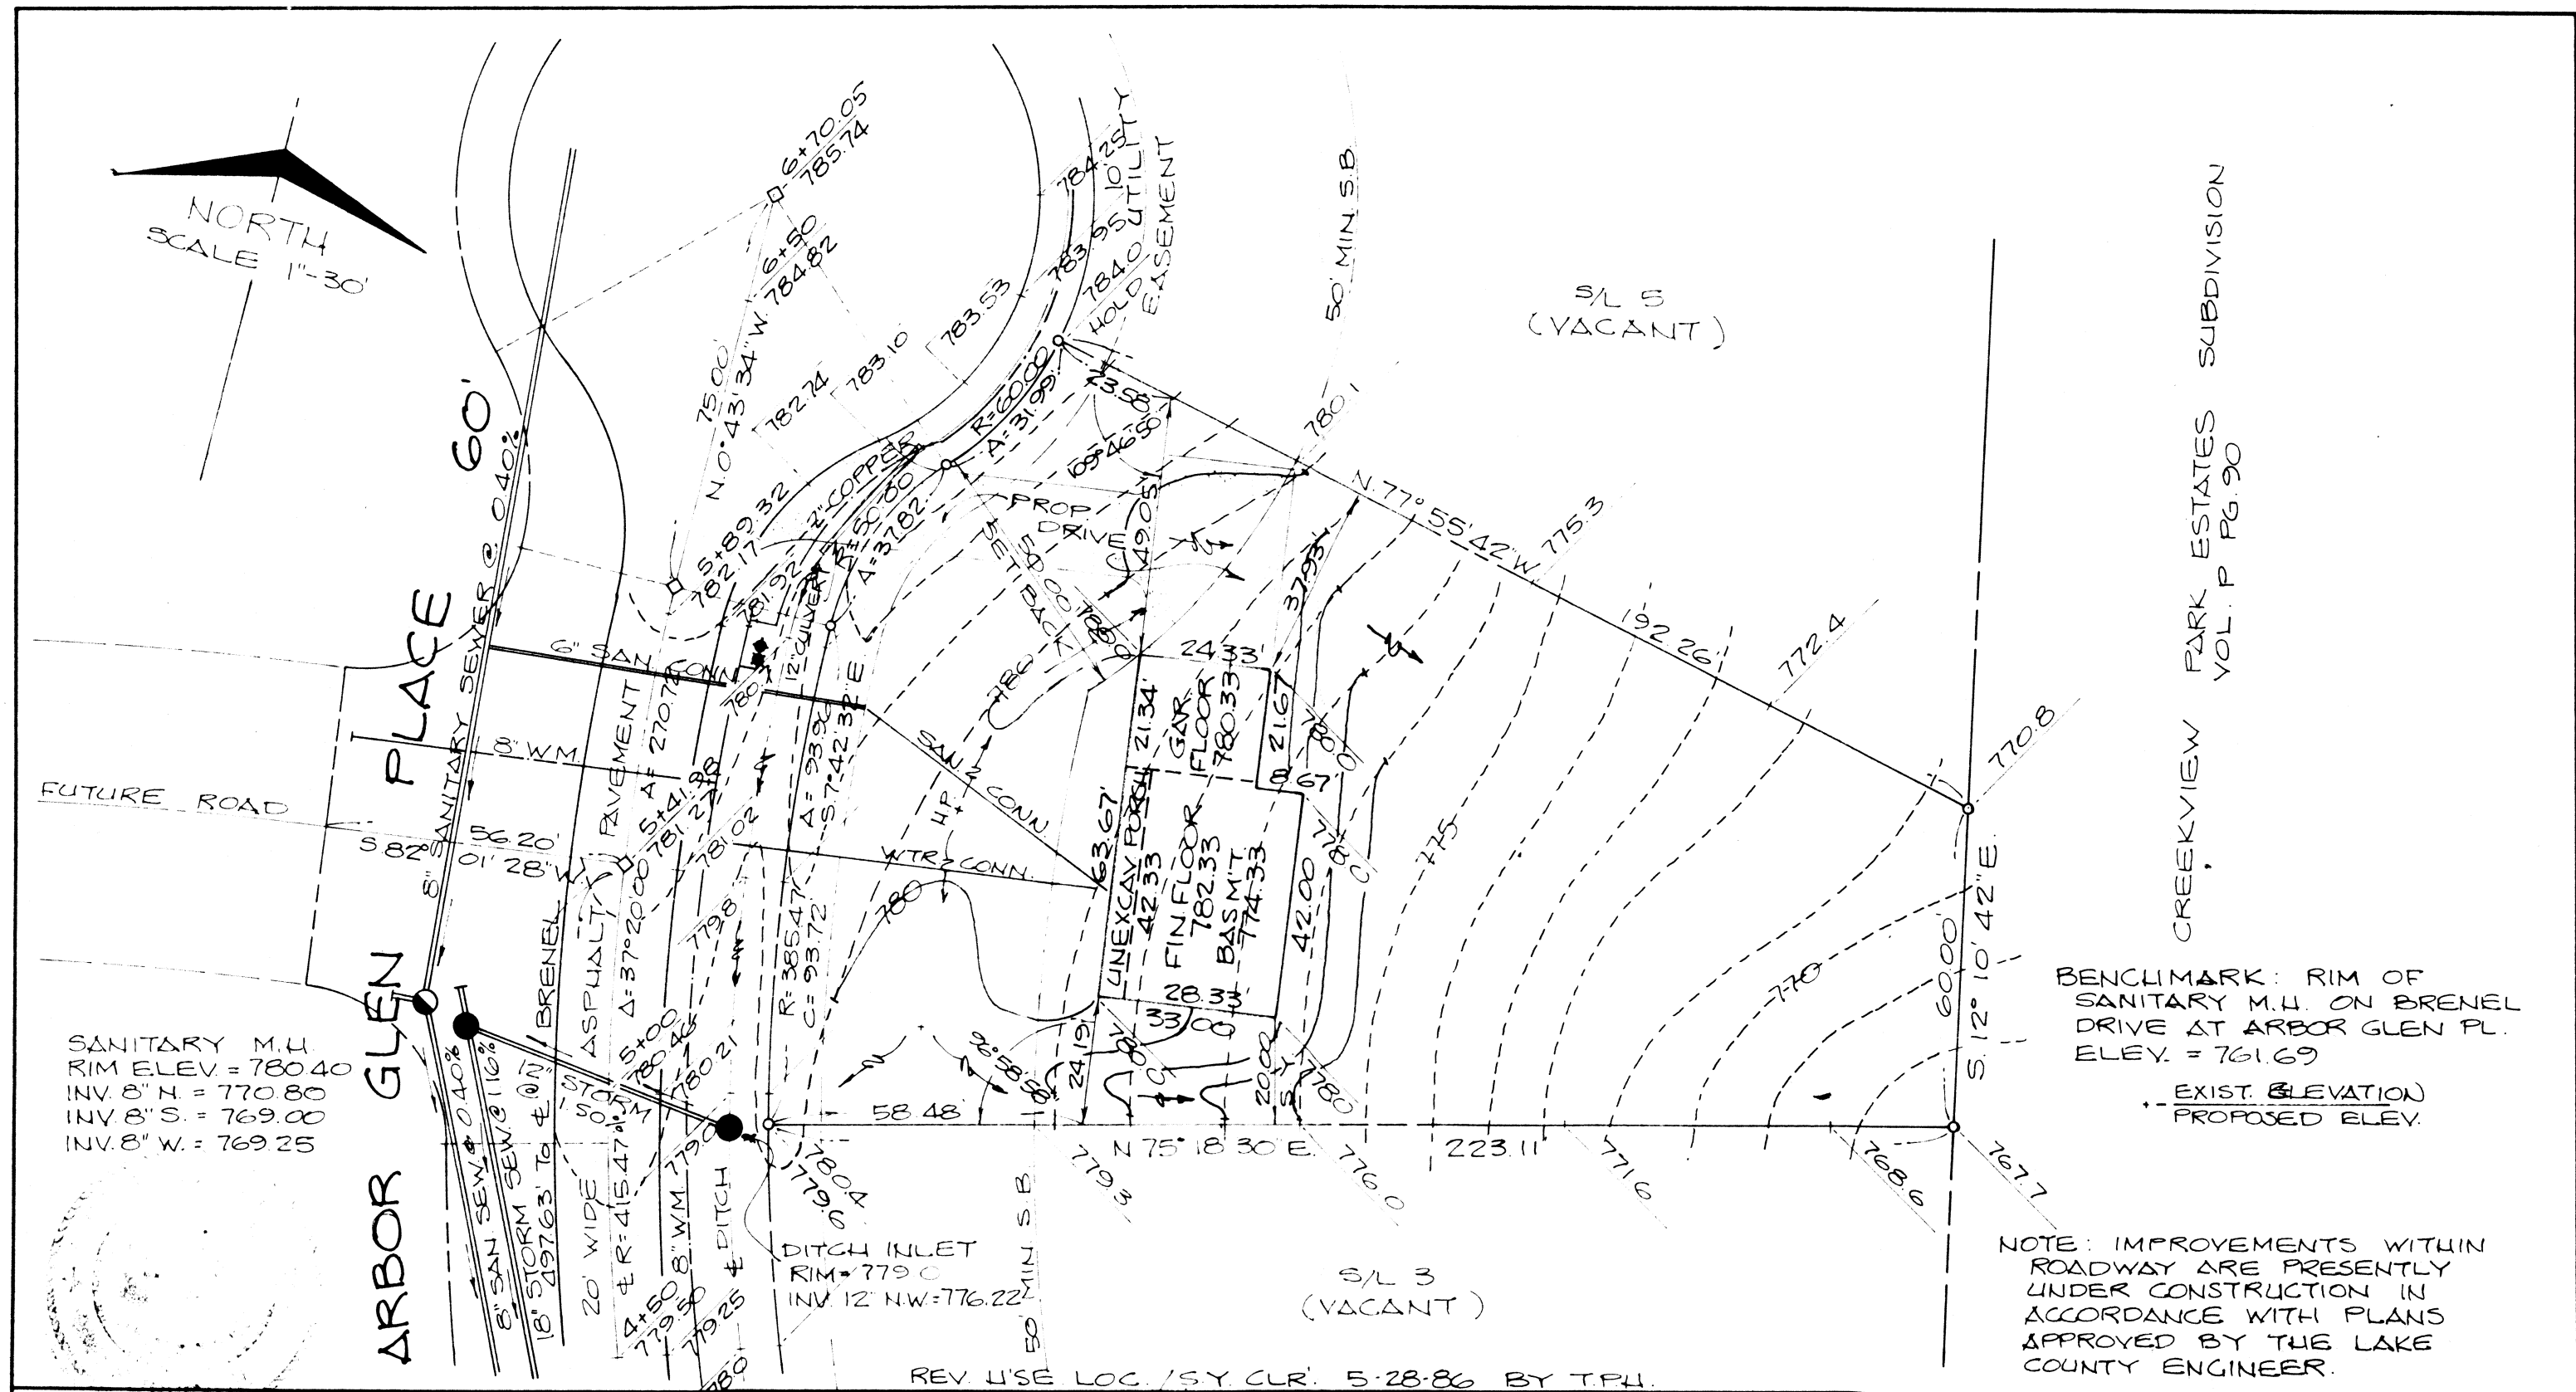

DESIGN CERTIFICATION THIS PLAT WAS PREPARED BY ME, AND IS CORRECT TO THE BEST OF MY KNOWLEDGE AND BELIEF <i>Timothy P. Hadden</i> REG. SURVEYOR NO. 6786	AS BUILT CERTIFICATION I HEREBY CERTIFY THAT THE CIRCLED GRADES ARE EXISTING FINISH GRADES CHECKED IN THE FIELD ON _____ AND THAT SURVEY IS CORRECT TO THE BEST OF MY KNOWLEDGE AND BELIEF REG. SURVEYOR NO. _____	COLPETZER · WOODS CONSULTANTS, INC. 9470 MENTOR AVENUE • MENTOR, OHIO 44060 • (216) 357-7569	DATE MAY 13, 1986 SCALE 1"=30' DRAWN BY T.P.H. CHKD BY _____ JOB NO. 85-820 FB 514 PG 40	SITE PLAN FOR MR. & MRS. RONALD M. ZIESKE SUBLOT No. 4 - ARBOR GLEN SUBD. CONCORD TWP. - LAKE COUNTY - OHIO
---	--	---	--	---

NORTH
SCALE 1"=30'

ZONING PERMIT #5220

ISSUED 5-14-86


SUBJECT TO APPROVAL BY:
Lake County Sanitary Eng. ☐
Lake County Eng. Dept. ☒
Lake County Planning Comm. ☐
Lake County Bldg. Dept. ☒

Teno S. Marano


CREEKVIEW PARK ESTATES SUBDIVISION
VOL. P PG. 90

Grading Plan Approved
as shown and noted
THOMAS P. COLPETZER, P.E.
Lake County Engineer

By  Date 5-15-86

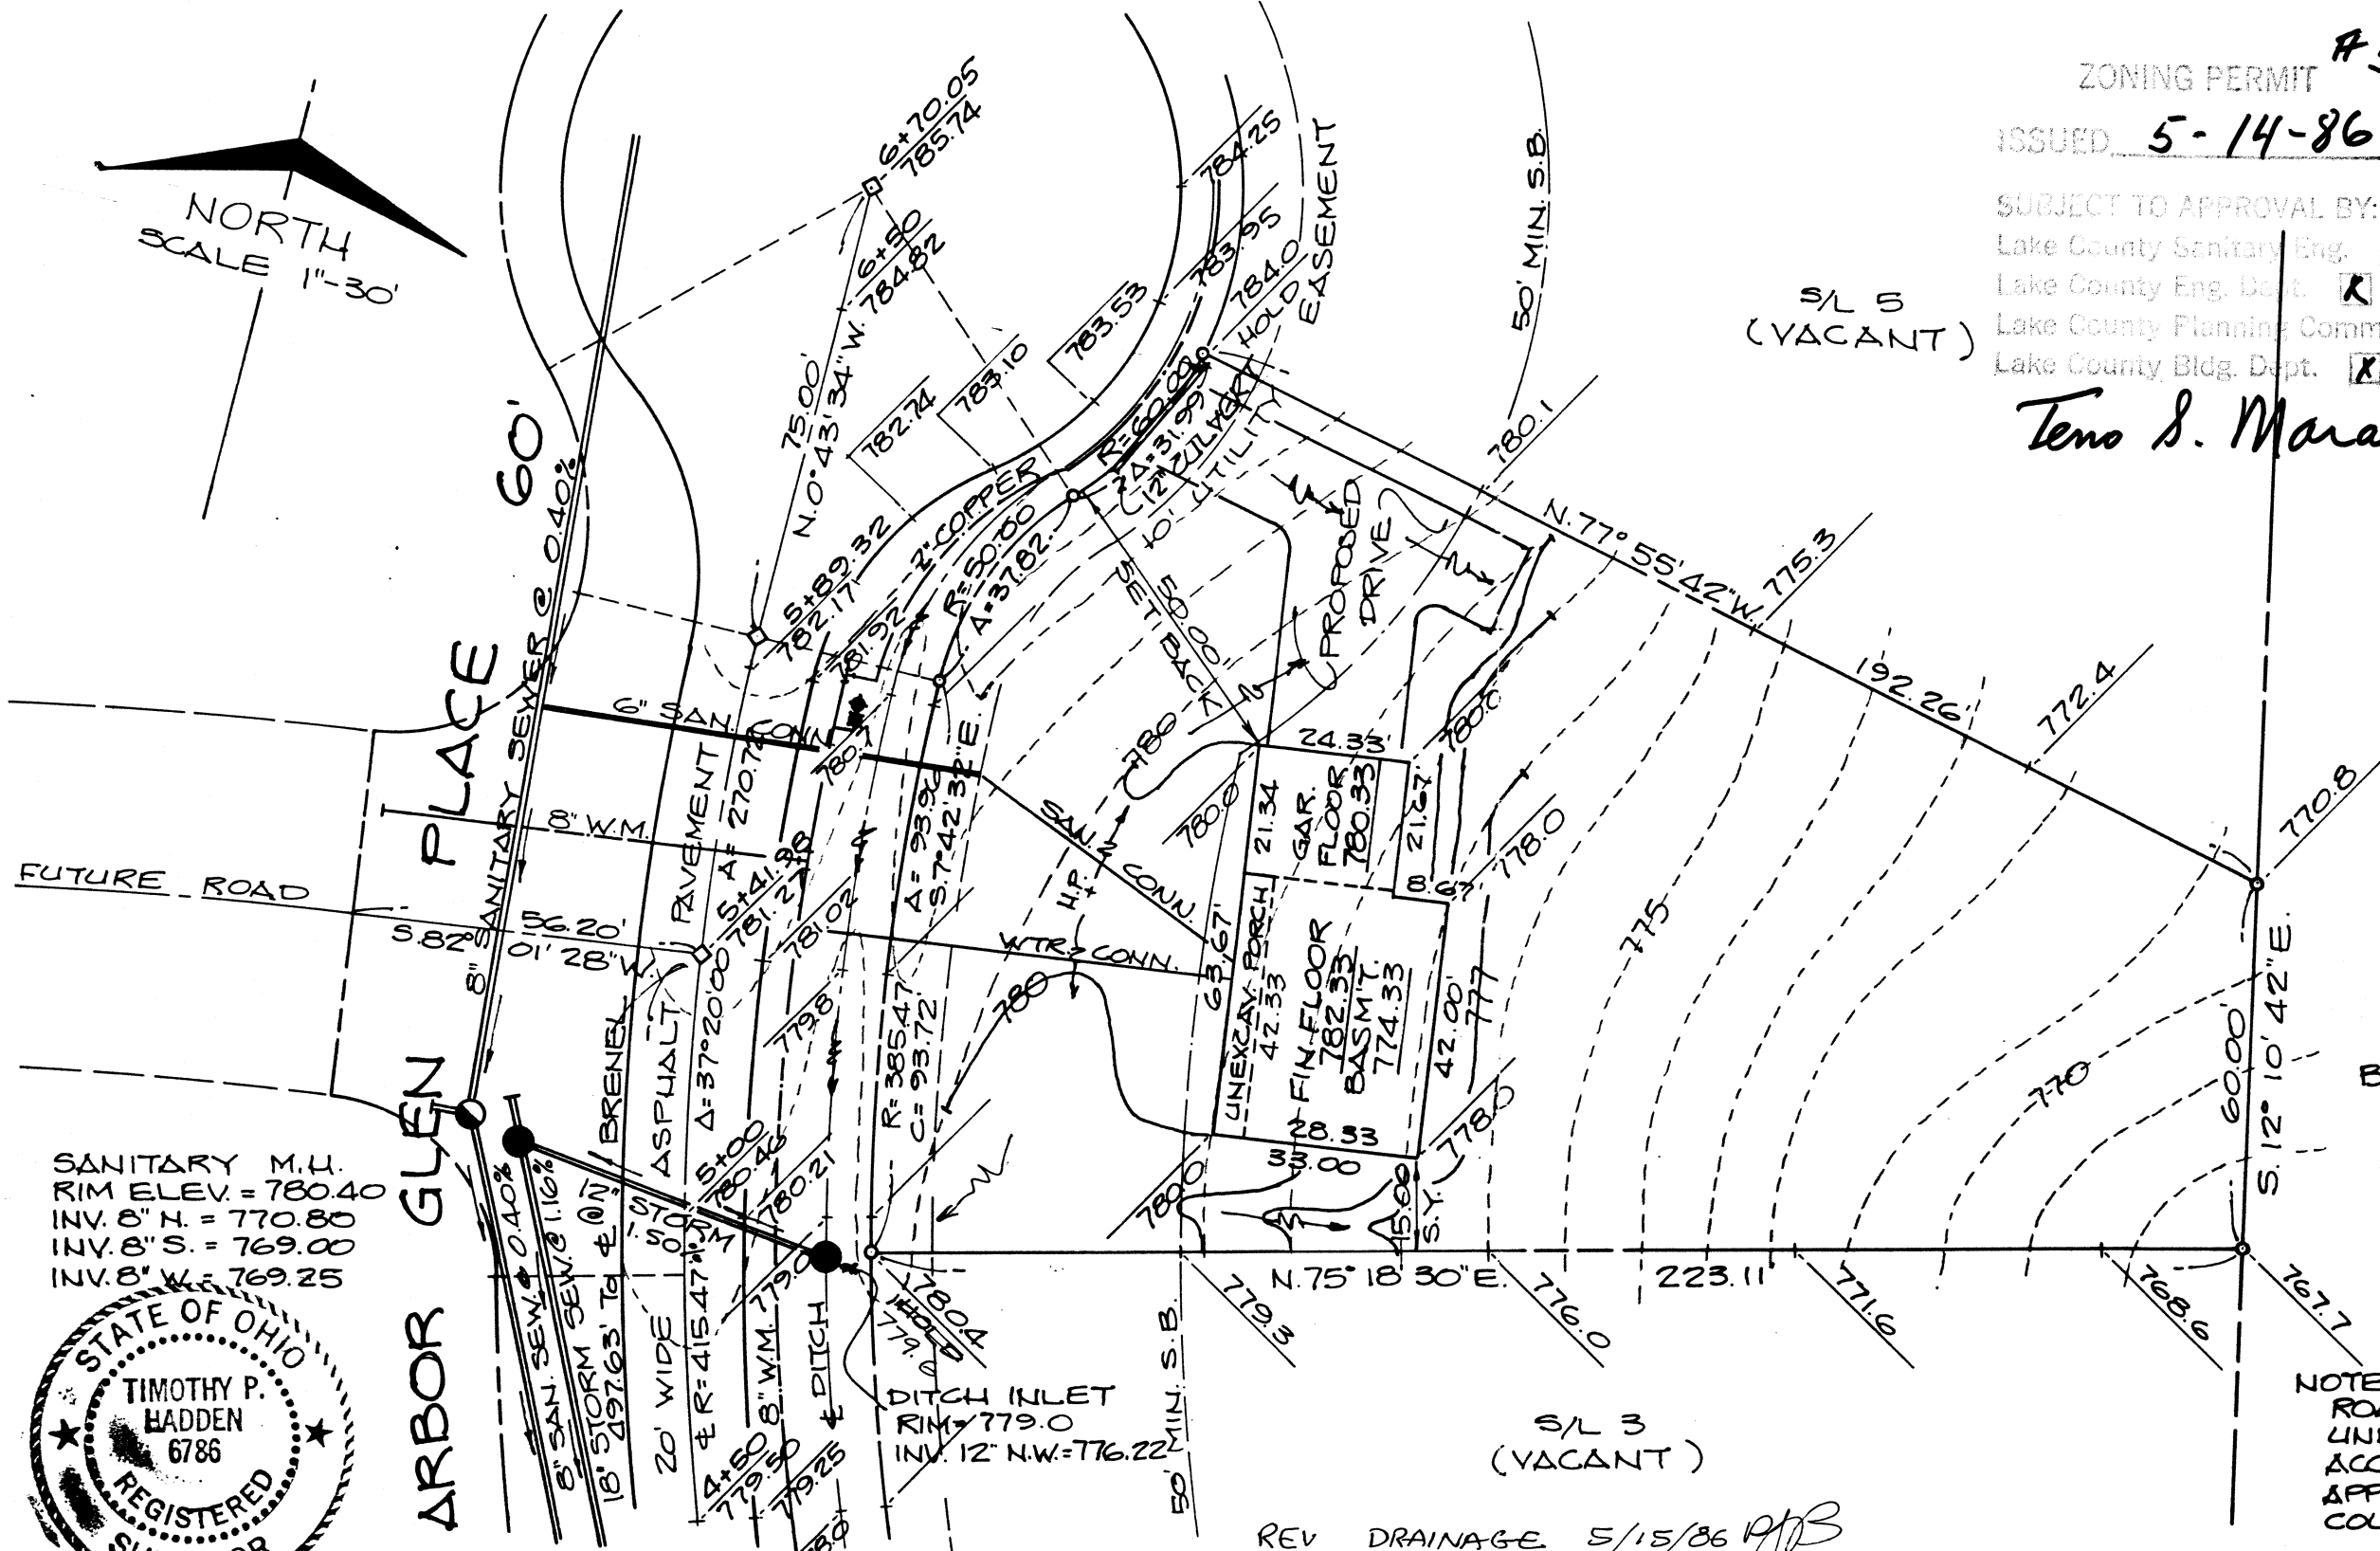

SANITARY M.H.
RIM ELEV. = 780.40
INV. 8" N. = 770.80
INV. 8" S. = 769.00
INV. 8" W. = 769.25

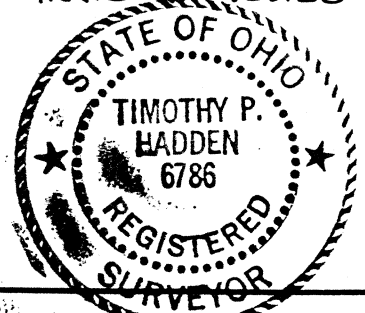

BENCHMARK: RIM OF
SANITARY M.H. ON BRENEL
DRIVE AT ARBOR GLEN PL.
ELEV. = 761.69

--- EXIST. ELEVATION
--- PROPOSED ELEV.

NOTE: IMPROVEMENTS WITHIN
ROADWAY ARE PRESENTLY
UNDER CONSTRUCTION IN
ACCORDANCE WITH PLANS
APPROVED BY THE LAKE
COUNTY ENGINEER.

REV DRAINAGE 5/15/86 

DESIGN CERTIFICATION
THIS PLAT WAS PREPARED BY ME,
AND IS CORRECT TO THE BEST OF
MY KNOWLEDGE AND BELIEF.

Timothy P. Hadden
REG. SURVEYOR NO. 6786

AS BUILT CERTIFICATION
I HEREBY CERTIFY THAT THE CIRCLED GRADES
ARE EXISTING FINISH GRADES CHECKED IN THE
FIELD ON _____ AND THAT
SURVEY IS CORRECT TO THE BEST OF MY
KNOWLEDGE AND BELIEF.

REG. SURVEYOR NO. _____



COLPETZER · WOODS
CONSULTANTS, INC.

9470 MENTOR AVENUE • MENTOR, OHIO 44060 • (216) 357-7569

DATE MAY 13, 1986
SCALE 1"=30'
DRWN BY T.P.H.
CHKD BY _____
JOB NO. 85-820
FB 514 PG 40

SITE PLAN
FOR
MR & MRS. RONALD M. ZIESKE
SUBLOT No. 4 - ARBOR GLEN SUBD.
CONCORD TWP. - LAKE COUNTY - OHIO