


CERTIFICATION
 PLAT WAS PREPARED BY ME
 S. CORRECTED TO THE BEST OF
 MY KNOWLEDGE AND BELIEF
 5244
 5244

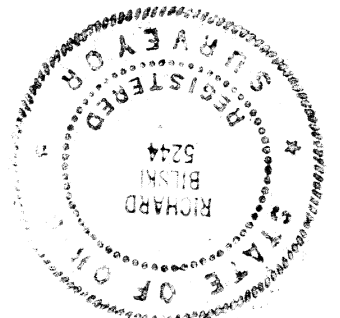


Revised House Location 7.10.81 PLS
 5244

COLPETZER-THOMAS, INC.
 AN ENGINEERING GROUP
 WILLOUGHBY • MENTOR • NORTH CANTON • STEUBENVILLE • LORAIN

DATE 7-22-87
 SCALE 1"=20'
 DRAWN BY RLS
 CHECKED BY
 F.B. # 514 PG. 1

SITE PLAN FOR SCOTT ANDREWS
 BEING, SUBDIVISION OF ARBOR GREEN SUBDIVISION PHASE
 DONOR'S TOWNSHIP, ARE COUNTY, OHIO

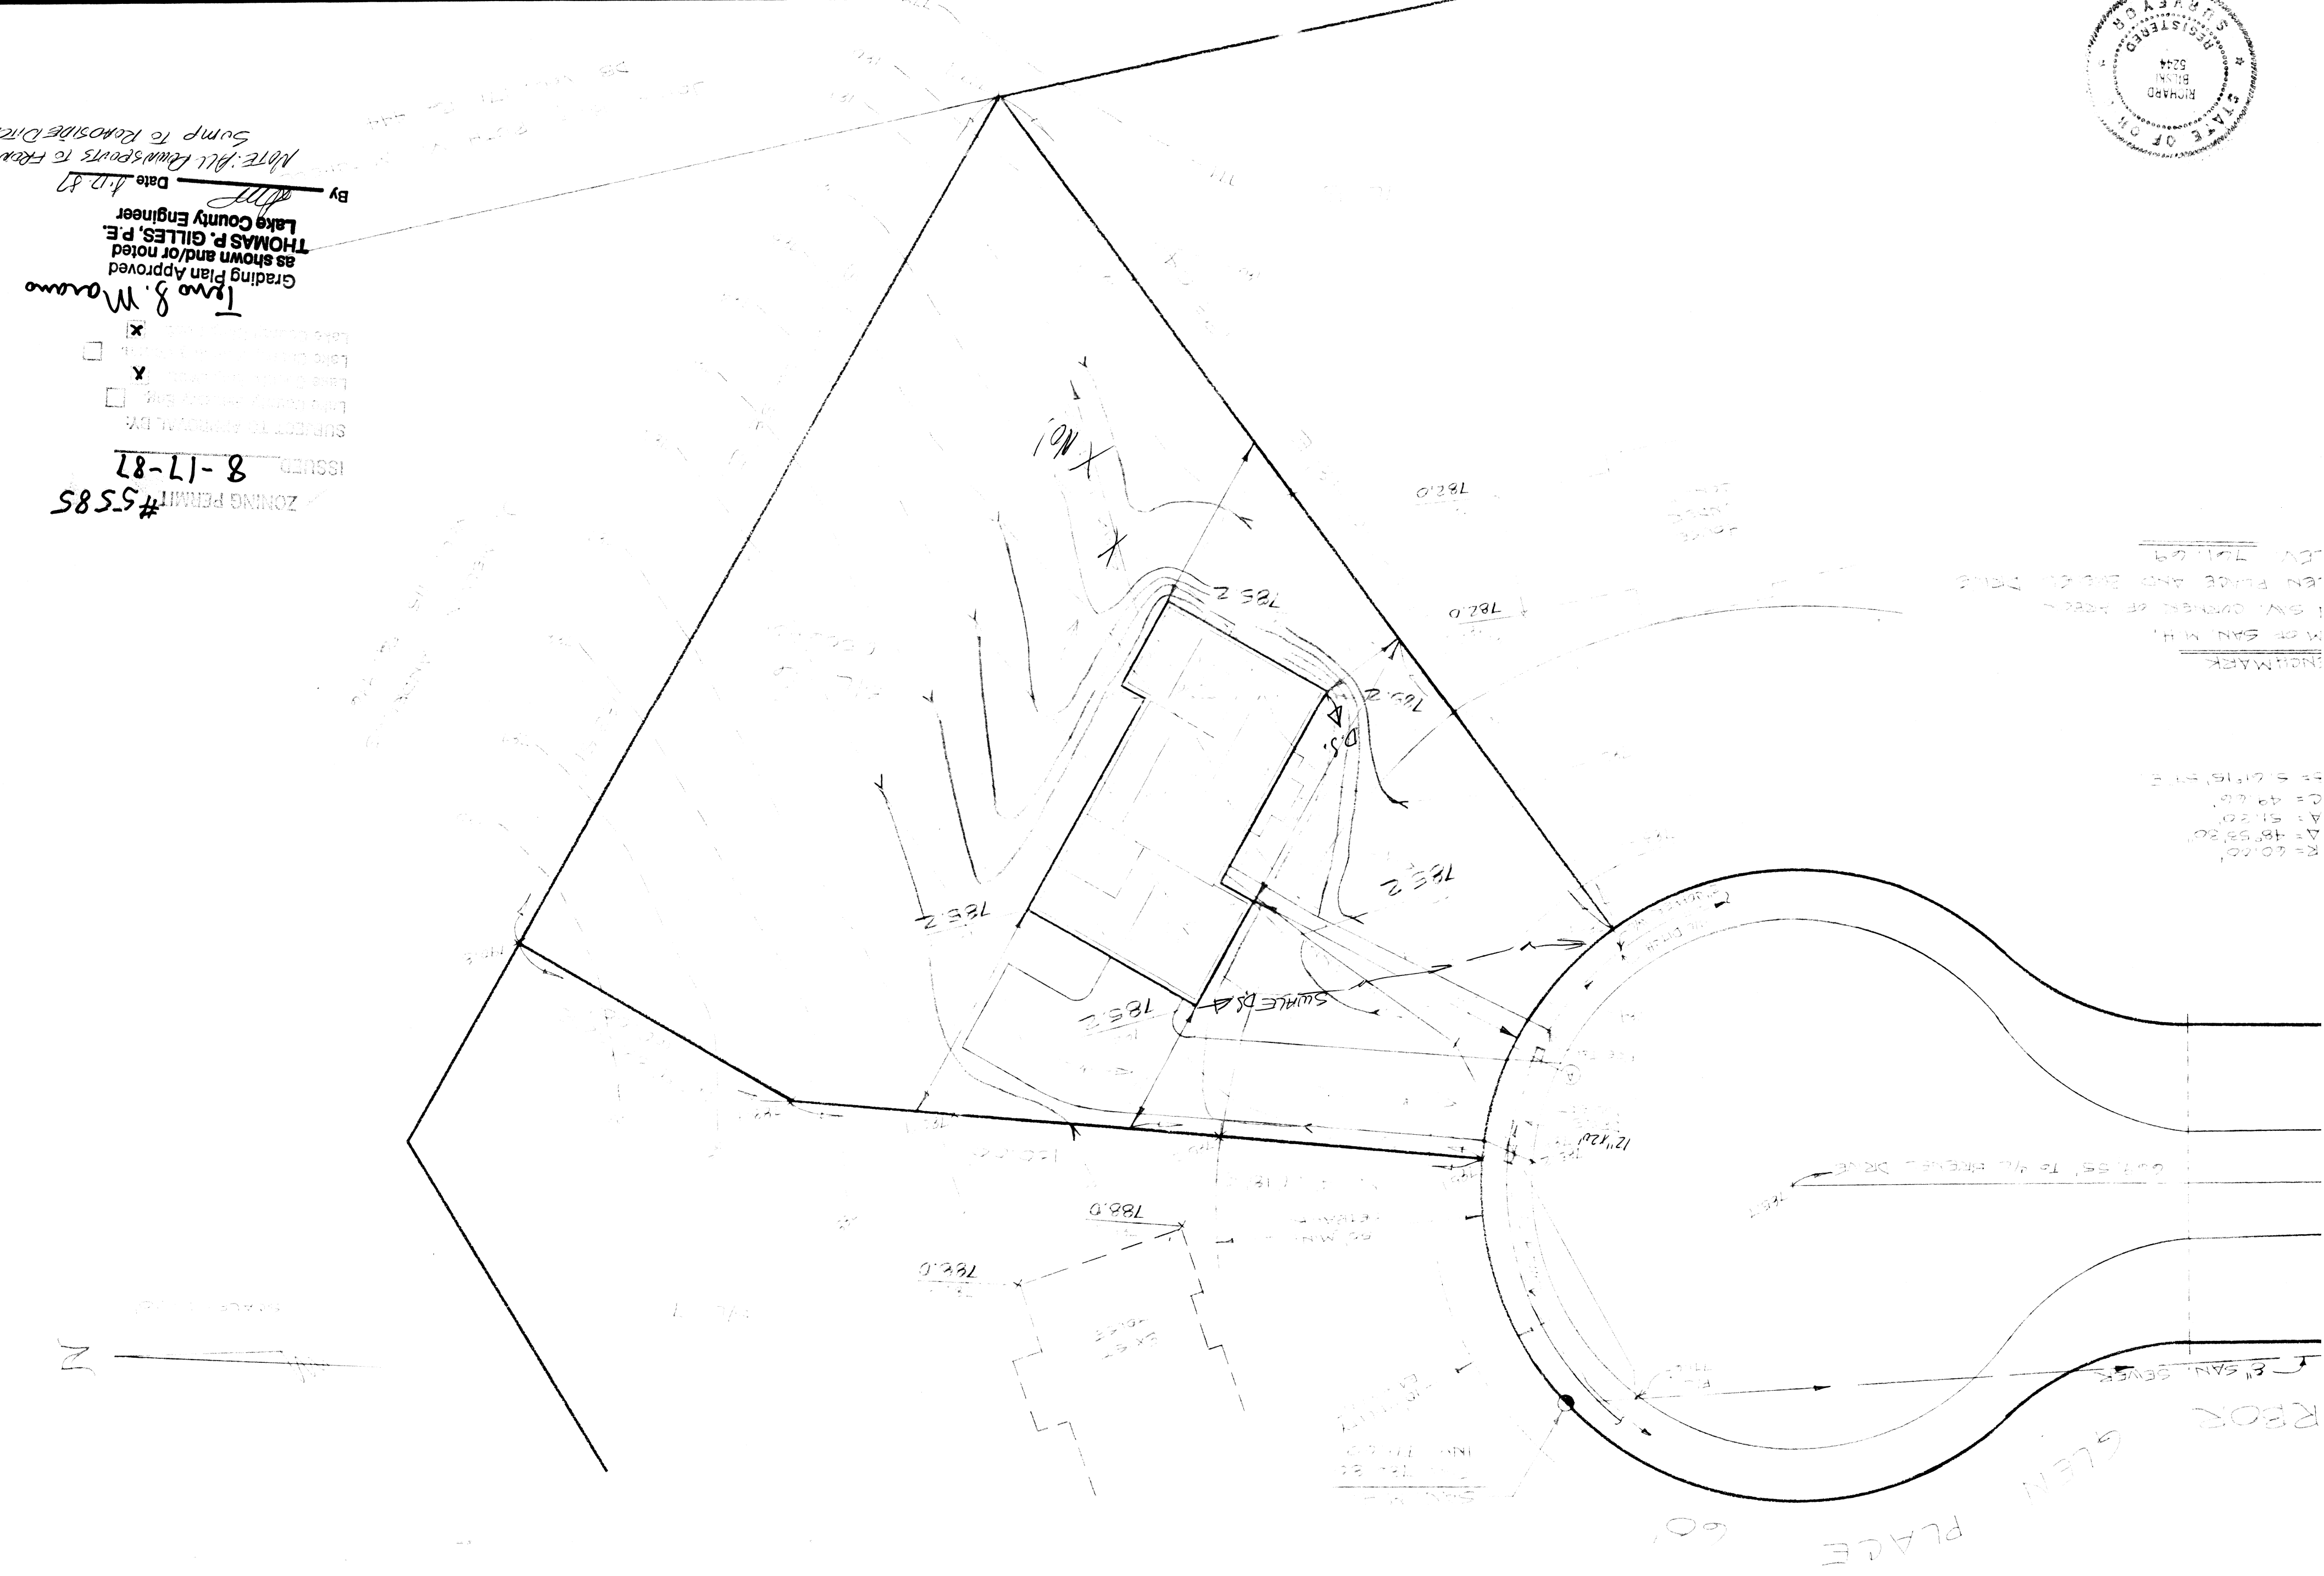

ZONING PERMIT #5585
 ISSUED 8-17-87
 SUBJECT TO APPROVAL BY:
☐ Lake County Health Dept.
☒ Lake County Engineering Dept.
☒ Lake County Planning Dept.
☐ Lake County Public Works Dept.
 Grading Plan Approved
 as shown and/or noted
THOMAS P. GILLES, P.E.
 Lake County Engineer
 By *[Signature]* Date 7.12.87
 Note: All Easements to Remain
 Sump to Remains Driv.