


BENCHMARK
RIM SAN. M.H.
@ S.W. CORNER OF
ARBOR GLEN PLACE AND BRENEL DRIVE
ELEV. 761.69

EXIST. ELEV.
PROG. ELEV.

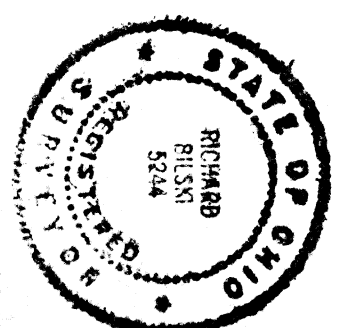


CERTIFICATION
THIS PLAN WAS PREPARED BY ME
AND IS CORRECT TO THE BEST OF
MY KNOWLEDGE AND BELIEF
[Signature]
REG. NO. 5244

SITE PLAN FOR SCOTT ANDREWS
BEING S/L 10 OF ARBOR GLEN SUBDIVISION PHASE I
CONCORD TOWNSHIP, LAKE COUNTY, OHIO

DATE 6-5-86
SCALE 1"=20'
DRAWN BY RLS
CHECKED BY JLS
FBI 514 R. 41

COLPETZER WOODS
CONSULTANTS, INC.
MENTOR, OHIO 44060

SHEET 1 OF 1
CONTRACT NO. 85-820-010

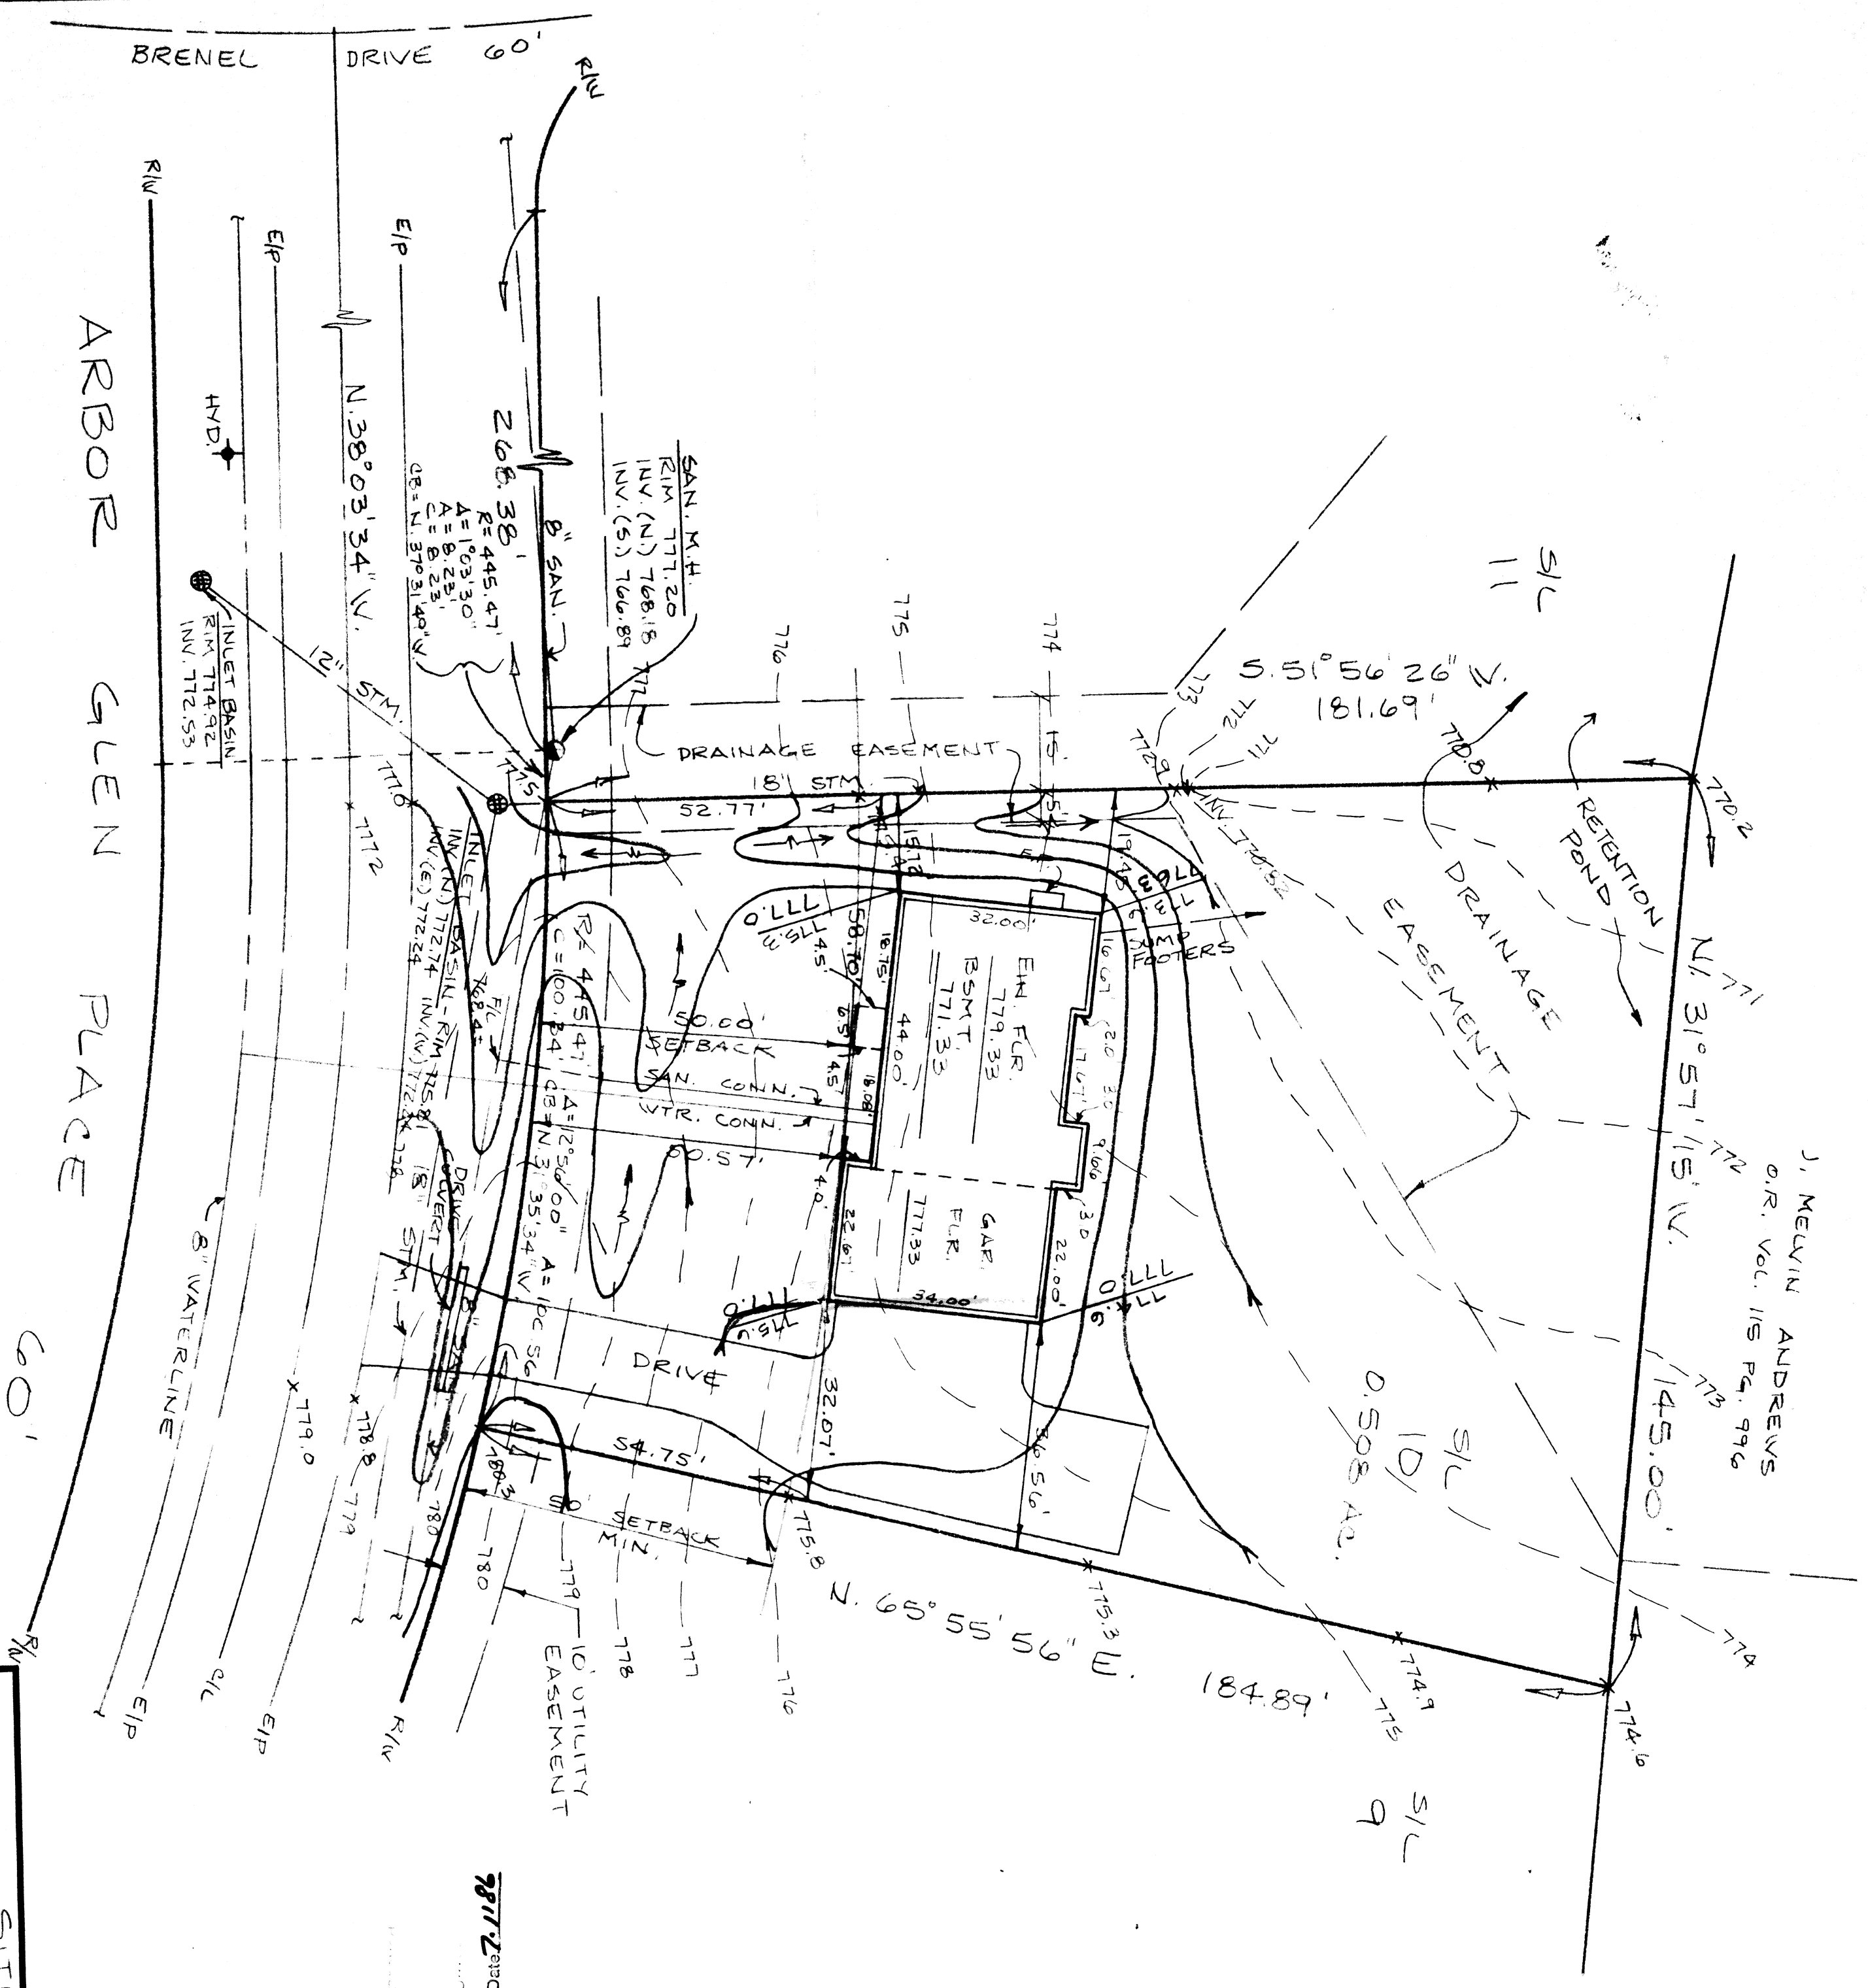

SCALE: 1"=20'

78112 Date
THOMAS P. C...
Lake County Eng...
as shown & changed by
78112
Taw A. Marino

ZONING PERMIT #5253
ISSUED 6-16-86

SUBJECT TO APPROVAL BY:
Lake County Engineer ☒
Lake County Auditor ☒
Lake County Board of Health ☒
Lake County Board of Zoning Appeals ☒
Lake County Board of Public Works ☒
Lake County Board of Education ☒
Lake County Board of Mental Health ☒
Lake County Board of Social Services ☒
Lake County Board of Children's Services ☒
Lake County Board of Adult Services ☒
Lake County Board of Senior Services ☒
Lake County Board of Community Development ☒
Lake County Board of Economic Development ☒
Lake County Board of Environmental Services ☒
Lake County Board of Fire Services ☒
Lake County Board of Police Services ☒
Lake County Board of Public Safety ☒
Lake County Board of Public Works ☒
Lake County Board of Public Utilities ☒
Lake County Board of Public Health ☒
Lake County Board of Public Welfare ☒
Lake County Board of Public Safety ☒
Lake County Board of Public Works ☒
Lake County Board of Public Utilities ☒
Lake County Board of Public Health ☒
Lake County Board of Public Welfare ☒