

SCALE: 1" = 20'

EXIST. ELEV.
PROP. ELEV.

Tom A. Maram

RECORD # 5162
ISSUED 3-20-86

SUBJECT TO BE REVIEWED BY:
☐ Lake County Engineer
☐ Lake County Dept. of Public Works
☐ Lake County Planning Comm.
☐ Lake County Dept. of Public Works

Grading Plan Approved
 as shown and/or noted
 THOMAS P. GILLES, P.E.
 Lake County Engineer

CERTIFICATION
 THIS PLAN WAS PREPARED BY ME
 AND IS CORRECT TO THE BEST OF
 MY KNOWLEDGE AND BELIEF
 REG. SURVEYOR NO. 5244

SITE PLAN FOR SCOTT ANDREWS

BEING PARCEL 1 OF AREBOR GLEN SUBDIVISION
 PHASE I, PLAT 5 PG. 401
 TOWNSHIP OF CONCORD, LAKE COUNTY, OHIO


COLPETZER & WOODS
 CONSULTANTS, INC.
 MENTOR, OHIO 44060

DATE 3-6-86
 SCALE 1" = 20'
 DRAWN BY ELS
 CKD BY J.S.D. No. 65

(A) - E = 30.00'
 Δ = 81°19'46"
 A = 42.58'
 C = 31.10'
 CB = N. 78°43'26"W.

(B) - R = 368.00'
 Δ = 9°04'06"
 A = 58.18'
 C = 58.72'
 CB = S. 65°11'14"W.

AREBOR GLEN SUBDIVISION
 PHASE I
 PLAT 5 PG. 401

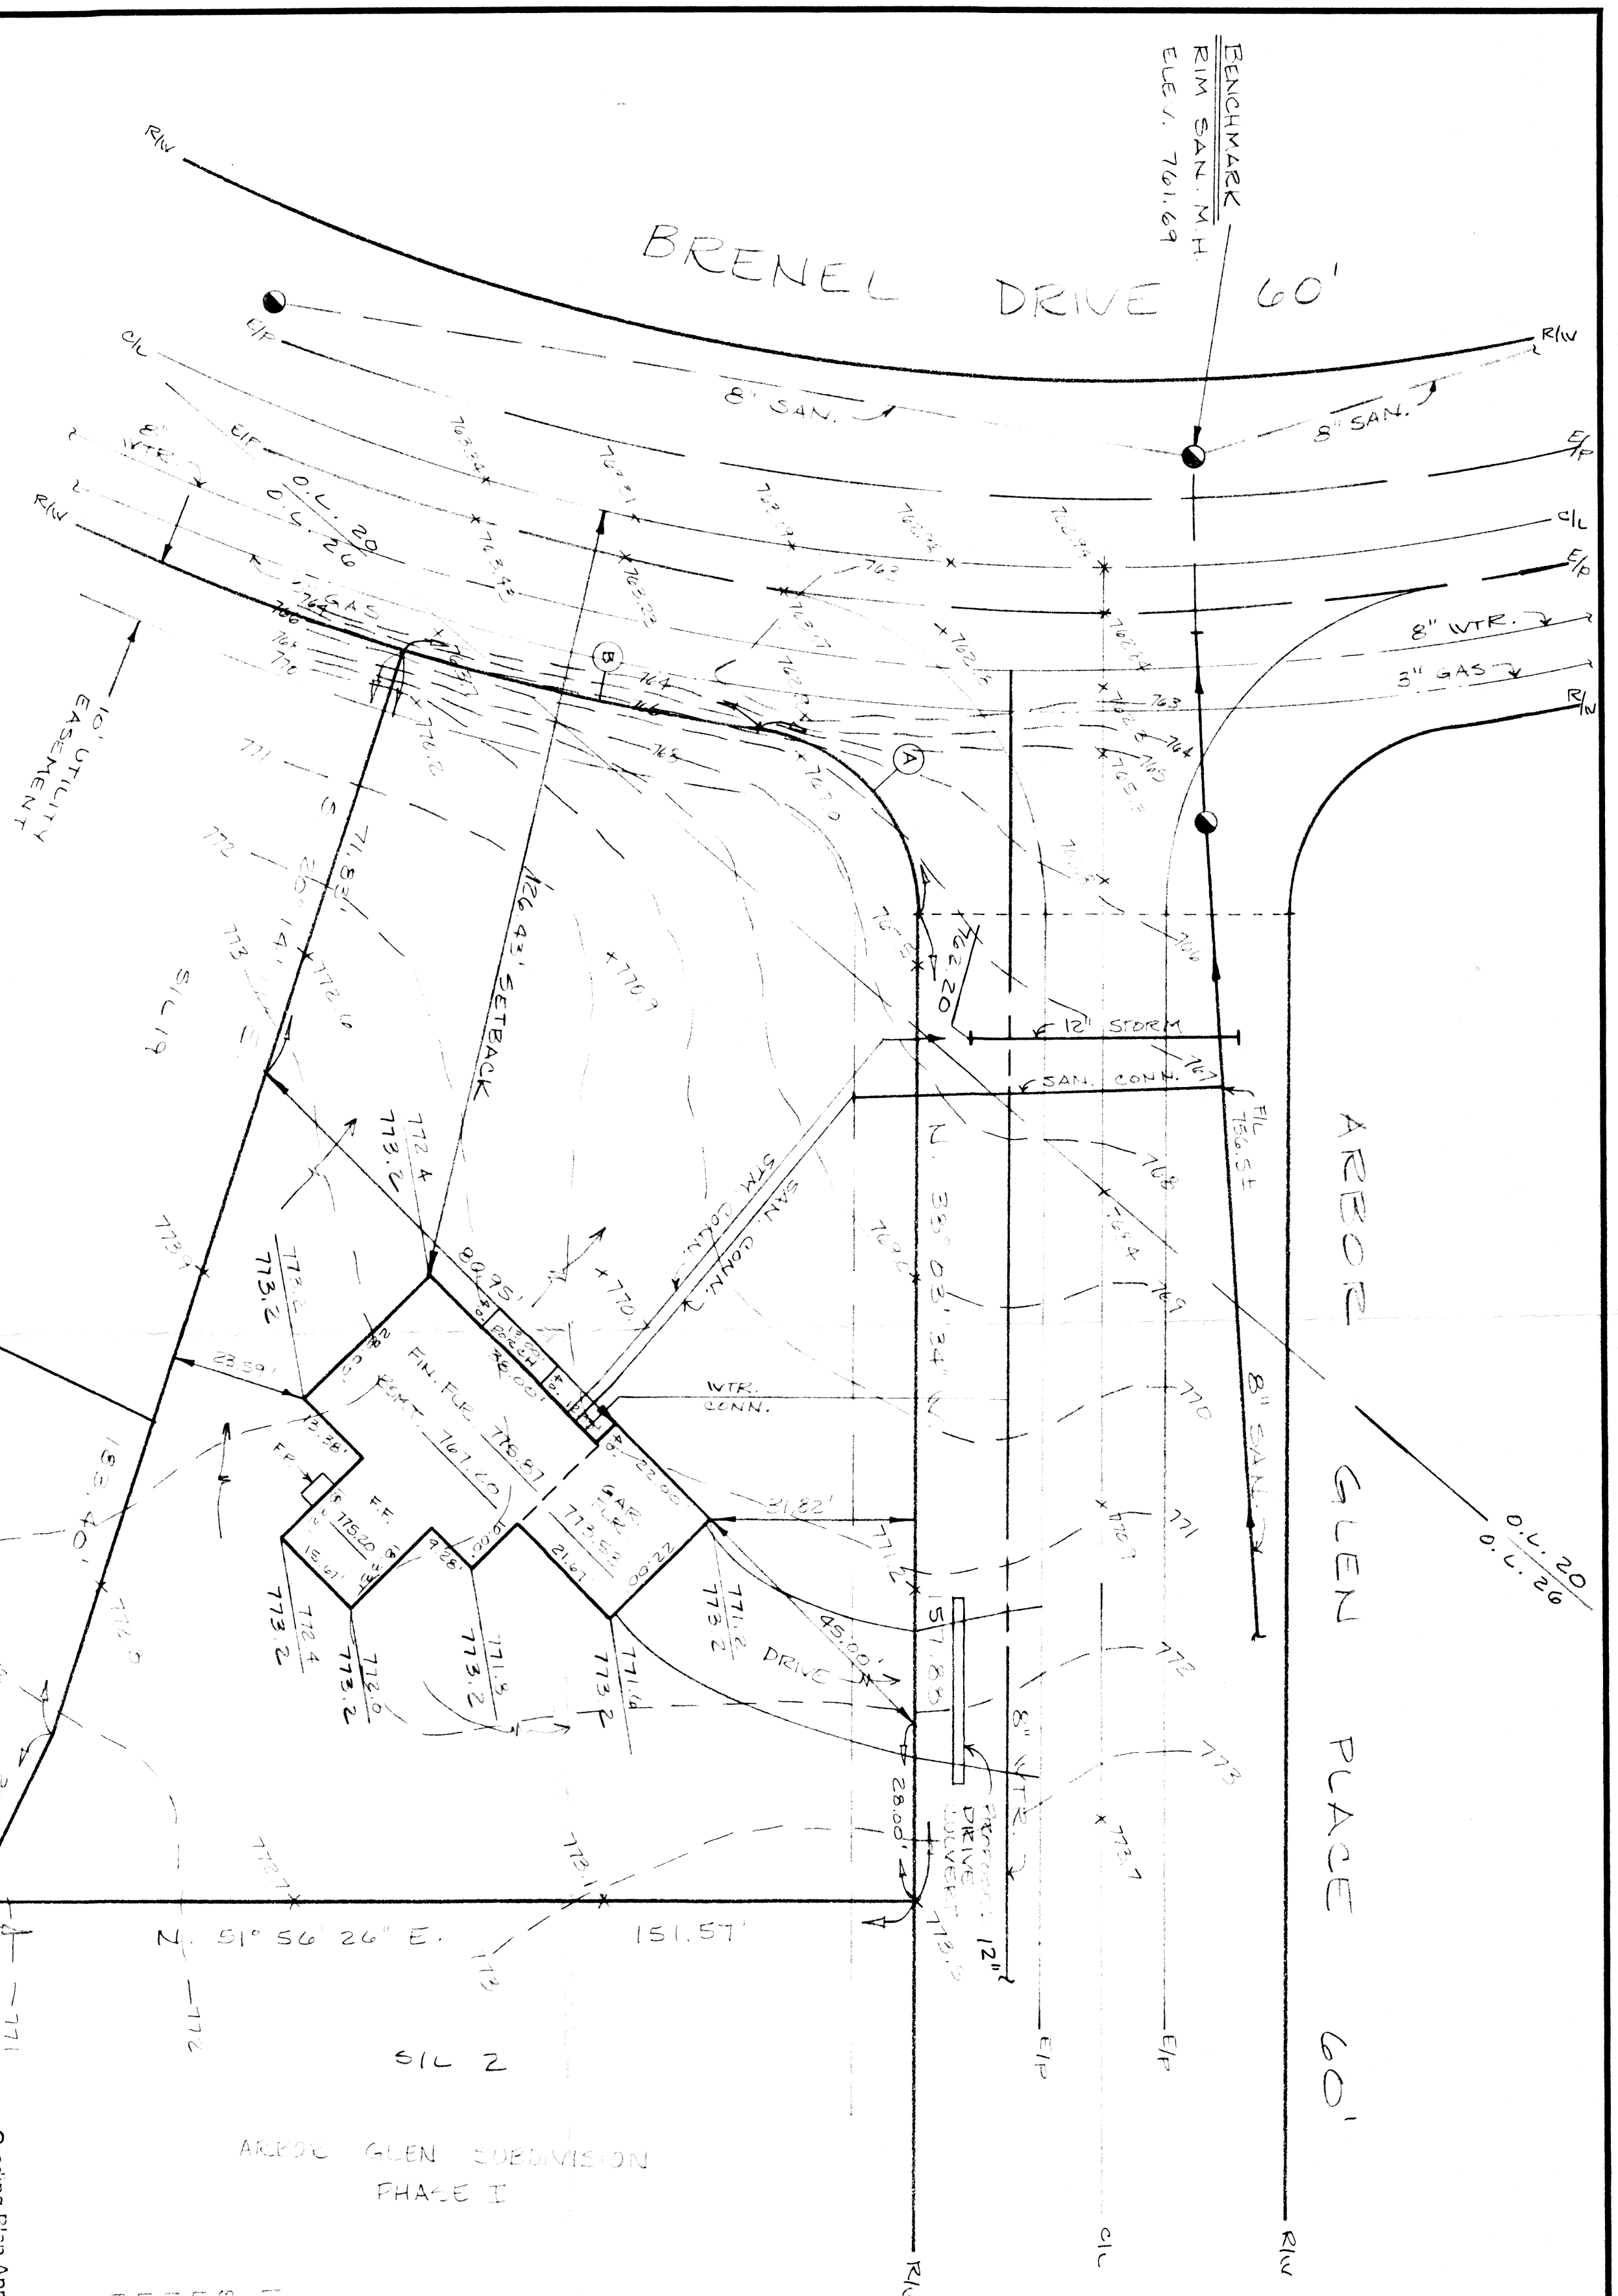

BRENEL DRIVE 60'

AREBOR GLEN PLACE 60'

BENCHMARK
 RIM SAN. M.H.
 ELEV. 761.69