

ZONING PERMIT #5600
ISSUED 8-17-87

SUBJECT TO APPROVAL BY:

- Lake County Surveying Eng. ☐
Lake County Eng. Dept. ☒
Lake County Planning Comm. ☐
Lake County Bldg. Dept. ☒


Timothy P. Hadden

CURVE
A R=30.00'
Δ=54°35'52"
A=28.59'
C=27.52'
S. 26°34'22" N,
S. 22°23'49" E.

DATA
B R=50.00'
Δ=42°20'30"
A=37.62'
C=36.43'
S. 22°23'49" E.

C R=60.00'
Δ=29°27'52"
A=43.69'
C=34.46'
S. 0°39'52" E.

NOTE:
IMPROVEMENTS SHOWN HEREON ARE
UNDER CONSTRUCTION ACCORDING
TO PLANS APPROVED BY THE
LAKE COUNTY ENGINEER.

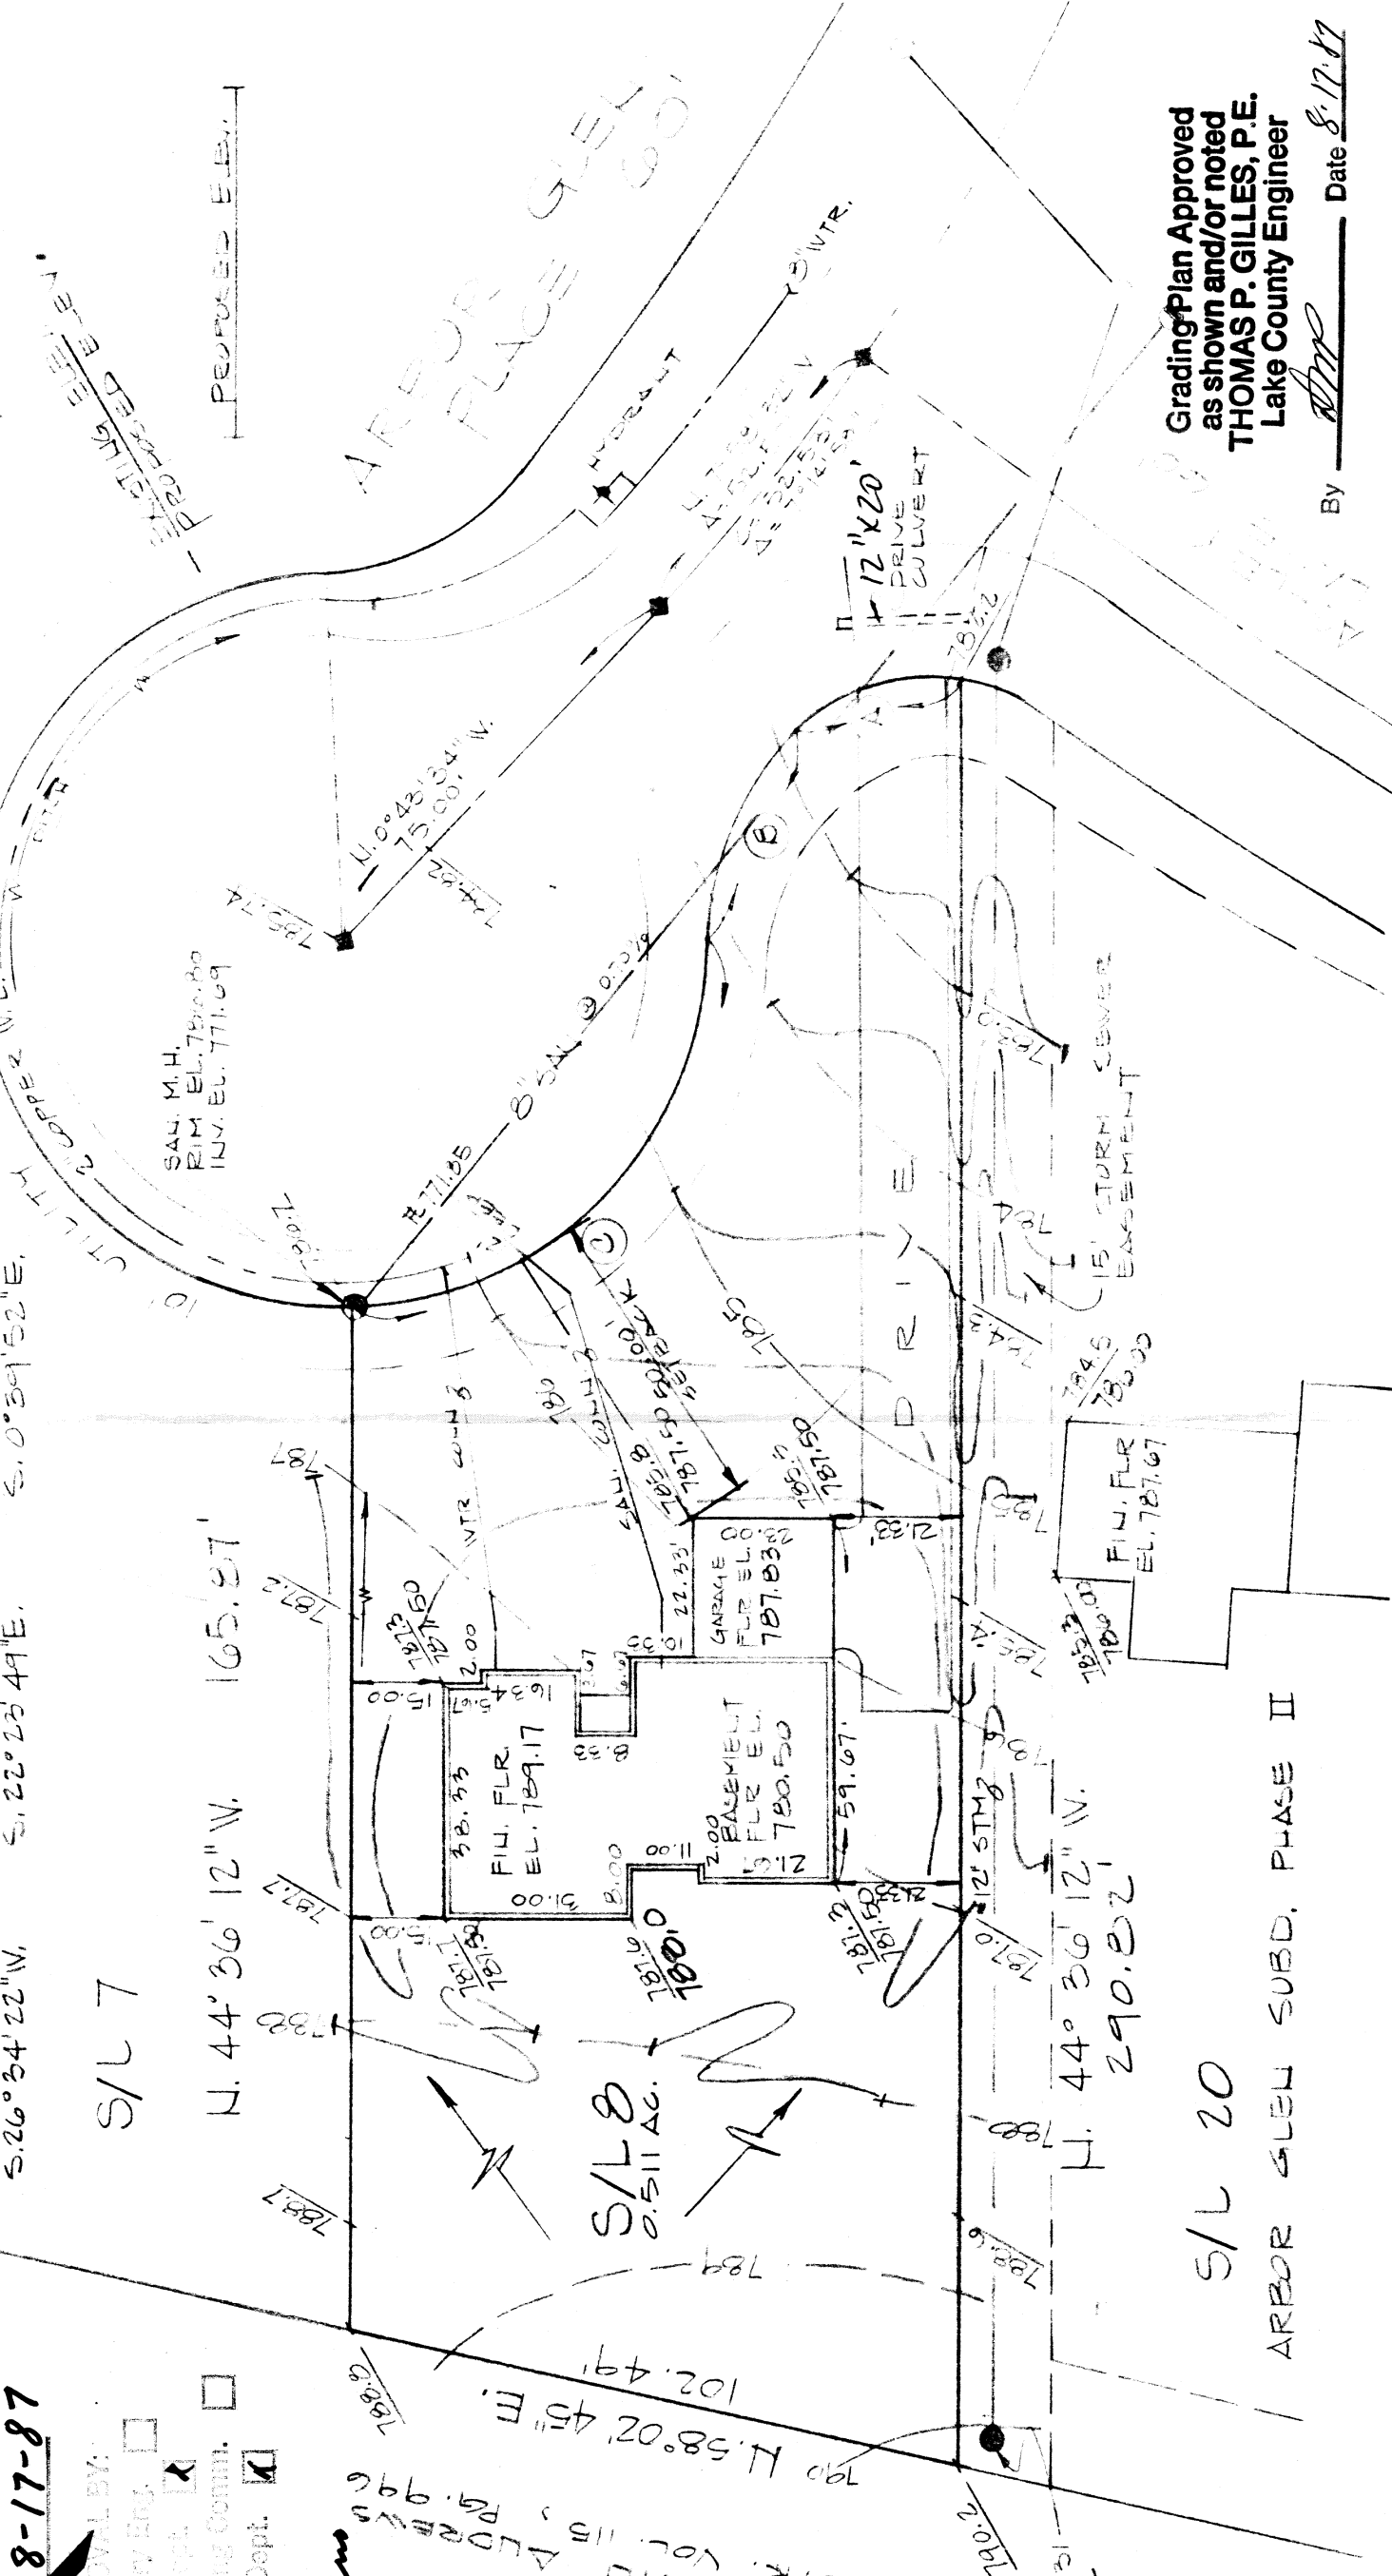

Grading Plan Approved
as shown and/or noted
THOMAS P. GILLES, P.E.
Lake County Engineer

By *THP* Date 8-17-87

DESIGN CERTIFICATION

THIS PLAN WAS PREPARED BY ME,
AND IS CORRECT TO THE BEST OF
MY KNOWLEDGE AND BELIEF.

Timothy P. Hadden
REG. SURVEYOR NO. 6786

AS BUILT CERTIFICATION

I HEREBY CERTIFY THAT THE CIRCLED GRADES
ARE EXISTING FINISH GRADES CHECKED IN THE
FIELD ON _____ AND THAT
SURVEY IS CORRECT TO THE BEST OF MY
KNOWLEDGE AND BELIEF.

REG. SURVEYOR NO. _____



COLPETZER & WOODS
CONSULTANTS, INC.

9470 MENTOR AVENUE • MENTOR, OHIO 44060 • (216) 357-7569

DATE 7-28-87

SCALE 1" = 30'

DRWN BY L.H.

CHKD BY

JOB NO. 87-415

FB 514 PG 45

SITE PLAN

SCOTT ANDREWS

BEING SUBLOT NO. 3 OF THE ARBOR
GLEN SUBDIVISION PHASE I, VOL. 5-40
CONCORD TOWNSHIP, LAKE COUNTY, OHIO