

DESIGN CERTIFICATION
THIS PLAN WAS PREPARED BY ME,
AND IS CORRECT TO THE BEST OF
MY KNOWLEDGE AND BELIEF.

Timothy P. Hadden
6786

REG. SURVEYOR NO. 6786

AS BUILT CERTIFICATION
I HEREBY CERTIFY THAT THE CIRCLED GRADES
ARE EXISTING FINISH GRADES CHECKED IN THE
FIELD ON
SURVEY IS CORRECT TO THE BEST OF MY
KNOWLEDGE AND BELIEF.

REG. SURVEYOR NO. _____

COLPETZER • WOODS
CONSULTANTS, INC.
9470 MENTOR AVENUE • MENTOR, OHIO 44060 • (216) 357-7569


DATE 7-24-87
SCALE 1" = 30'
DRWN BY L.H.
CHKD BY 67-415
JOB NO. 67-415
PG 514

SITE PLAN FOR SCOTT ANDREWS
BEING SUBLOT 14 OF THE ARBOR
GREEN SUBDIVISION PHASE II, LOT 26 TR 4
WILKORD TOWNSHIP, LAKE COUNTY - OHIO

VICTORIA B. VAHLBOOM
Vol. 57B, Pg. 125

N. 87° 43' 42" W.
230.39'

S/L 14

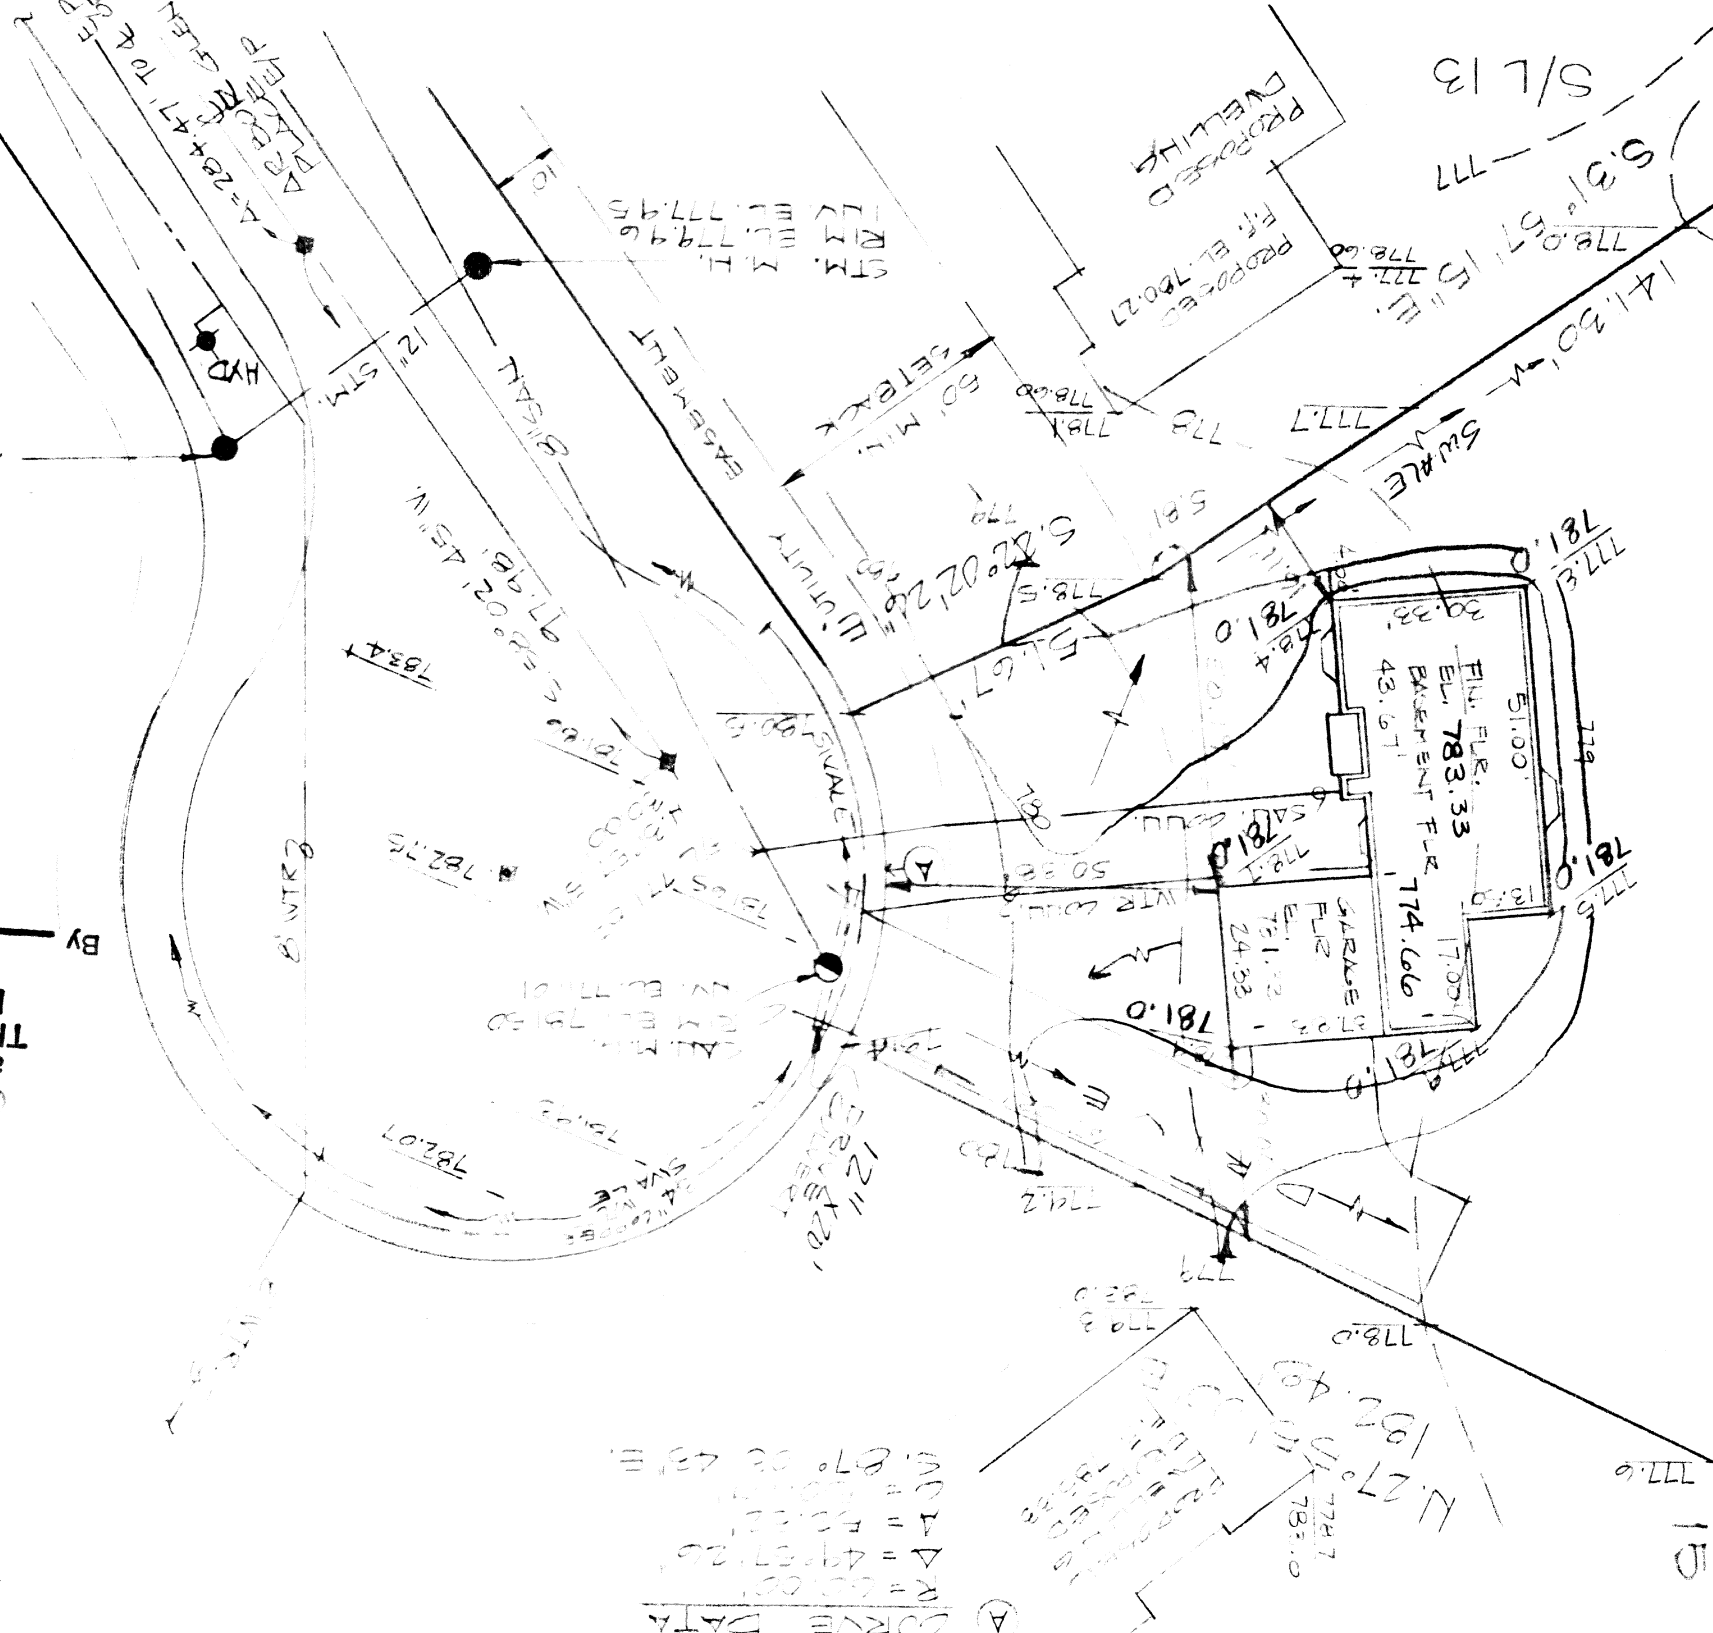

Grading Plan Approved
as shown and/or noted
THOMAS P. GILLES, P.E.
Lake County Engineer
By *[Signature]*
Date 8-17-87



#55991
ZONING PERMIT
8-17-87
ISSUED
SUBJECT TO APPROVAL BY
LAKE COUNTY ENGINEER
LAKE COUNTY ENGINEER
LAKE COUNTY ENGINEER

Tom J. Warden

CURVE DATA
R = 60.00'
Δ = 49° 57' 20"
C = 50.00'
S. 87° 02' 43" E.

NOTE:
IMPROVEMENTS SHOWN HEREON
ARE UNDER CONSTRUCTION. ADDITIONAL
TO PLANS APPROVED BY THE
LAKE COUNTY ENGINEER.
EXISTING ELEVATIONS
PROPOSED ELEVATIONS