



J. MELVIN ANDREWS, D.R. NO. 115, P.B. 996
N 58°02'35" E 161.79'

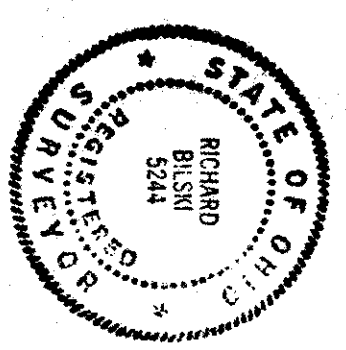

DESIGN CERTIFICATION
THIS PLAN WAS PREPARED BY ME AND IS CORRECT TO THE BEST OF MY KNOWLEDGE AND BELIEF.

AS BUILT CERTIFICATION
I HEREBY CERTIFY THAT THE CIRCLED GRADES ARE EXISTING FINISH GRADES CHECKED IN THE FIELD ON SURVEY AND THAT SURVEY IS CORRECT TO THE BEST OF MY KNOWLEDGE AND BELIEF.

ASHLEY LANE 60'

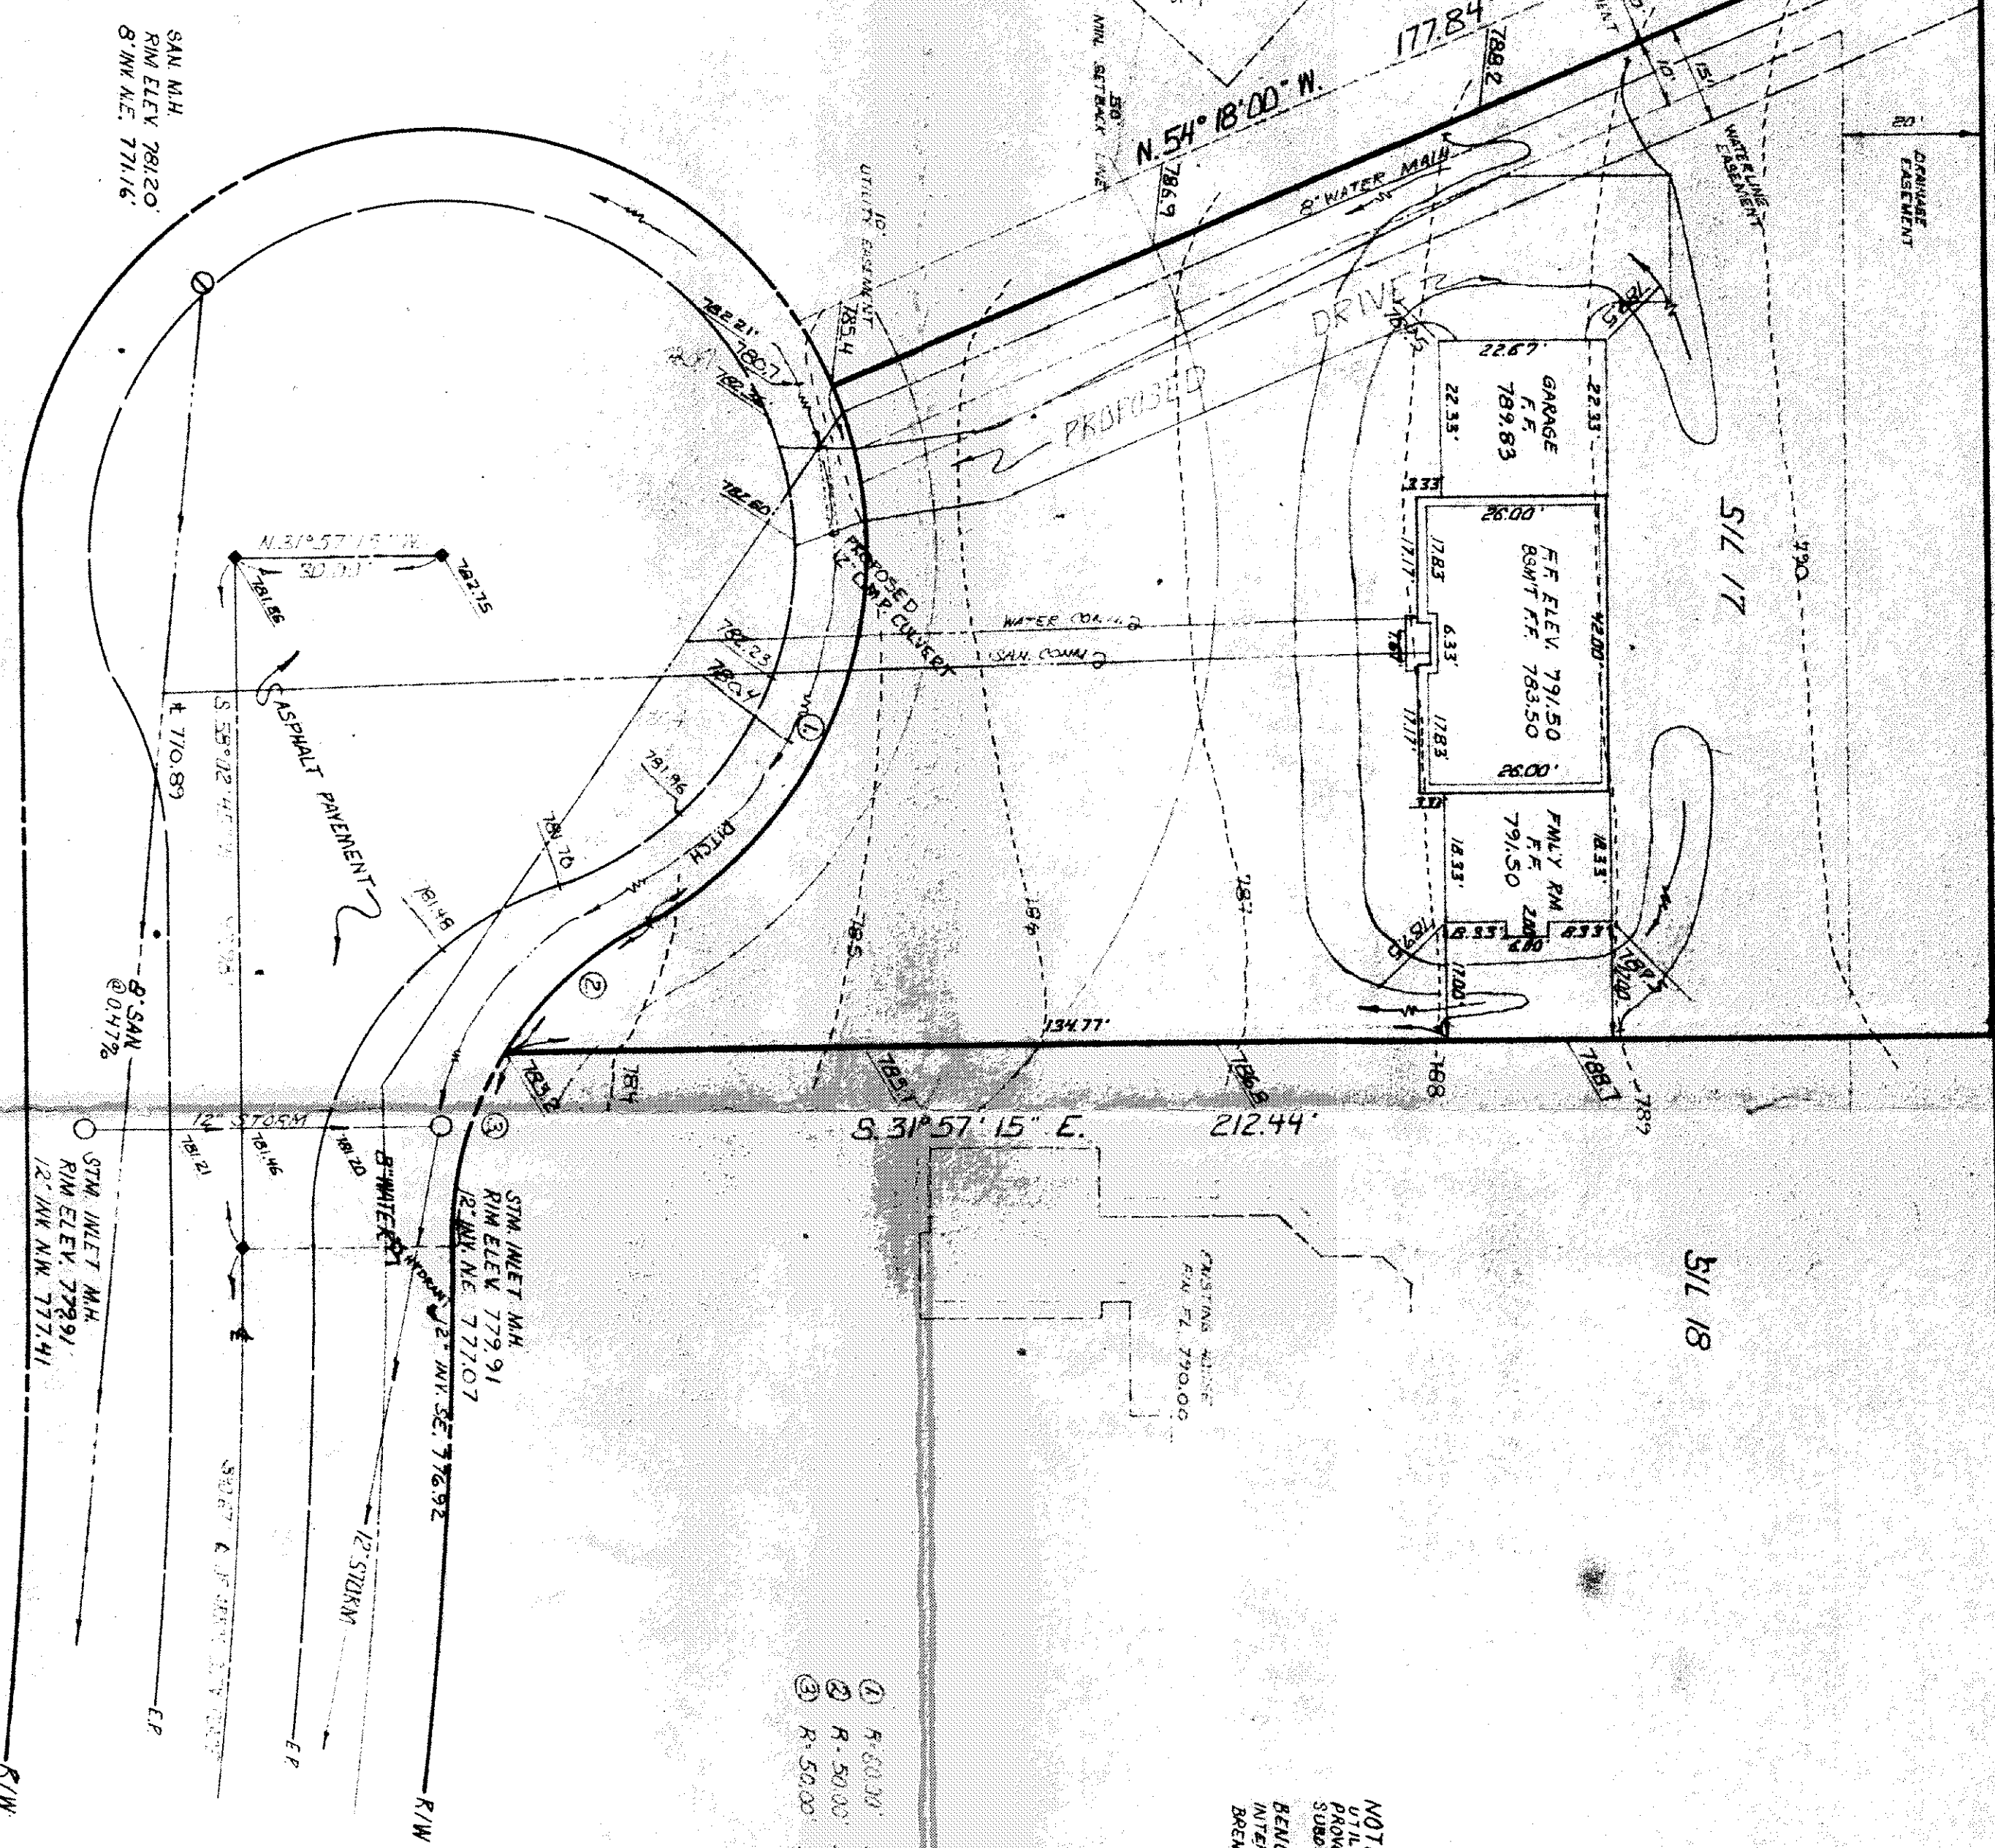


CURVE DATA

①	R=60.00'	Δ=65°15'36"	Δ=53.34'	C=81.31'	S=78.21'18" W
②	R=50.00'	Δ=31°04'31"	Δ=27.12'	C=26.77'	N=74°31'39" W
③	R=50.00'	Δ=31°43'20"	Δ=27.83'	C=27.47'	S=72°52'25" W

NOTE: ELEVATIONS FOR ASHLEY LANE AND UTILITY INFORMATION TAKEN FROM IM. PROPOSED PLANS FOR ARBOR GLEN SUBDIVISION PHASE I.

BENCHMARK: RIM OF SAN. M.H. AT THE INTERSECTION OF ARBOR GLEN PLACE & BRENNEL DRIVE. ELEV. 761.89'

EXISTING CONTOURS
PROPOSED CONTOURS

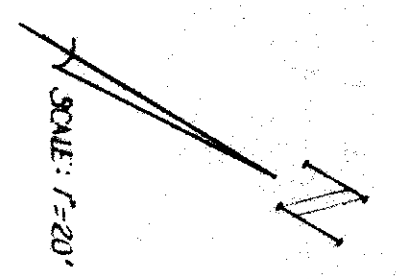

SITE PLAN for ANDREWS BUILDING CO.
BEING SUBLOT NO. 17 OF ARBOR GLEN SUBDIVISION PHASE II
CONCORD TOWNSHIP, LAKE COUNTY, OHIO

DATE: 8-7-88
SCALE: 1"=20'
DRAWN BY: D.A.G.
CHK'D: J.C.
F.B.#: PG.

CT Consultants, Inc.
Engineers • Architects • Planners
Villoughby • Mentor • North Canton • Stow • Solon • Lakewood

SHEET NO. 1 OF 1
CONTRACT NO. 87-415

ISSUED 8-23-88
#5936
Tom A. Marano