


J. MCELWAIN, ARCHT. DR. VOL. 115 PG. 596
N 58° 02' 35" E 161.97'


SIL 16

SIL 18

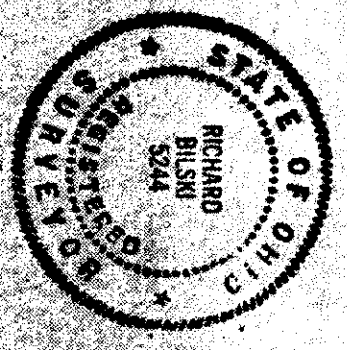

NOTE:
1 DOWNSPOUTS TO OUTLET ON SPLASH BLOCKS
2 CURVES MUST BE MAINTAINED DURING CONSTRUCTION

ASHLEY LANE 60'

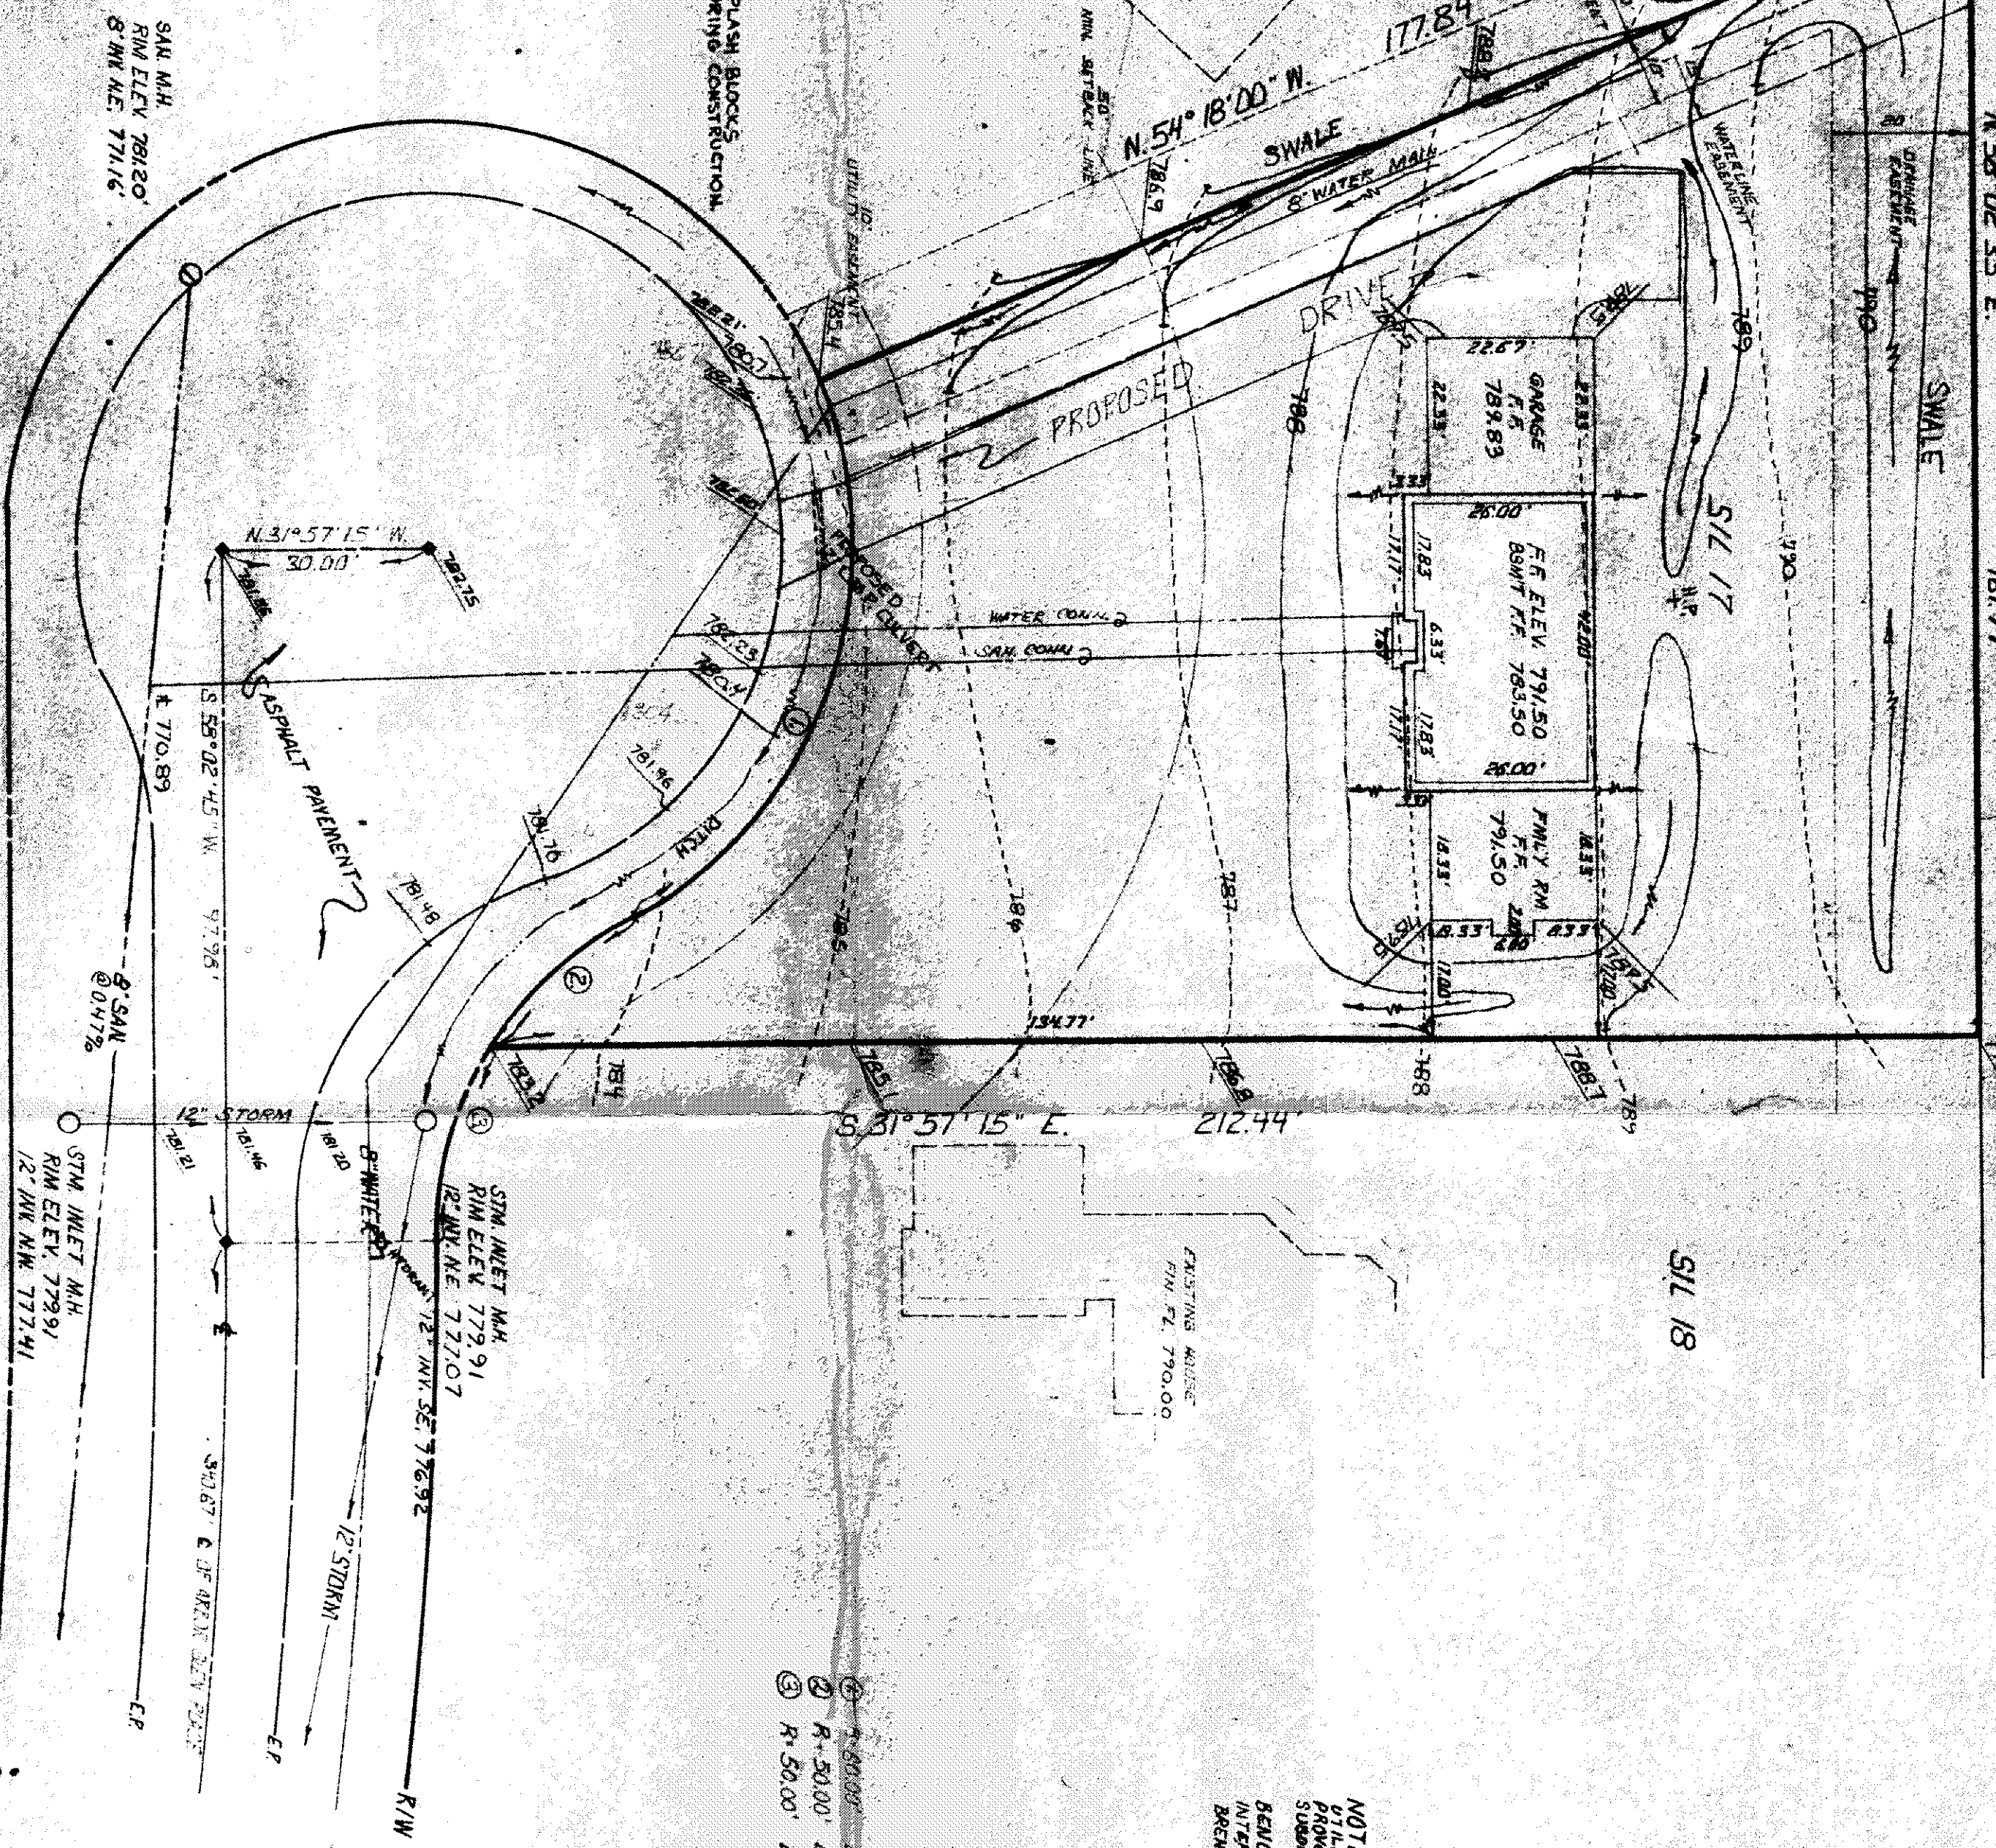

CURVE DATA

1	R=50.00'	Δ=31° 04' 31"	A=2.112'	C=26.77'	N 74° 31' 39" W
2	R=50.00'	Δ=31° 04' 31"	A=2.112'	C=26.77'	N 74° 31' 39" W
3	R=50.00'	Δ=31° 04' 31"	A=2.112'	C=26.77'	N 74° 31' 39" W

NOTE: ELEVATIONS FOR ASHLEY LANE AND UTILITY INFORMATION TAKEN FROM IN. PROPOSED PLANS FOR ARBOR GLEN SUBDIVISION PHASE I.

BENCHMARK: RIM OF SAN. M.H. AT THE INTERSECTION OF ARBOR GLEN PURVE & BRECKEL DRIVE. ELEV. 761.87'

EXISTING
PROPOSED

SCALE: 1"=20'

Grading Plan Approved
as shown and/or noted
THOMAS P. GILLES, P.E.
Lake County Engineer

Final limit
5936

SITE PLAN for ANDREWS BUILDING CO.
BEING SUBLOT NO. 17 OF ARBOR GLEN SUBDIVISION PHASE I
CONCORD TOWNSHIP, LAKE COUNTY, OHIO

CT Consultants, Inc.
Engineers • Architects • Planners
Milwaukee • Madison • North Canton • Stoughtonville • Lorain

DATE: 8-17-83
SCALE: 1"=20'
DRAWN BY: DAA
CHECKED BY: PG

SHEET NO.
1 of 1
CONTRACT NO.
87-415

DESIGN CERTIFICATION
THIS PLAN WAS PREPARED BY ME OR UNDER MY CLOSE PERSONAL SUPERVISION AND I AM A LICENSED PROFESSIONAL ENGINEER IN THE STATE OF OHIO.
I HEREBY CERTIFY THAT THE GRADED GRADES ARE CORRECT TO THE BEST OF MY KNOWLEDGE AND BELIEF.