


17 Jul 84 Date
County Engineer
CILLIS, P.E.
Approved
/ or noted


PLOT PLAN for DANIEL & RUTH ROOT
1764 WAYSIDE ROAD CLEVELAND, OHIO 44112
PHONE: 486-0705

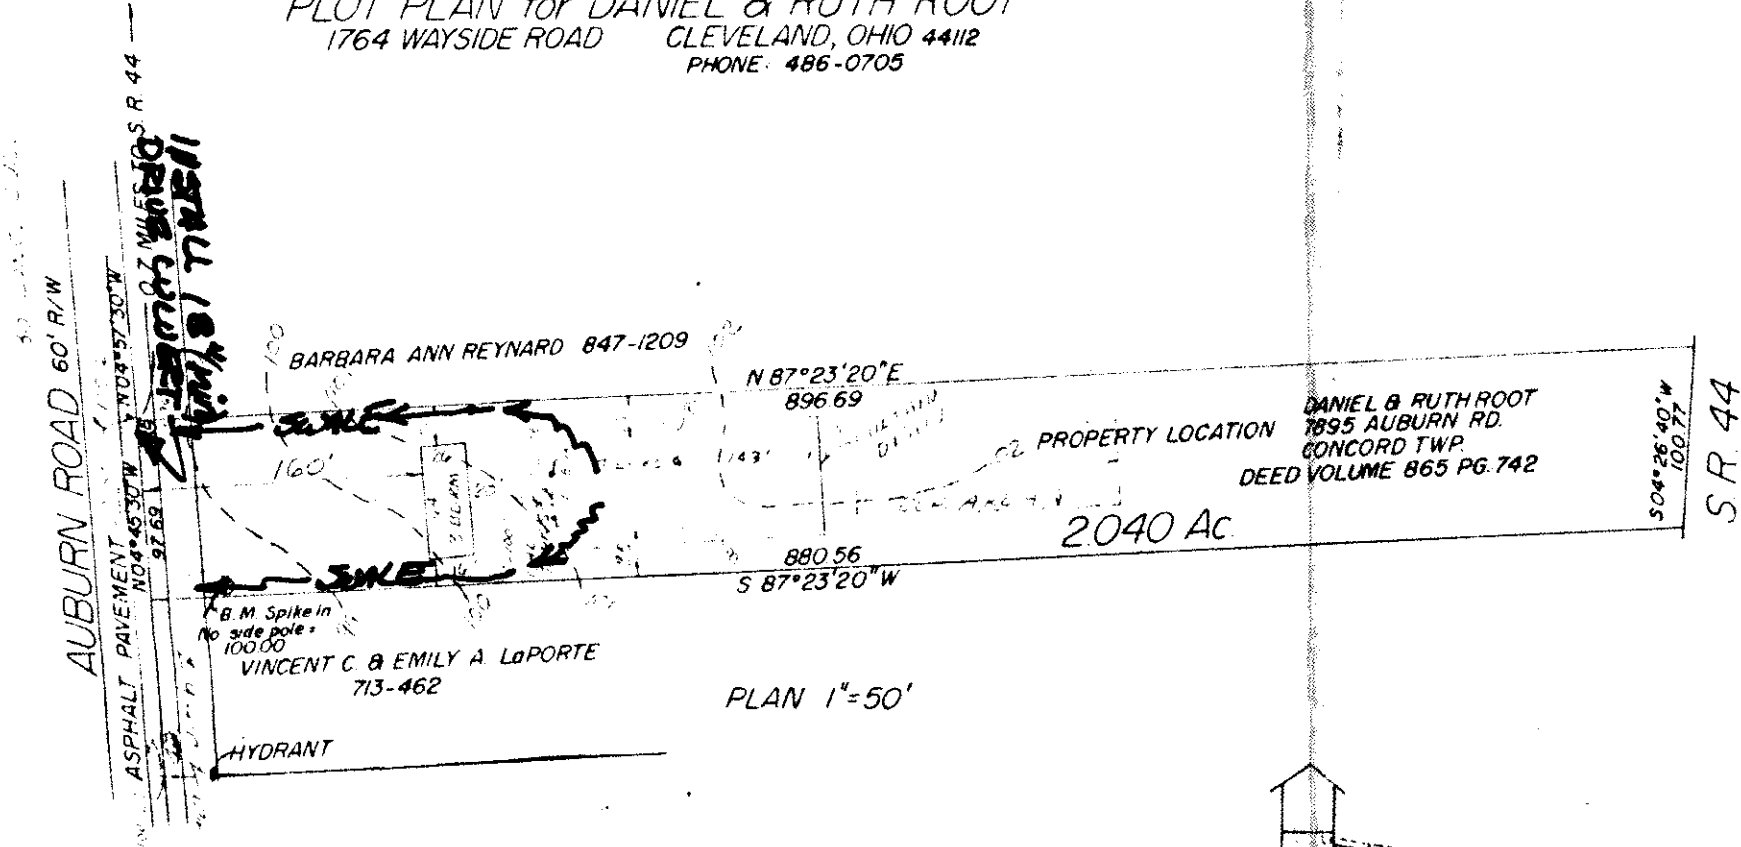

"AS BUILT" CERTIFICATION
I HEREBY CERTIFY THAT THE CIRCLED GRADES ARE EXISTING FINISH
GRADES CHECKED IN FIELD ON 19 AND ARE CORRECT
TO THE BEST OF MY KNOWLEDGE AND BELIEF

JERRY SLAY
SURVEYOR

FLOWLINE ELEVATION AT
HOUSE TO BE A MIN 6"
ABOVE FINISH GROUND
AT TRENCHES

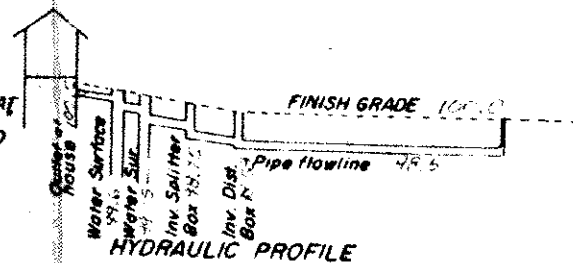

PART OF TRACT 3
PART OF LOT 12 CONCORD TWP
GEAUGA COUNTY, OHIO
OCTOBER, 1983

JERRY SLAY, OHIO SURVEYOR 5298
THIS PLAT WAS PREPARED BY ME AND IS CORRECT TO THE
BEST OF MY KNOWLEDGE AND BELIEF

