

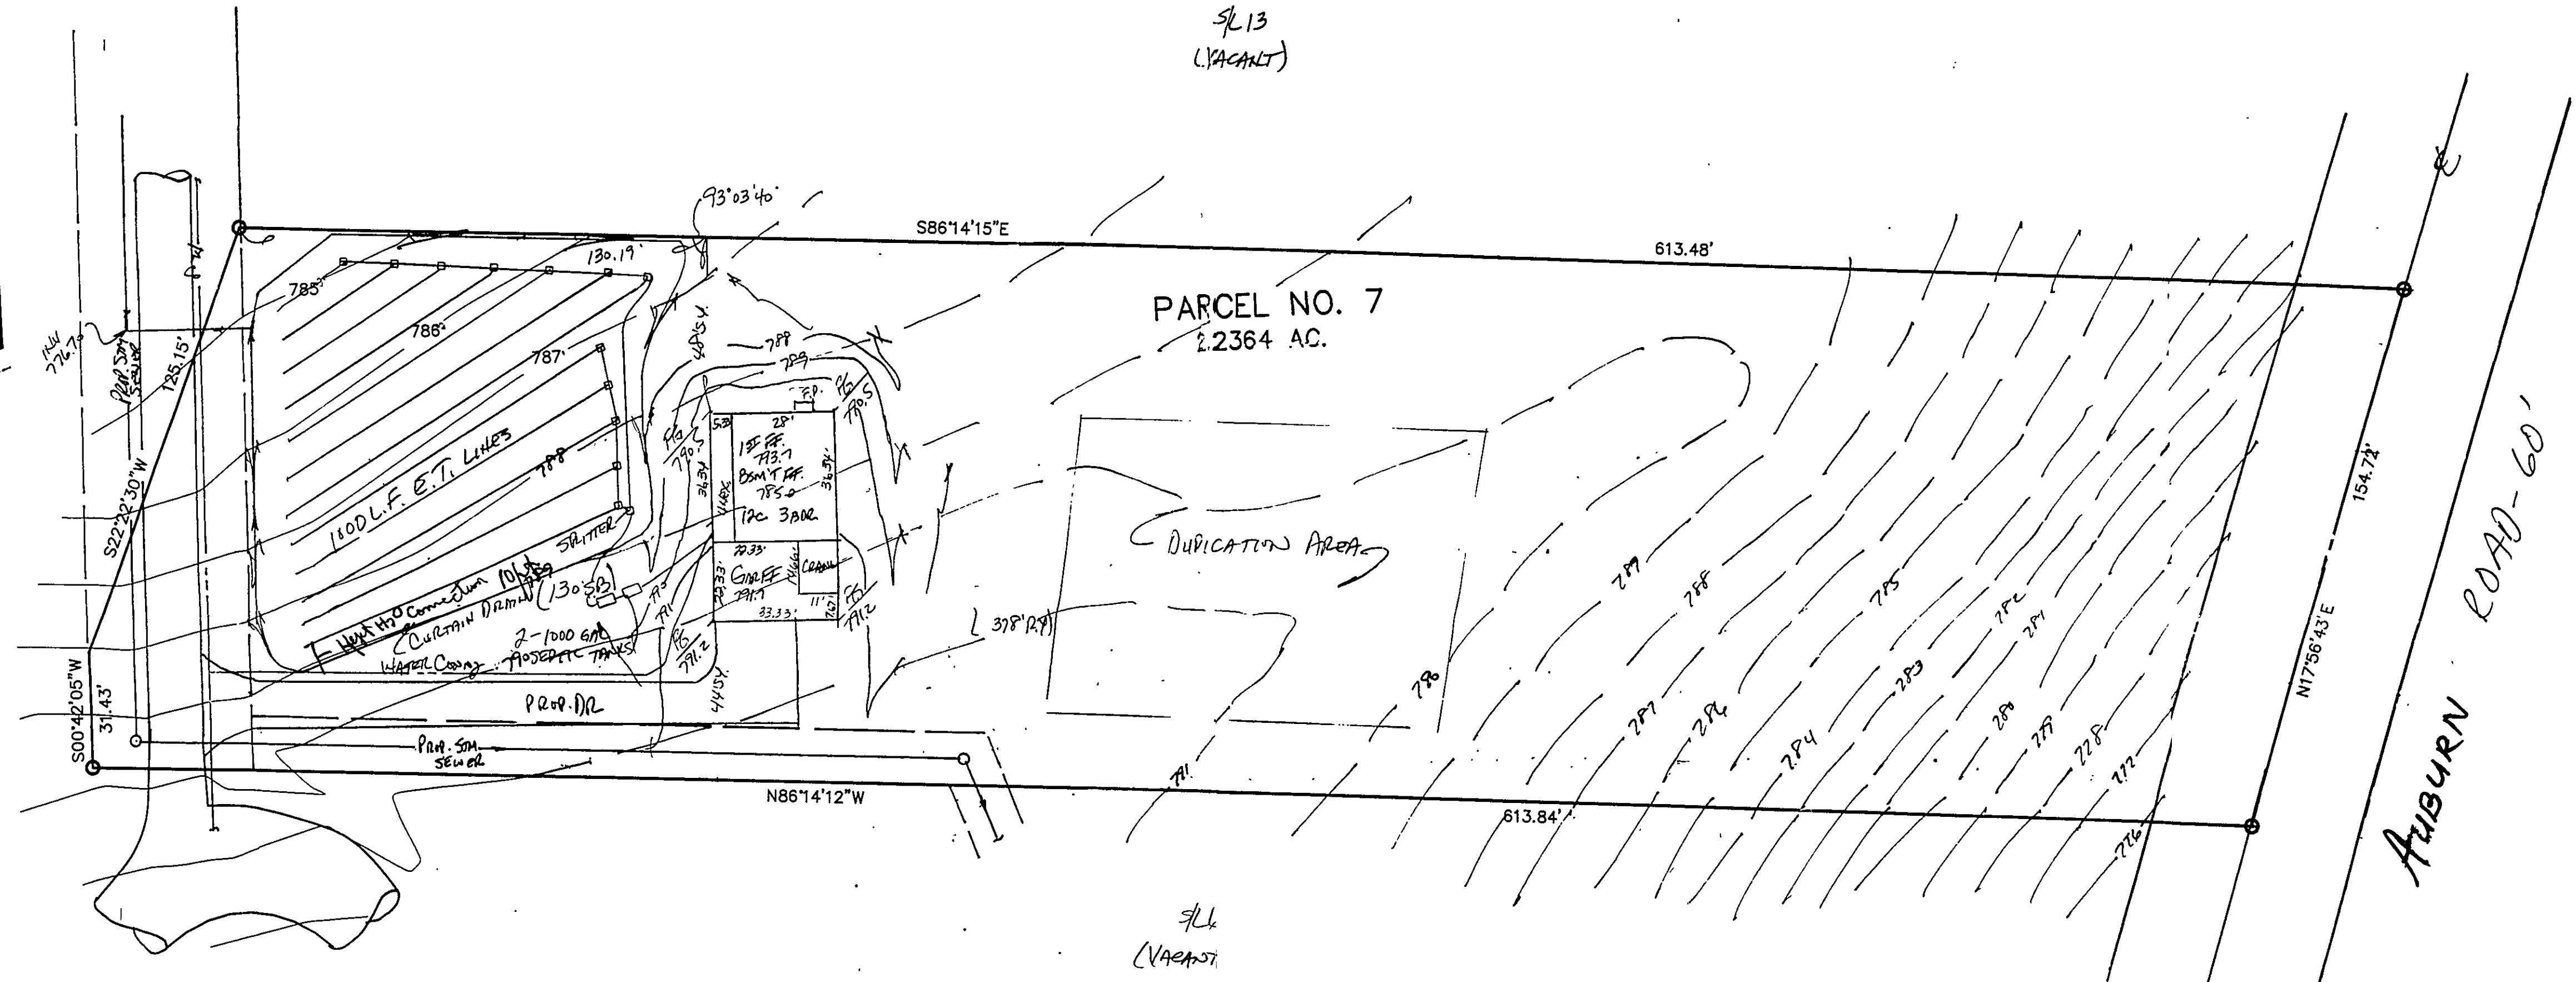
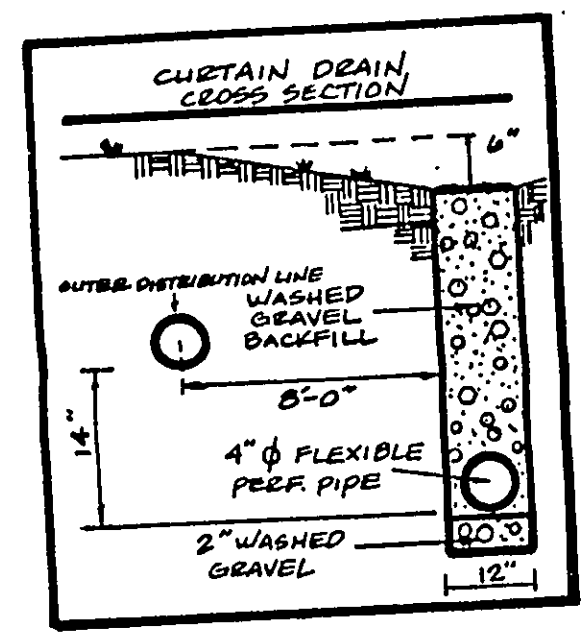


REVIEWED AND ACCEPTED
LAKE COUNTY GENERAL
HEALTH DISTRICT
9-15-97
[Signature]
SEWAGE DISPOSAL PERMIT MUST BE
OBTAINED BY A LAKE COUNTY LICENSED
ENGINEER BEFORE INSTALLATION IS
STARTED

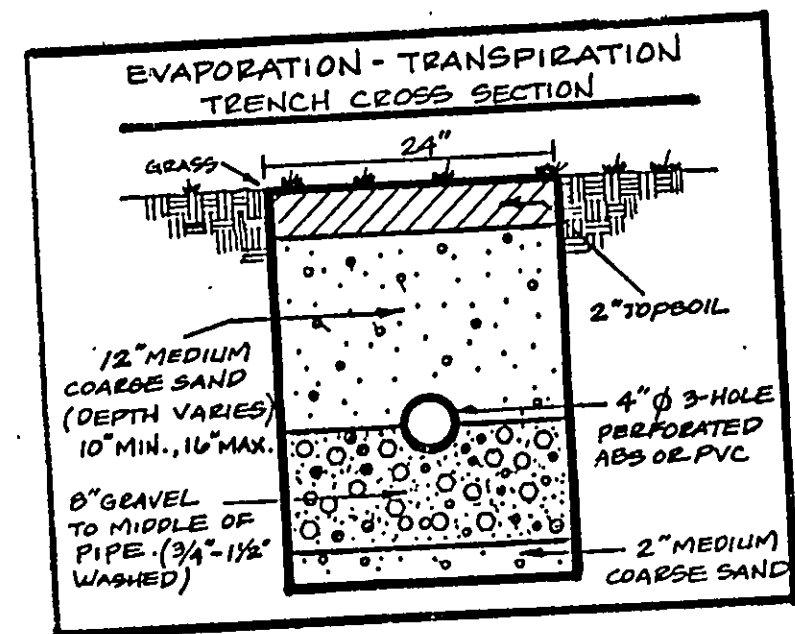

Grading Plan Approved
as shown and/or noted
THOMAS P. GILLES, P.E.
Lake County Engineer
By 6/14 Date 9-17-97

ZONING PERMIT #0997-8862
ISSUED 9/3/97
SUBJECT TO APPROVAL BY:
Lake County Sanitary Eng. ☐
Lake County Eng. Dept. ☒
Lake County Planning Comm. ☐
Lake County Bldg. Dept. ☒

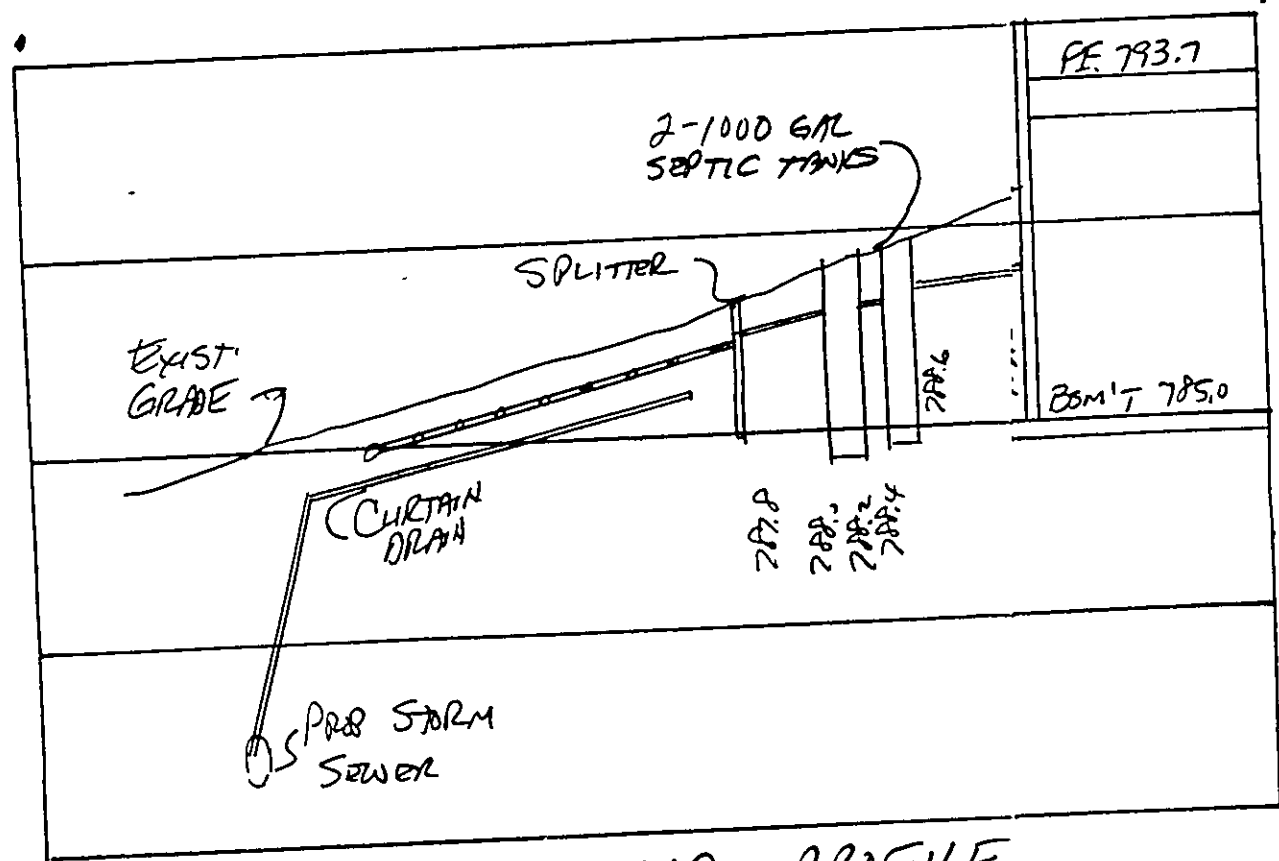

HYDRAULIC PROFILE
HORIZ: 1"=30' VERT: 1"=5'

"I, the undersigned hereby certify that
this topography indicated by 6", 1" or 2"
contours, and elevations shown hereon
represent an actual field survey made by
me on the 21st day of August, 1997
and that the elevations were taken at
appropriate intervals and that as of that
date they existed as indicated hereon."
[Signature]
Name Harry S. Jones, Jr. Reg. No. 6243



REV NO.	DESCRIPTION	DATE	BY	CHK'D

BABCOCK, JONES AND ASSOCIATES, INC
CIVIL ENGINEERS - SURVEYORS - LAND PLANNERS
PAINESVILLE OHIO 44077

DATE 8/28/97
DESIGN BY [Signature]
DRAWN BY M.S.
APPROVED BY [Signature]

SITE PLAN
for
VANWINKLE
for
AUBURN RIDGE SUB.
LAKE COUNTY, OHIO
CONCORD TOWNSHIP
SCALE 1"=30'
JOB NO. 97-192-07
SHEET 1 OF 1