


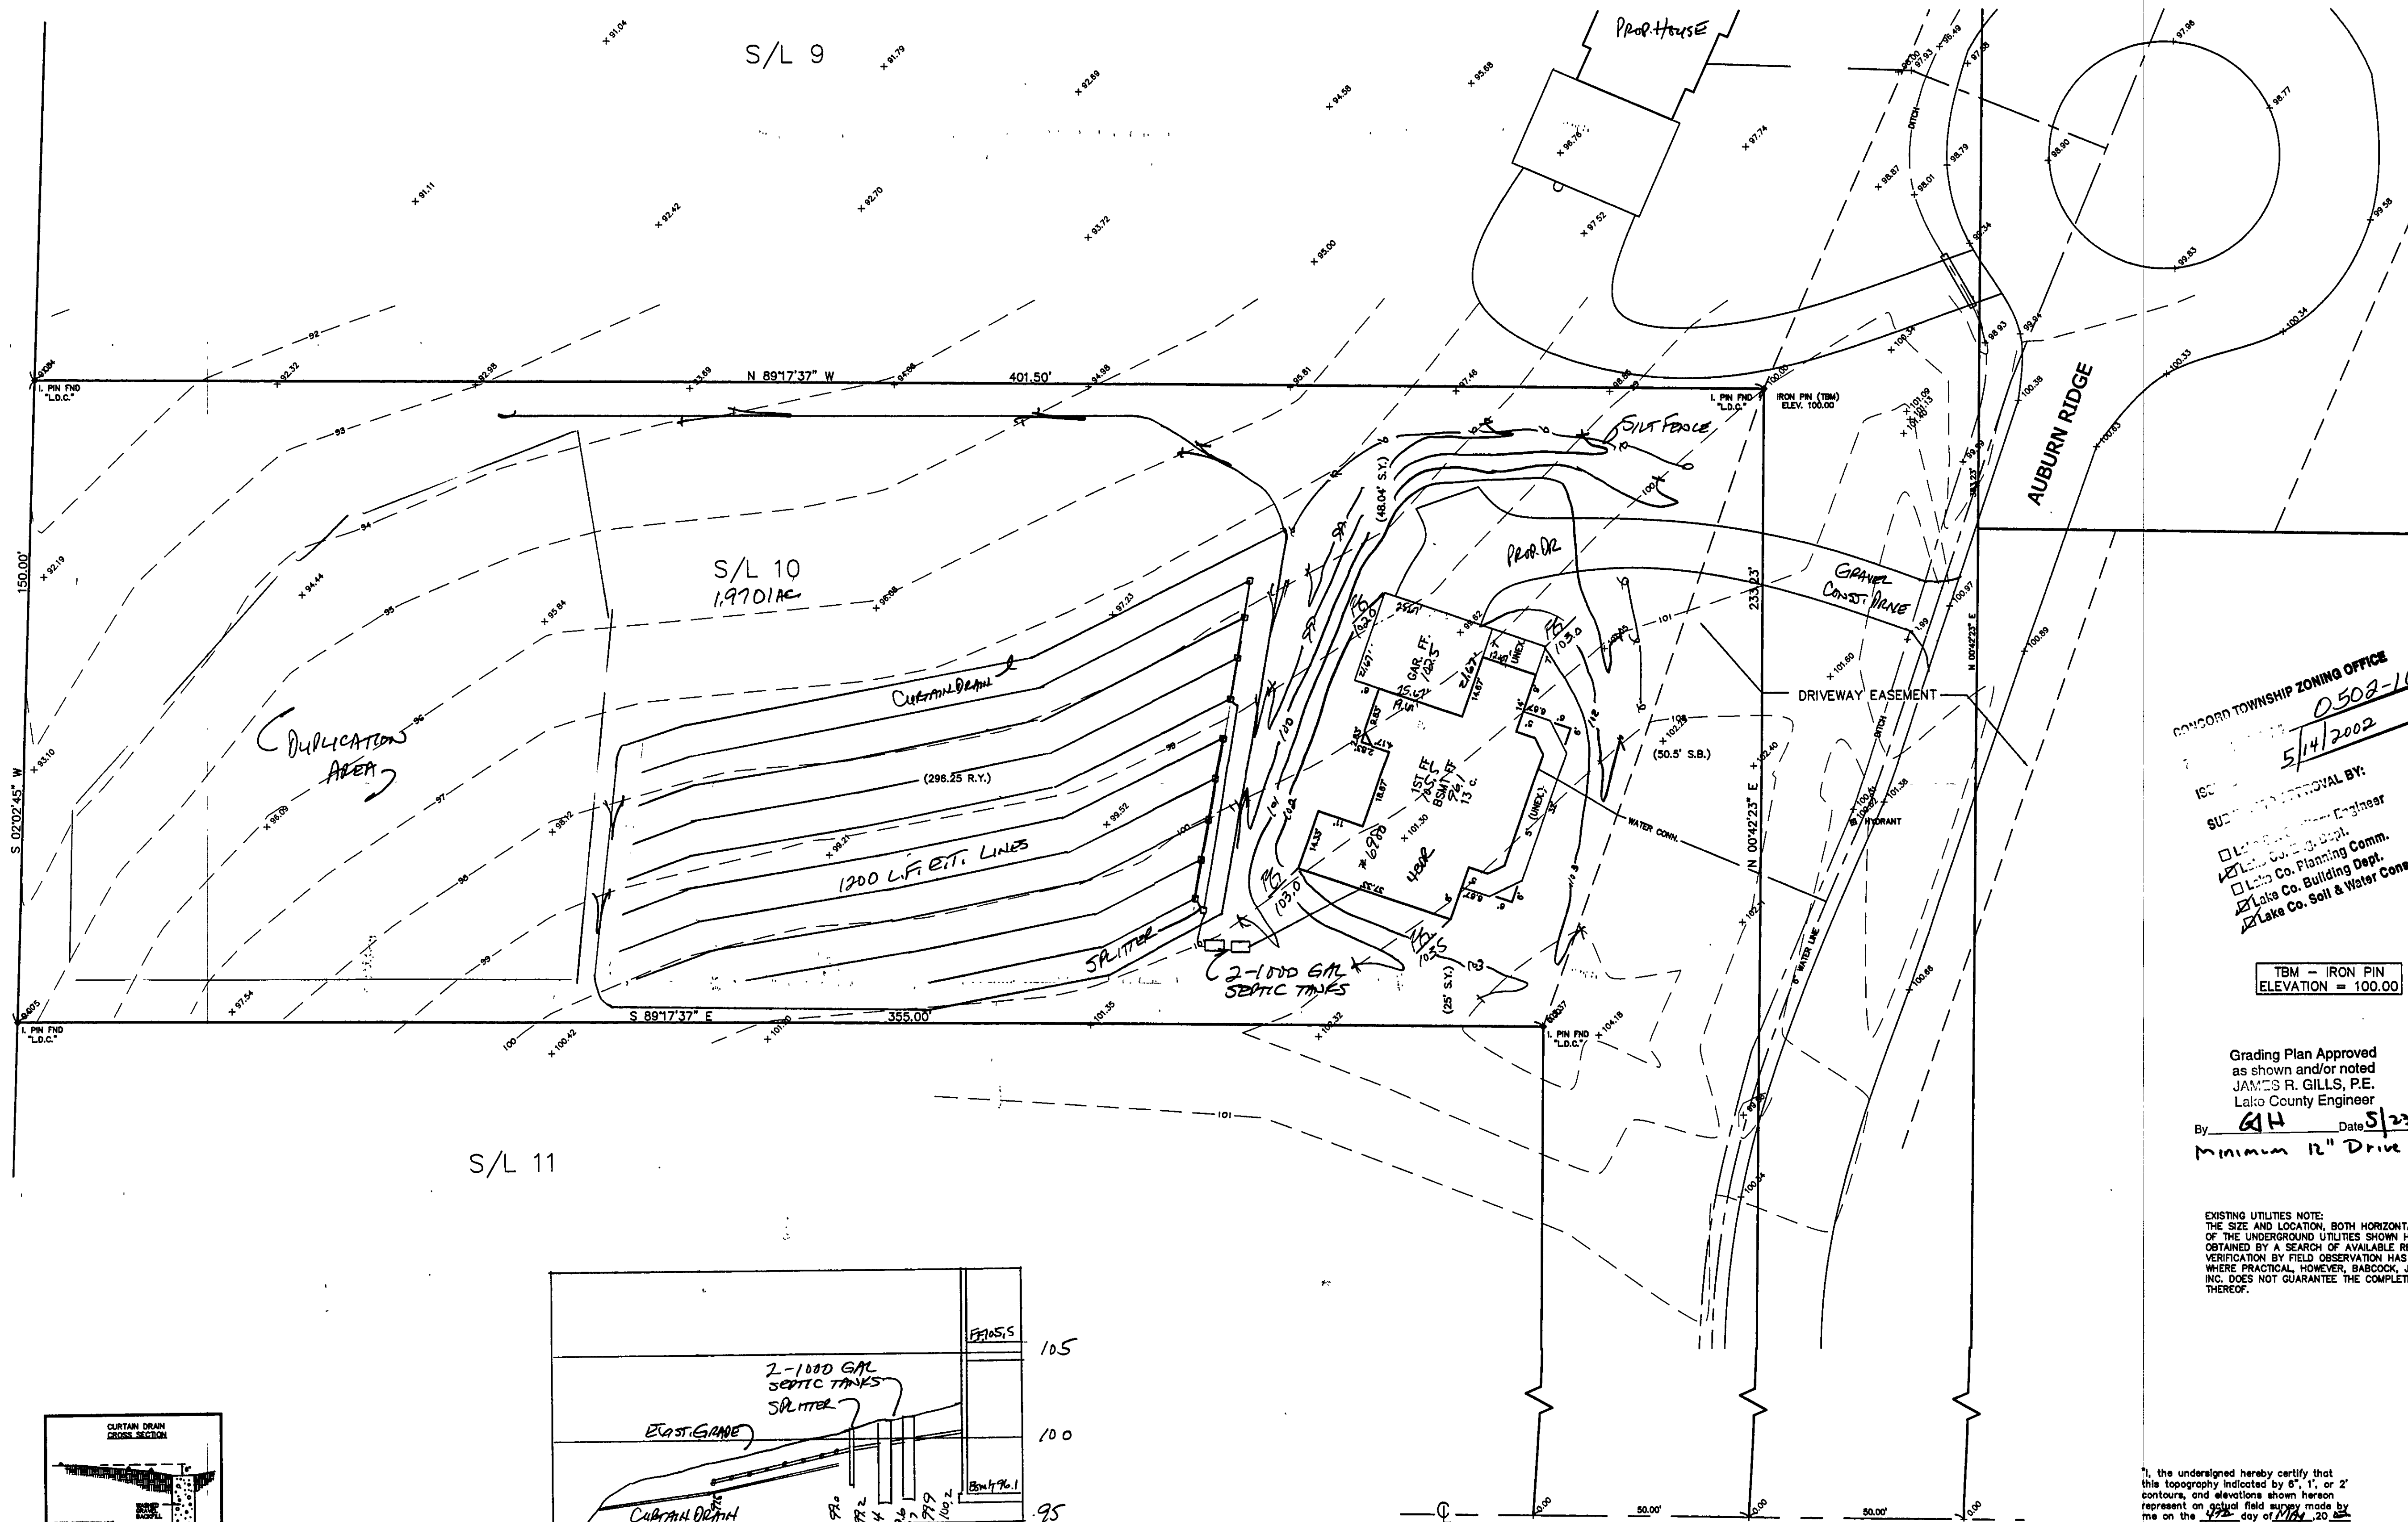

CONCORD TOWNSHIP ZONING OFFICE
0502-10537
5/14/2002


SUBMITTAL APPROVAL BY:
JAMES R. GILLS, P.E.
LAKO COUNTY ENGINEER
LAKO CO. PLANNING COMM.
LAKO CO. BUILDING DEPT.
LAKO CO. SOIL & WATER CONSERV. DIST.

TBM - IRON PIN
ELEVATION = 100.00




Grading Plan Approved
as shown and/or noted
JAMES R. GILLS, P.E.
Lako County Engineer
By: GH Date: 5/23/02
Minimum 12" Drive Culvert

EXISTING UTILITIES NOTE:
THE SIZE AND LOCATION, BOTH HORIZONTAL AND VERTICAL
OF THE UNDERGROUND UTILITIES SHOWN HEREON, HAVE BEEN
OBTAINED BY A SEARCH OF AVAILABLE RECORDS.
VERIFICATION BY FIELD OBSERVATION HAS BEEN CONDUCTED
WHERE PRACTICAL, HOWEVER, BABCOCK, JONES AND ASSOCIATES
INC. DOES NOT GUARANTEE THE COMPLETENESS NOR ACCURACY
THEREOF.

I, the undersigned hereby certify that
this topography indicated by 6", 1", or 2"
contours, and elevations shown hereon
represent an actual field survey made by
me on the 17th day of May, 2002
and that the elevations were taken at
appropriate intervals and that as of that
date they existed as indicated hereon.

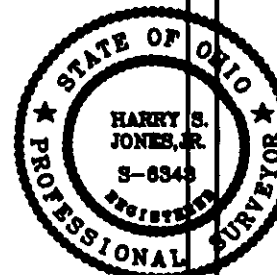

5/2/02 D.O.D.
curtain drain must go to
first catch basin

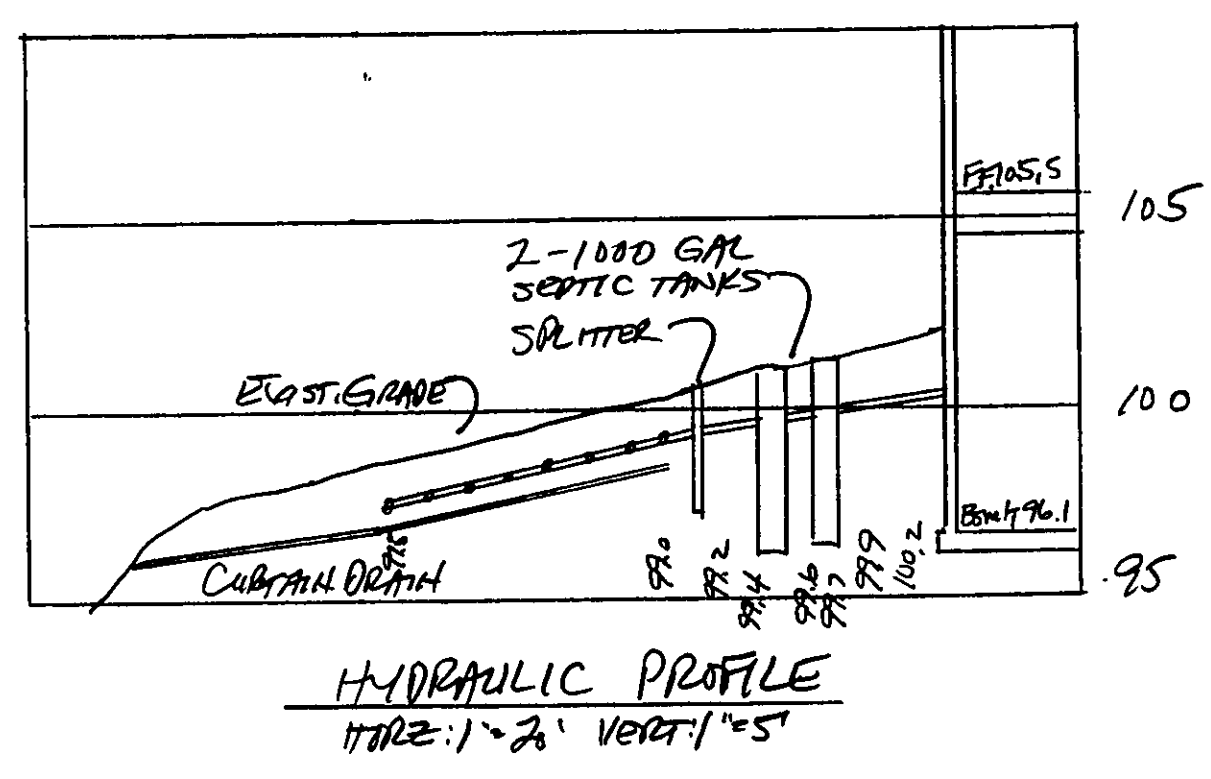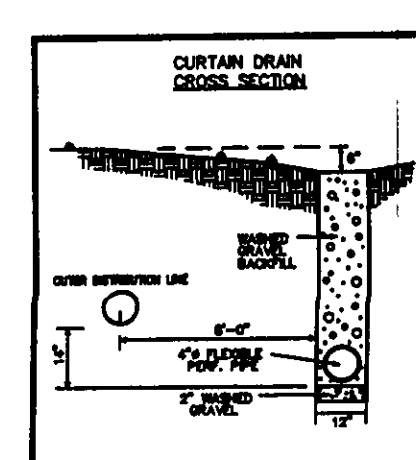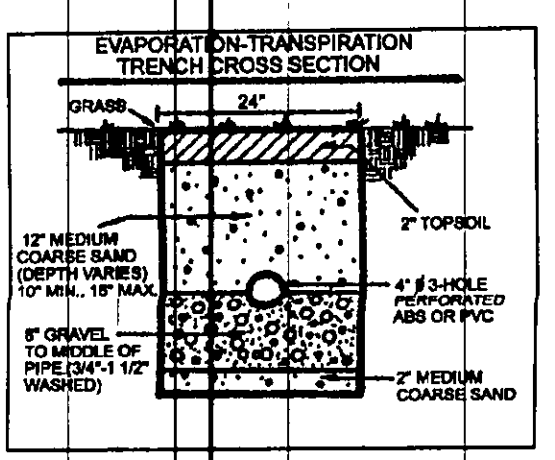

REV NO.	DESCRIPTION	DATE	BY	CHK'D



BABCOCK, JONES AND ASSOCIATES, INC.
CIVIL ENGINEERS - SURVEYORS - LAND PLANNERS
PAINESVILLE OHIO 44077

DATE	5/7/02	SITE PLAN FOR SCHAFFER S/L 10 AUBURN RIDGE SUB	SCALE	1" = 20'
DESIGN BY	H.J.		JOB NO.	99-192-10
DRAWN BY	B.P.		SHEET	1 OF 1
APPROVED BY	H.J.		TOWNSHIP OF CONCORD	COUNTY OF LAKE

STATE OF OHIO