

1/2

## SITE PLAN

CONCORD TOWNSHIP, LAKE COUNTY, OHIO

for: KAY HOMES

CLIENT

OWNER

ADDRESS

STREET

CITY

ZIP

LITTLE MOUNTAIN

SUBDIVISION 39-13

NAME

TRACT

STREET

25 VOL.-PG.

AUGUSTA LANE

LOT

PERM. PARCEL NO.

SUBLOT NO.

STREET

VOL.-PG.

PERM. PARCEL NO.

## LEGEND

SANITARY MANHOLE

STORM MANHOLE

INLET OR CATCH BASIN

HYDRANT

EXISTING CONTOURS

PROPOSED CONTOURS

EXIST. ELEV. 100.0

100.0

AS BUILT ELEVATION

INDICATES

DIRECTION OF

SURFACE DRAINAGE

## REMARKS

ALL BOUNDARY DATA SHOWN WAS OBTAINED FROM (DEEDS, RECORDED SUBDIVISION PLAT OR OTHER PUBLIC RECORDS)

LOCATIONS AS SHOWN OF ADJACENT WELLS AND SEPTIC TANKS OBTAINED FROM LAKE COUNTY HEALTH DEPARTMENT

## DESIGN CERTIFICATION

THIS PLAT WAS PREPARED BY ME, AND IS CORRECT TO THE BEST OF MY KNOWLEDGE AND BELIEF.

NAME

SURVEYOR

REGISTRATION NO.

## CHECK LIST

NO. OF BEDROOMS

DIMENSIONS

BEARINGS

TIE TO NEAREST STREET

SUBLOT NO. PARCEL NO.

SURROUNDING OWNERS

BLDG. DIMENSIONS FIN GR.

BLDG. TIES FL'R. GRADES

APRON TYPE WIDTH THICKNESS

SIDEWALK TYPE WIDTH THICKNESS

CULVERT TYPE DIA., LENGTH

ROCK OUTCROPPINGS

WATER MAIN SIZE, LOCATION

SAN. SEWER SIZE % GR. LOC.

SAN. MH. CAST. ELEV. INV. ELEV.

SAN. CONN. SIZE, LOC. DEPTH

STORM SEWER SIZE % GR. LOC.

STORM MH. CAST. ELEV. INV. ELEV.

PAV'T TYPE GRADE CURBS

GAS LINE LOC. SIZE PRESSURE

SEPTIC TANK LOCATION &amp; DUPLICATION AREA

WELL LOCATION

ISOLATION RADIUS FROM WELL

## REVISIONS

NO.	DATE	BY
1	11/18/04	B.C.
2		
3		
4		
5		

PLAN PREPARED BY:



BABCOCK JONES &amp; ASSOCIATES, INC.

PAINESVILLE, OHIO

DRAWN BY B.C.

SCALE 1"=30'

PHONE NO. 440-357-1811

CHK'D. H.J.

DATE 11/15/04

DRAWING NO. 00-179-25

CREW CHIEF E.H.

APP'D H.J.

## "AS BUILT" CERTIFICATION

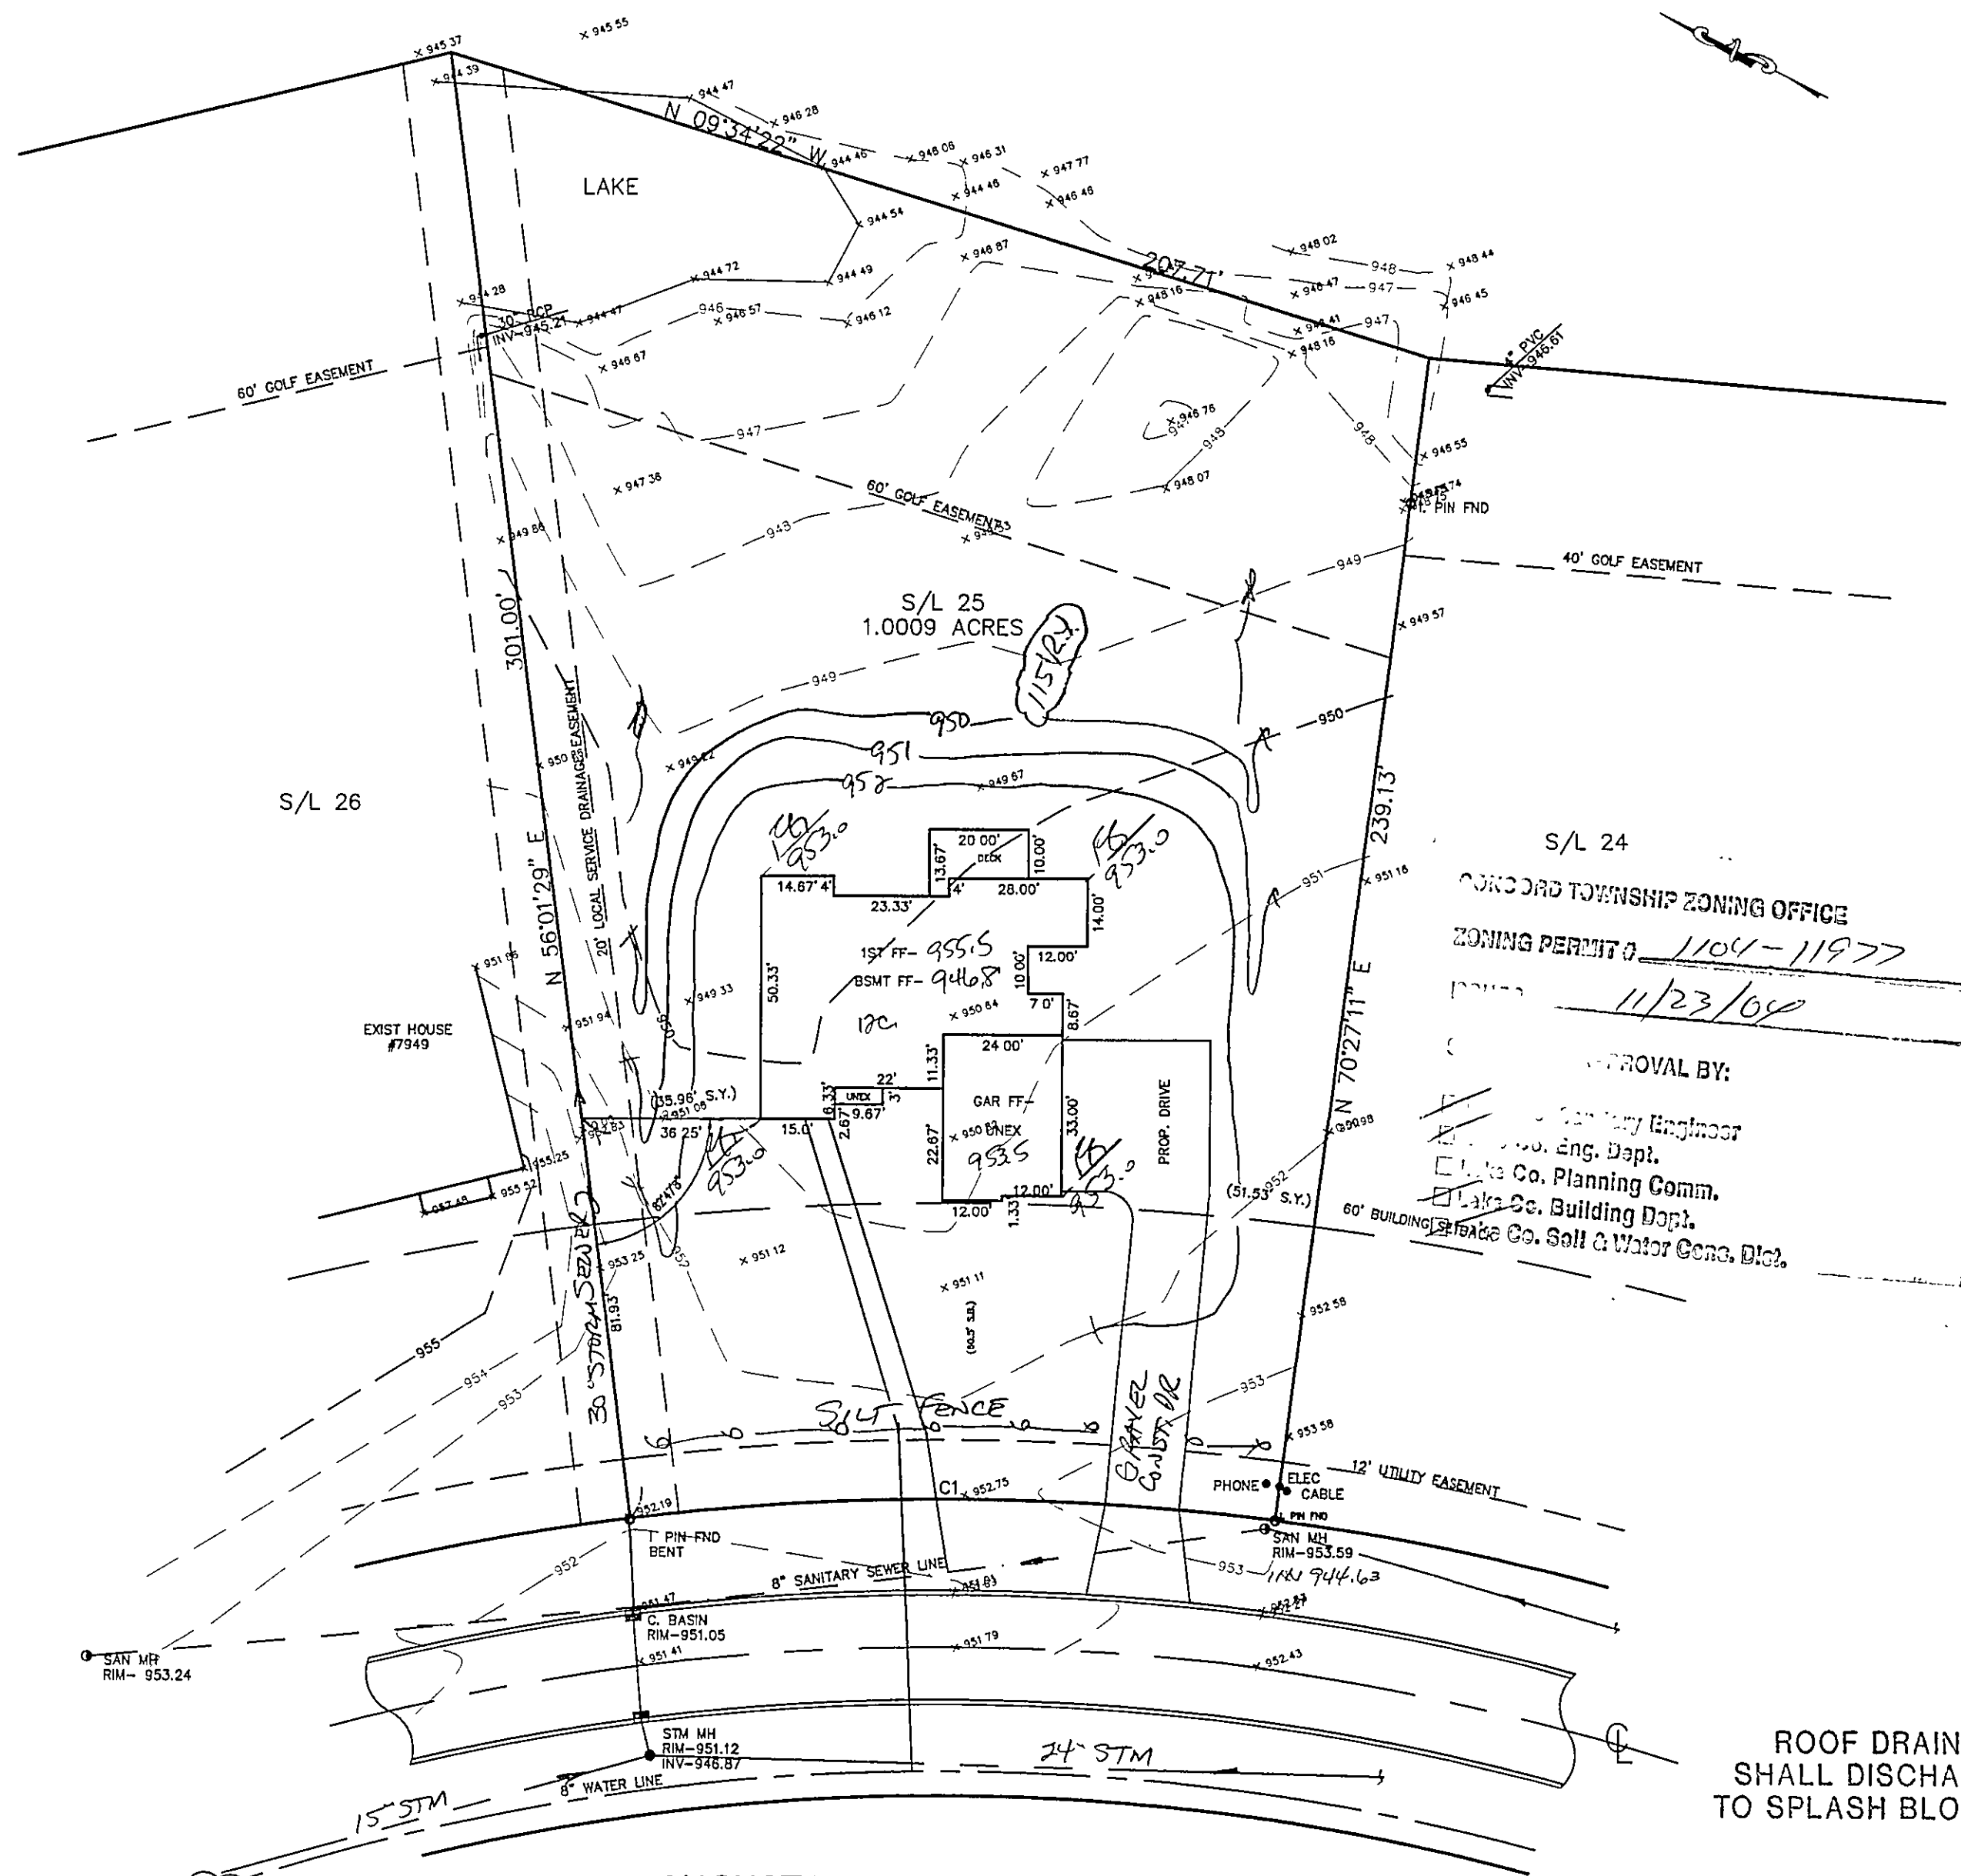
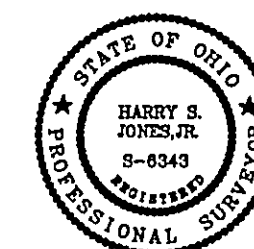
I, HEREBY CERTIFY THAT THE CIRCLED GRADES ARE EXISTING FINISH GRADES CHECKED IN THE FIELD ON 11/23/04, 2004 AND ARE CORRECT TO THE BEST OF MY KNOWLEDGE AND BELIEF.

REGISTERED SURVEYOR

REG. NO.

TBM-TOP OF HYD  
ELEV-956.95ROOF DRAINS  
SHALL DISCHARGE  
TO SPLASH BLOCKS.

CURVE	LENGTH	RADIUS	TANGENT	CHORD	BEARING	DELTA
C1	130.95	520.00	65.82	130.60	N28°43'39"W	14°29'43"

EXISTING UTILITIES NOTE:  
THE SIZE AND LOCATION, BOTH HORIZONTAL AND VERTICAL OF THE UNDERGROUND UTILITIES SHOWN HEREON, HAVE BEEN OBTAINED BY A SEARCH OF AVAILABLE RECORDS. VERIFICATION BY FIELD OBSERVATION HAS BEEN CONDUCTED WHERE PRACTICAL, HOWEVER, BABCOCK, JONES AND ASSOCIATES INC. DOES NOT GUARANTEE THE COMPLETENESS NOR ACCURACY THEREOF.

AUGUSTA LANE - 60'

Site Manager Management Plan  
As shown and/or noted  
JAMES R. GILLS, P.E.  
County Drainage Engineer  
By L.S. Date 11/23/04