



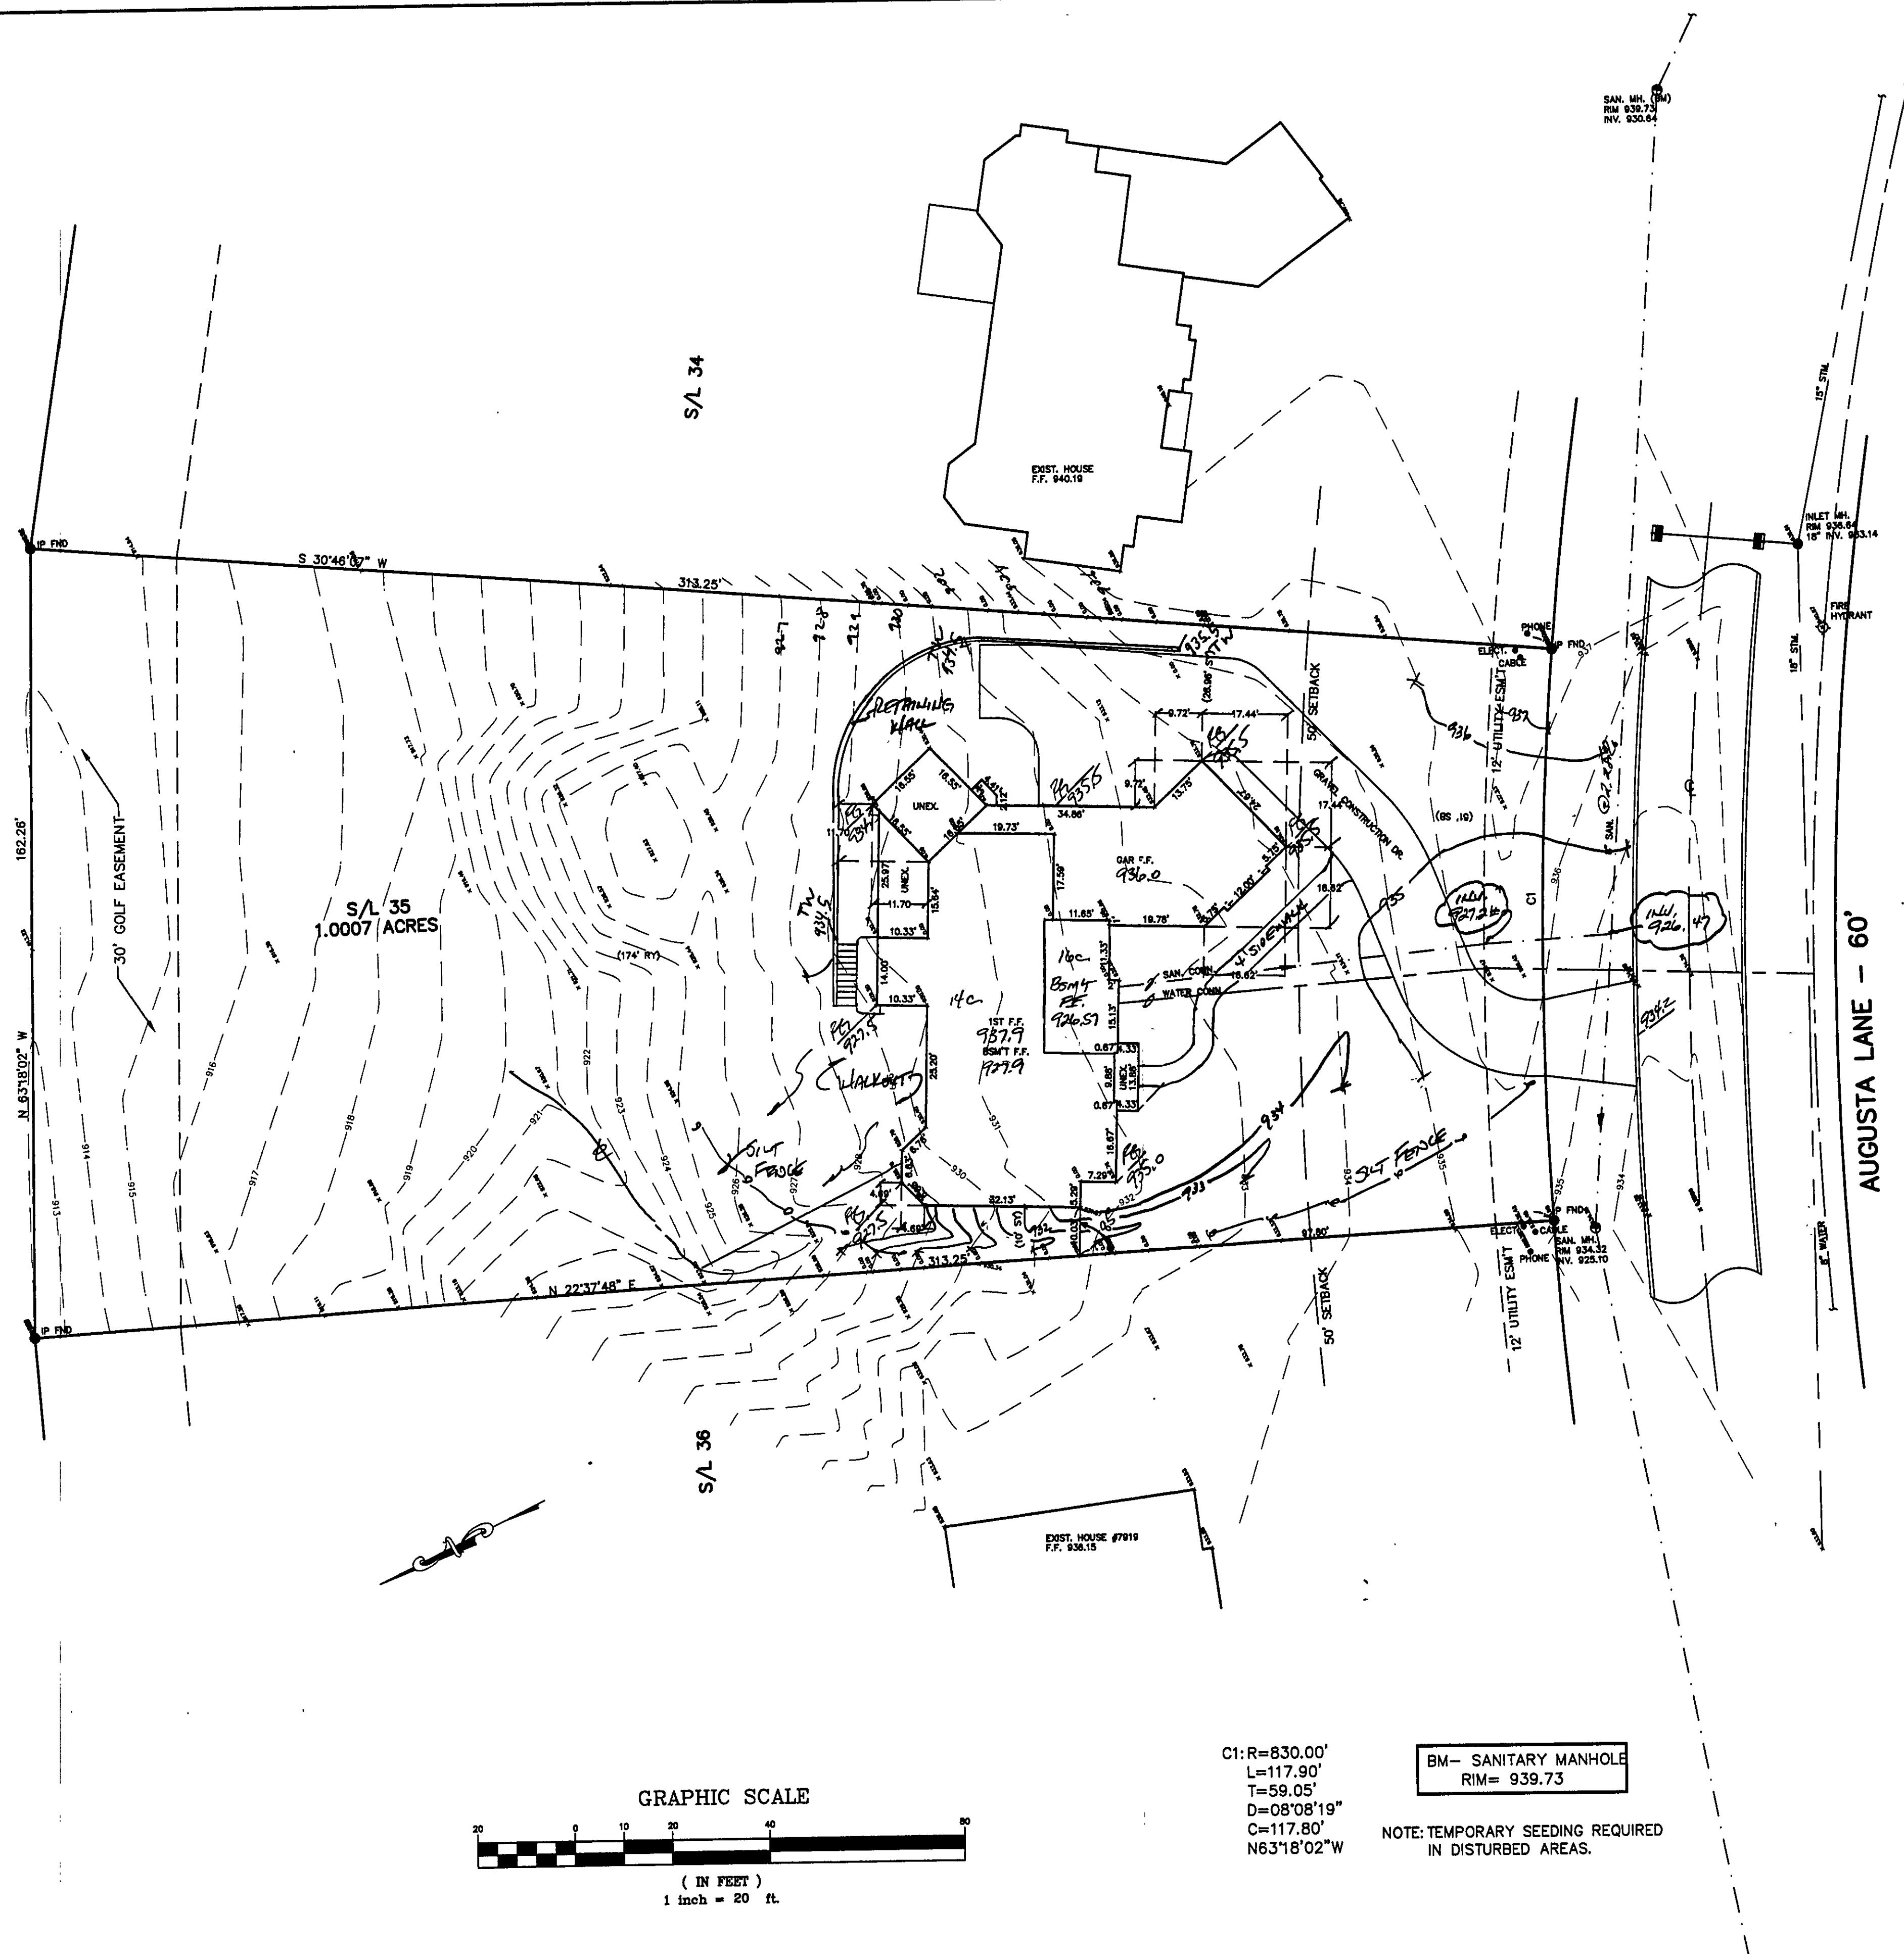

NOTE: NEED TO CHECK
INVERT OF SANITARY
LATERAL TO PROVIDE
BASEMENT SERVICE

Grading Plan Approved
as shown and/or noted
JAMES R. GILLS, P.E.
Lako County Engineer
By GM Date 04/09/02

CONCORD TOWNSHIP ENGINEERING OFFICE
20-01-4
ISSUED 4-10-02
SUBMITTED BY:
JAMES R. GILLS, P.E.
Lako County Engineer
Lako Co. Civil & Water Cons. Dist.

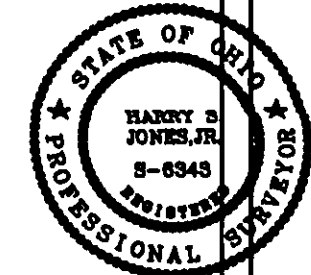

REV NO.	DESCRIPTION	DATE	BY	CHK'D

bj BABCOCK, JONES AND ASSOCIATES, INC
CIVIL ENGINEERS - SURVEYORS - LAND PLANNERS
PAINESVILLE OHIO 44077

DATE	4/8/02
DESIGN BY	H.J.
DRAWN BY	M.M.
APPROVED BY	H.J.

SITE PLAN FOR KERN BUILDING AUGUSTA LANE CONCORD TOWNSHIP	SCALE	1"=20'
	JOB NO	DC-179-35
	SHEET	1 OF 1