


CONCORD TOWNSHIP ZONING OFFICE
 ZONING PERMIT # 1201-10428
 ISSUED 12/14/2001
 SUBJECT TO APPROVAL BY:
☐ Lake Co. Sanitary Engineer
☒ Lake Co. Eng. Dept.
☐ Lake Co. Planning Comm.
☒ Lake Co. Building Dept.
☒ Lake Co. Soil & Water Cons. Dist.

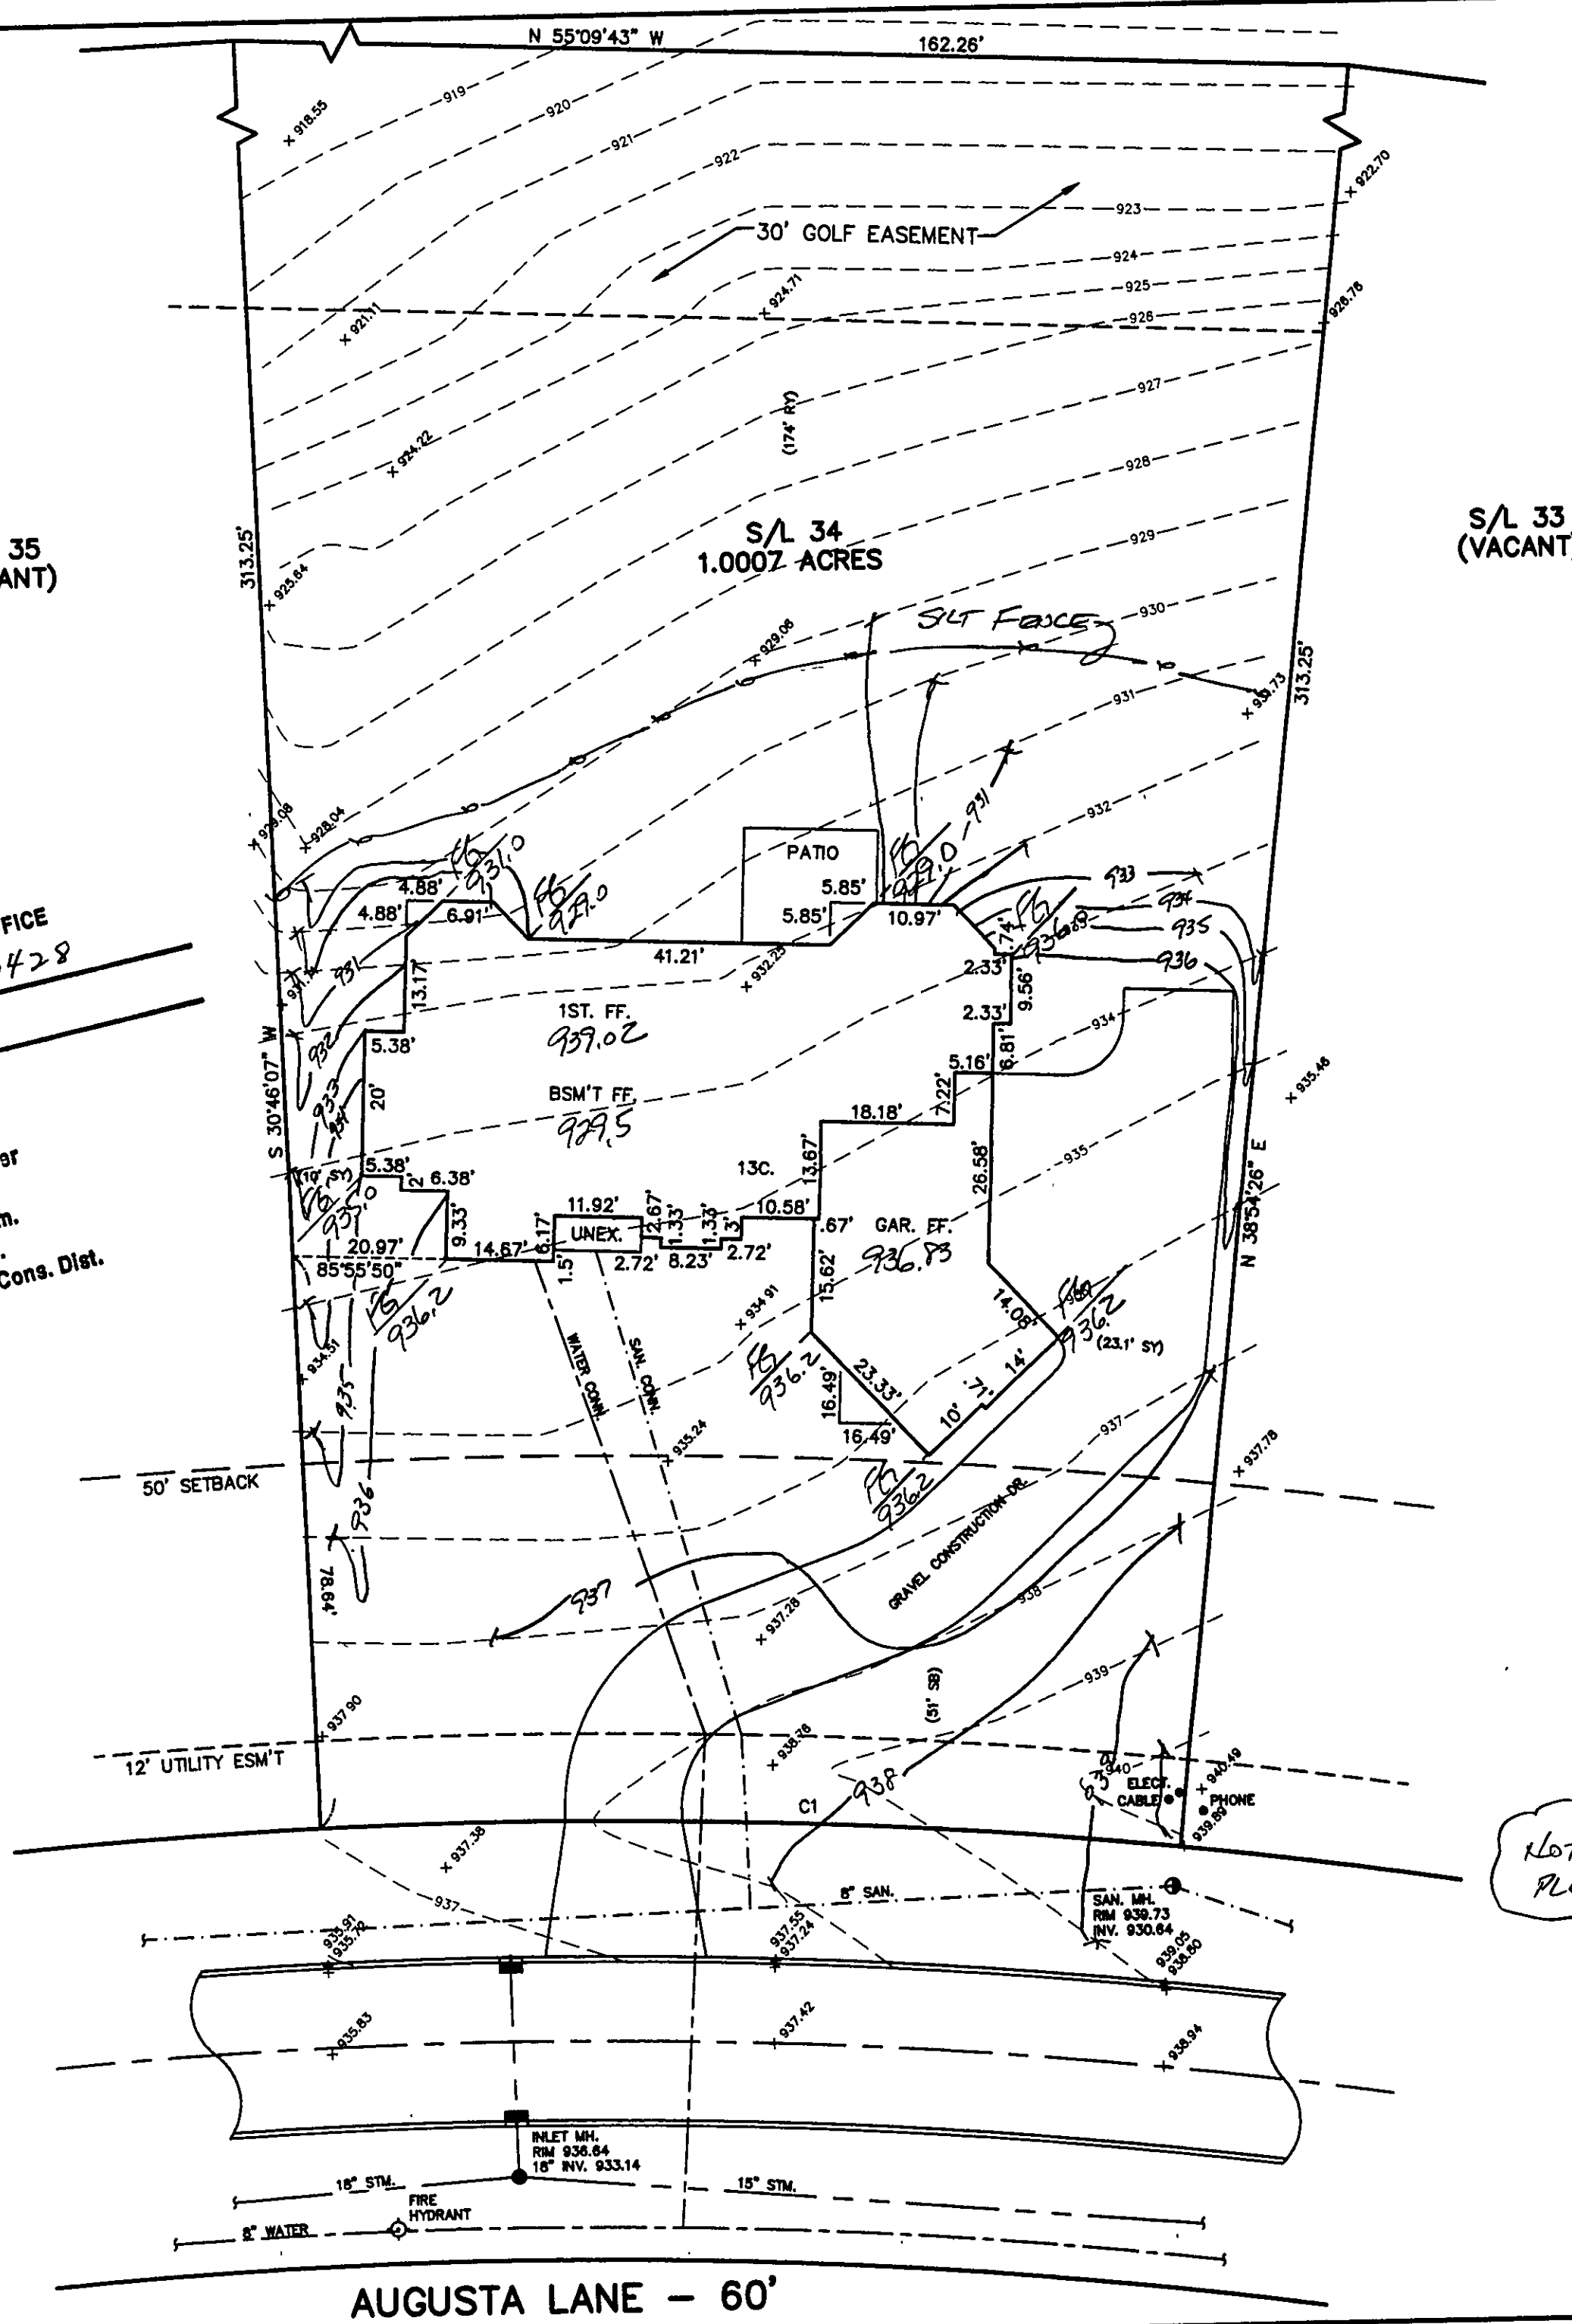

SITE PLAN

CONCORD TOWNSHIP, LAKE COUNTY, OHIO

for: **KERN BUILDING**

CLIENT: _____ OWNER: _____

ADDRESS: _____ STREET: _____ CITY: _____ ZIP: _____

LITTLE MOUNTAIN

SUBDIVISION: 39-13 NAME: _____ TRACT: _____ STREET: _____

34 VOL: 106 LOT: _____

SUBLOT NO. _____ STREET: AUGUSTA LANE VOL: 106 PERM. PARCEL NO. _____

LEGEND

SANITARY MANHOLE: EXIST. ELEV. 100.0 PROP. ELEV. 100.0

STORM MANHOLE: AS BUILT ELEVATION

INLET OR CATCH BASIN:

HYDRANT: INDICATES DIRECTION OF SURFACE DRAINAGE

EXISTING CONTOURS:

PROPOSED CONTOURS:

DESIGN CERTIFICATION

THIS PLAT WAS PREPARED BY ME, AND IS CORRECT TO THE BEST OF MY KNOWLEDGE AND BELIEF.

NAME: Harry S. Jones, Jr. SURVYOR: #6343 REGISTRATION NO. _____

REVISIONS			PLAN PREPARED BY:		
NO.	DATE	BY	BABCOCK JONES & ASSOCIATES, INC.		
1	12/13/01	HT	PAINESVILLE, OHIO		
2			DRAWN BY: T.R.	SCALE: 1"=20'	PHONE NO. 440-387-1811
3			CHK'D: H.J.	DATE: 12/12/01	DRAWING NO. 00-179-34
4			CREW CHIEF: R.B.	APP'D: H.J.	
5					

"AS BUILT" CERTIFICATION
 I, HEREBY CERTIFY THAT THE CIRCLED GRADES ARE EXISTING FINISH GRADES CHECKED IN THE FIELD ON 20 AND ARE CORRECT TO THE BEST OF MY KNOWLEDGE AND BELIEF.

REGISTERED SURVEYOR REG. NO. _____

C1: R=830.00'
 L=117.90'
 T=59.05'
 D=08°08'19"
 C=117.80'
 N55°09'43"W

BM-SANITARY MANHOLE
 RIM=939.73

NOTE: TEMPORARY SEEDING REQUIRED IN DISTURBED AREAS.

NOTE: HIGH WALL PLUMBING REQUIRED

Grading Plan Approved as shown and/or noted
 JAMES R. GILLS, P.E.
 Lake County Engineer
 By GHT Date 12/18/01

