

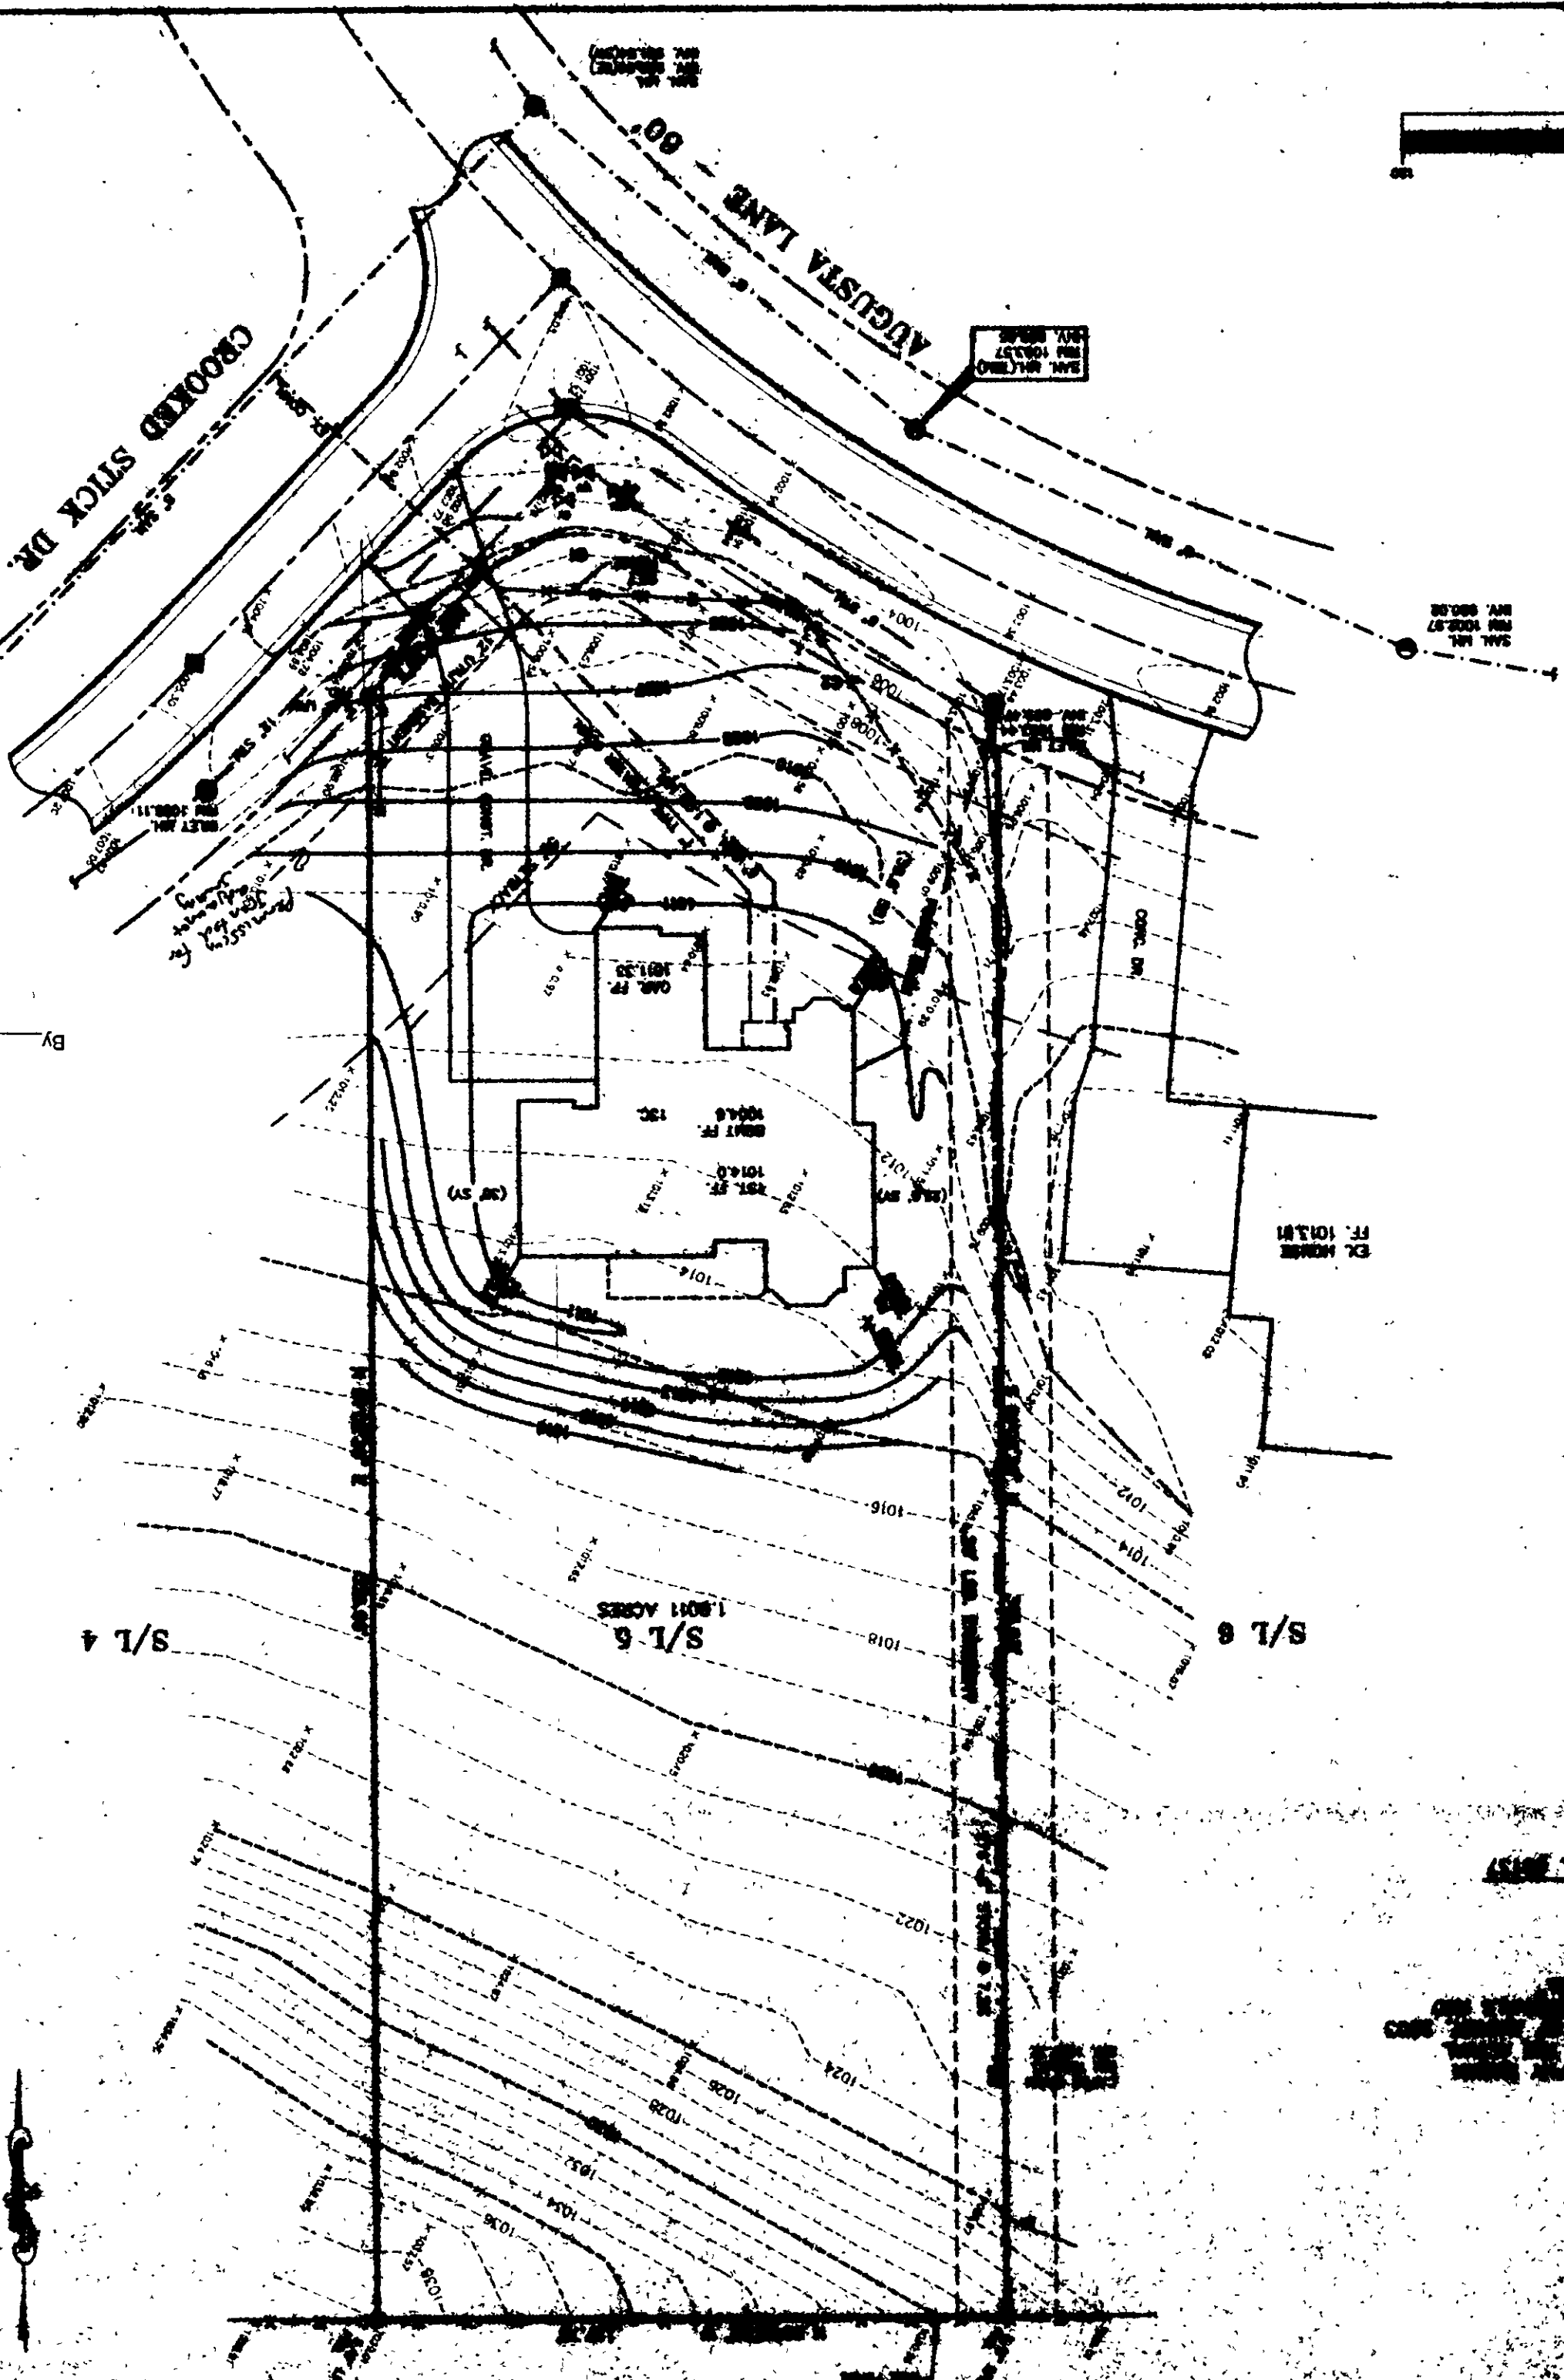
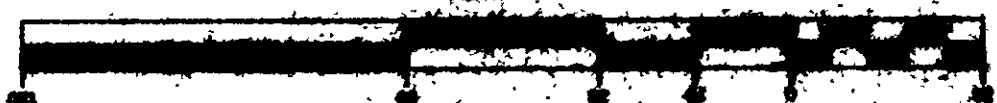


GRAPHIC SCALE

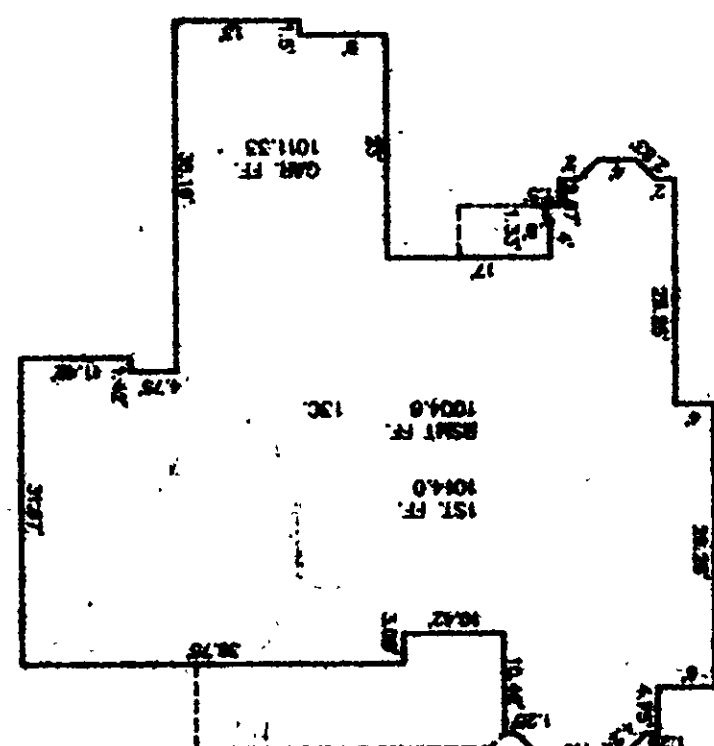

Grading Plan Approved
as shown and/or noted
J. M. GILLS, P.E.
L. J. County Engineer
By: GJH Date: 9/3/03

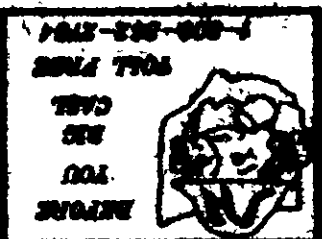

CONCORD TOWNSHIP ZONING OFFICE
ZONING PERMIT # D403-11253
ISSUED 9/3/03
SUBJECT TO APPROVAL BY:
☒ Lake Co. Sanitary Engineer
☒ Lake Co. Eng. Dept.
☒ Lake Co. Planning Comm.
☒ Lake Co. Building Dept.
☒ Lake Co. Soil & Water Cons. Dist.

JOE KOVACH

SITE PLAN

5/1-5 LITTLE MOUNTAIN COUNTRY CLUB
CONCORD TOWNSHIP LAKE COUNTY OHIO
9-20-03 TDR D403-11253

WILLIAM B. GRAY ASSOCIATES, INC.
7819 WINTER ST. JACOBO, OHIO 44001
(440) 244-1016