

SITE PLAN FOR:

SOUTHWOOD CONSTR.
 6604 BELVOIR COURT
 CONCORD, OHIO

BEING SUBLT No. 9 IN THE CHERRY HILL
 SUBDIVISION LOCATED IN CONCORD TWP.,
 OHIO.

PREPARED BY:

WM. R. GRAY ASSOC. INC.
 7547 MENTOR AVE.
 MENTOR, OHIO

DATE: JAN. 14, 1975 SCALE: 1" = 20'



CERTIFICATION:

I HEREBY CERTIFY THAT
 THIS PLAT IS CORRECT TO THE BEST
 OF MY KNOWLEDGE.

By: *Wm R Gray*



WM. R. GRAY REG. SURV. # 2752

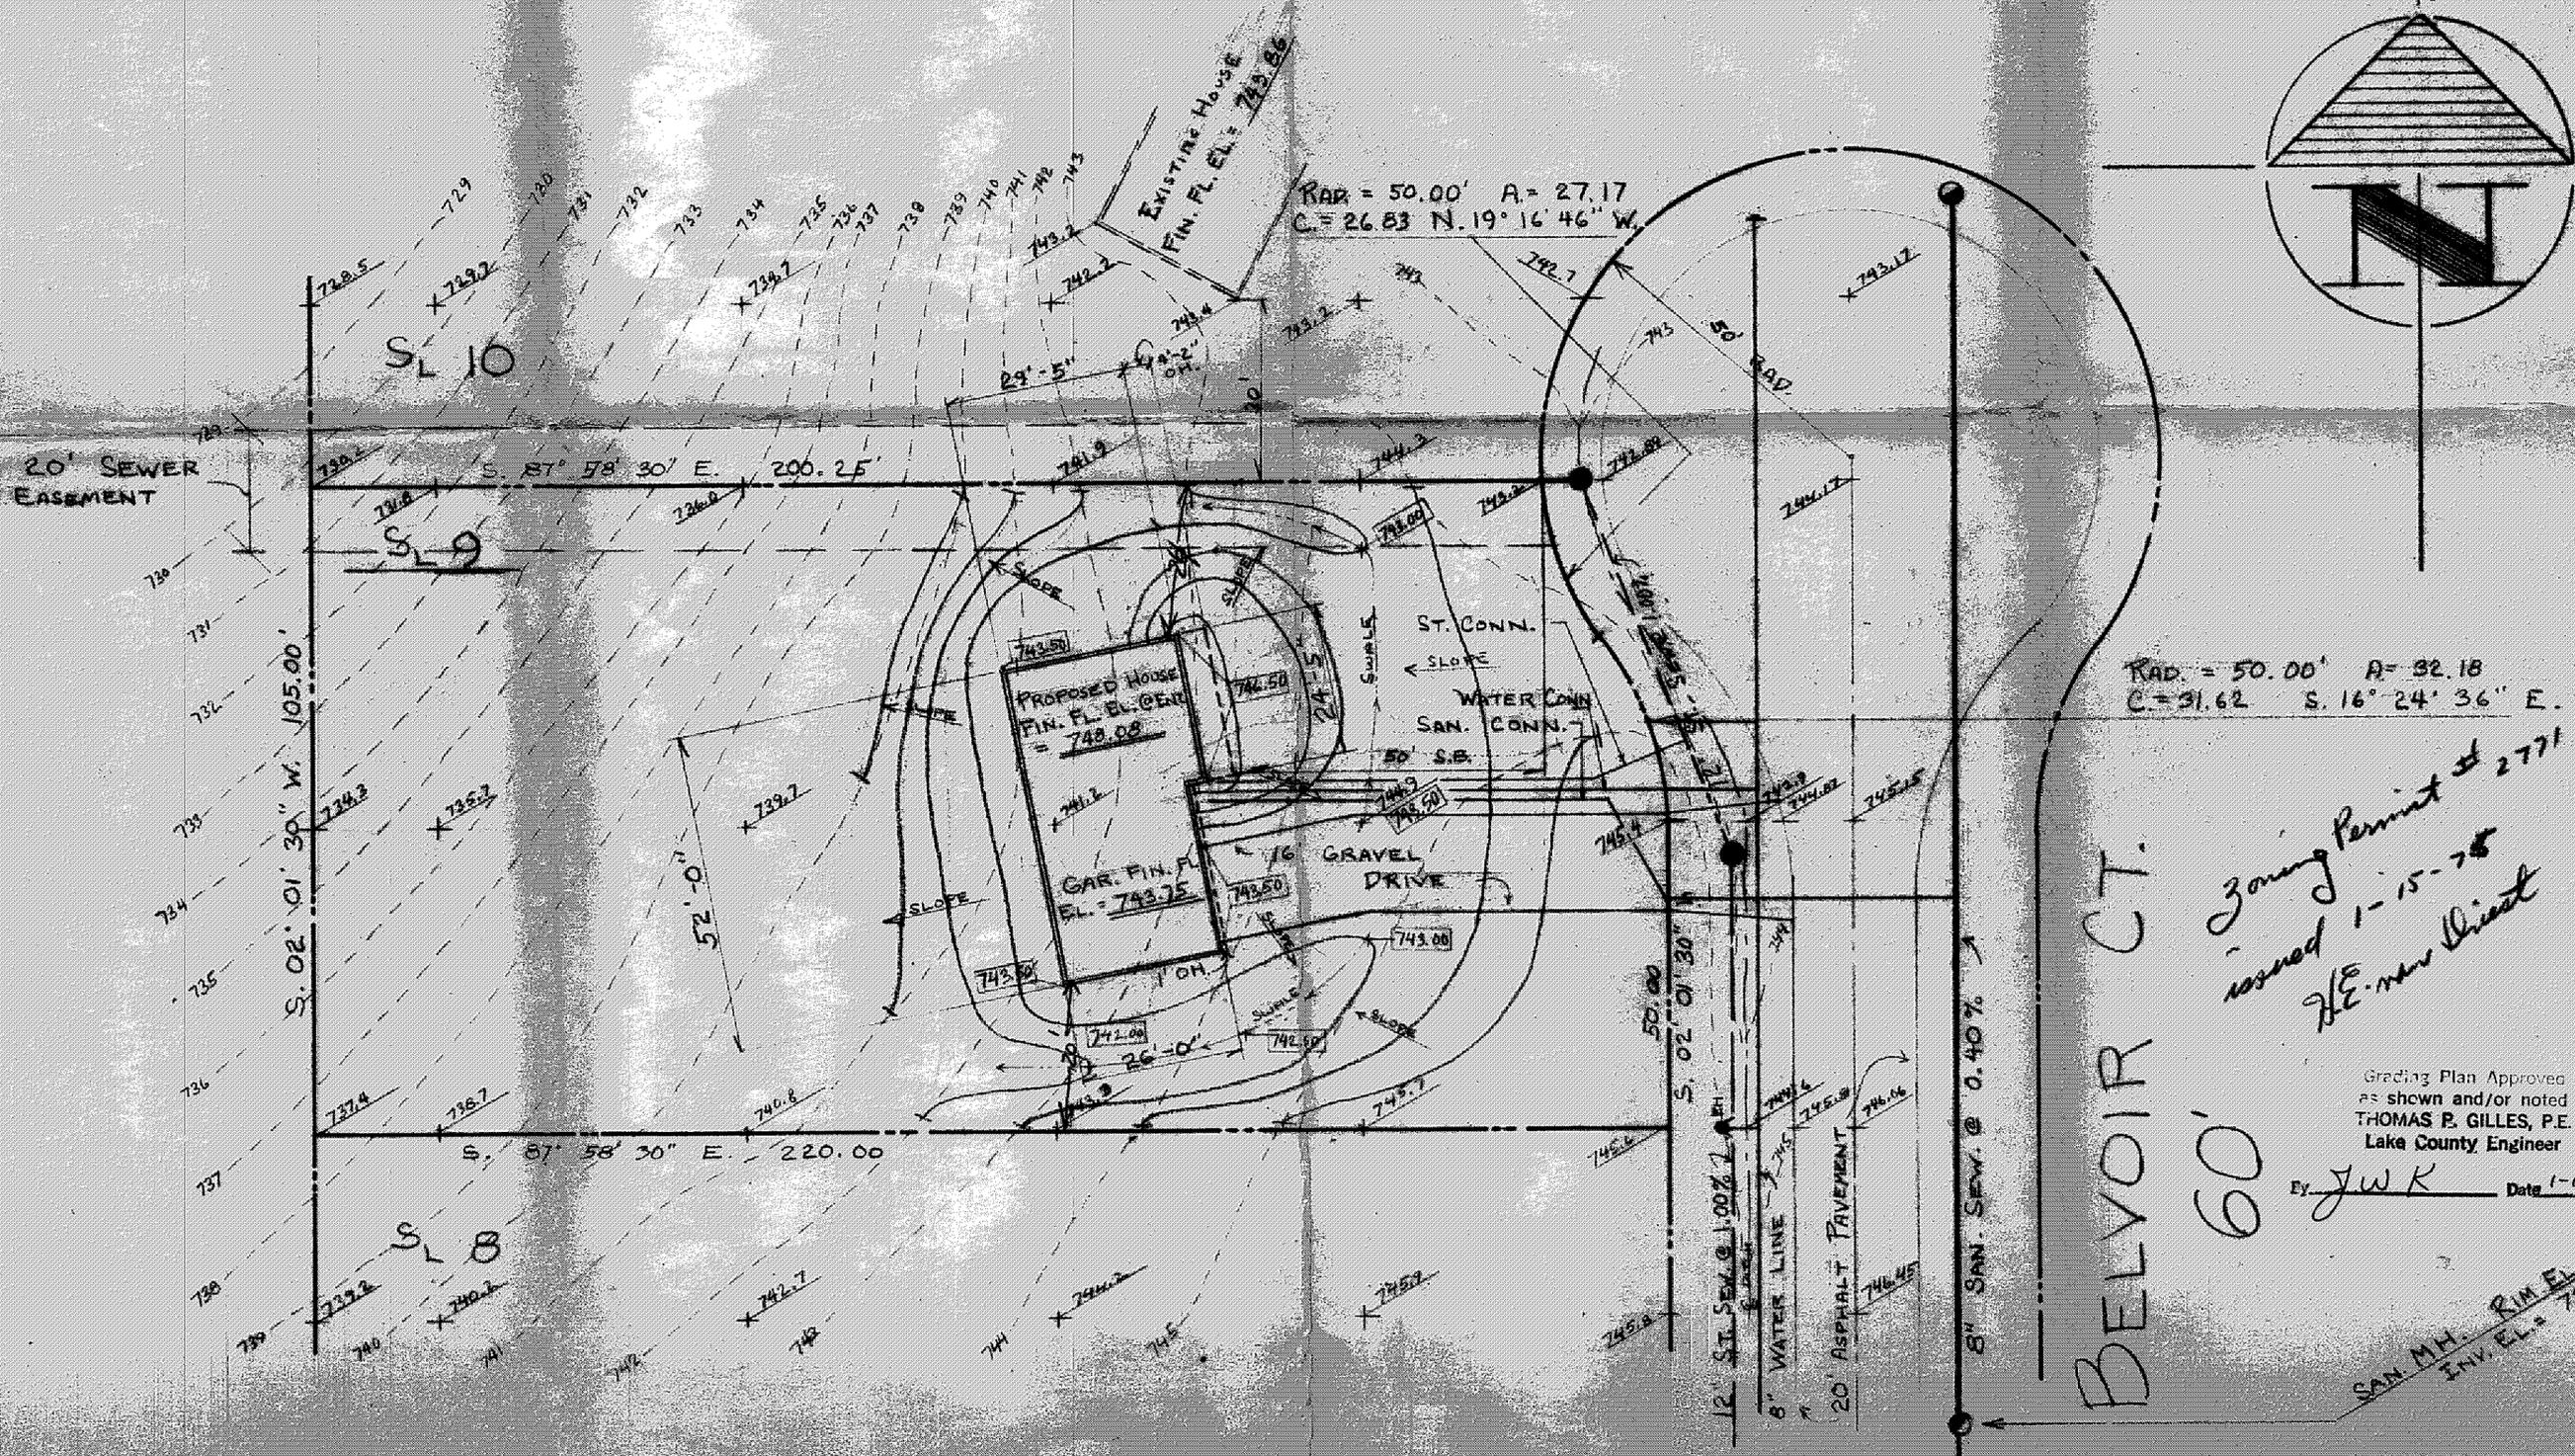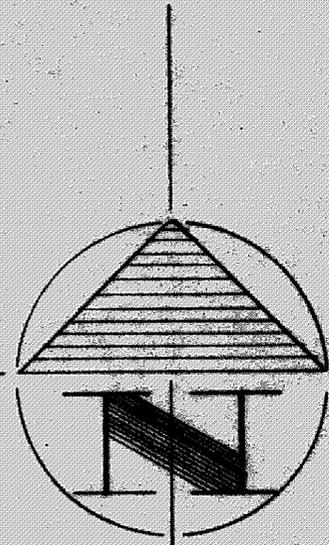

RAD. = 50.00' A = 32.18
 C = 31.62 S. 16° 24' 36" E.

*Zoning Permit # 2771
 issued 1-15-75
 J.E. New District*

Grading Plan Approved
 as shown and/or noted
 THOMAS P. GILLES, P.E.
 Lake County Engineer

By: *JWK* Date: 1-14-

SAN. MH. RIM EL. = 736.0
 INV. EL. = 736.0

BELVOIR CT.
 60'