


Grading Plan Approved
as shown and/or noted
THOMAS B. GILLES, P.E.
Lake County Engineer

N. 89°25'30"E 251.10'

JWK Date 3-12-74

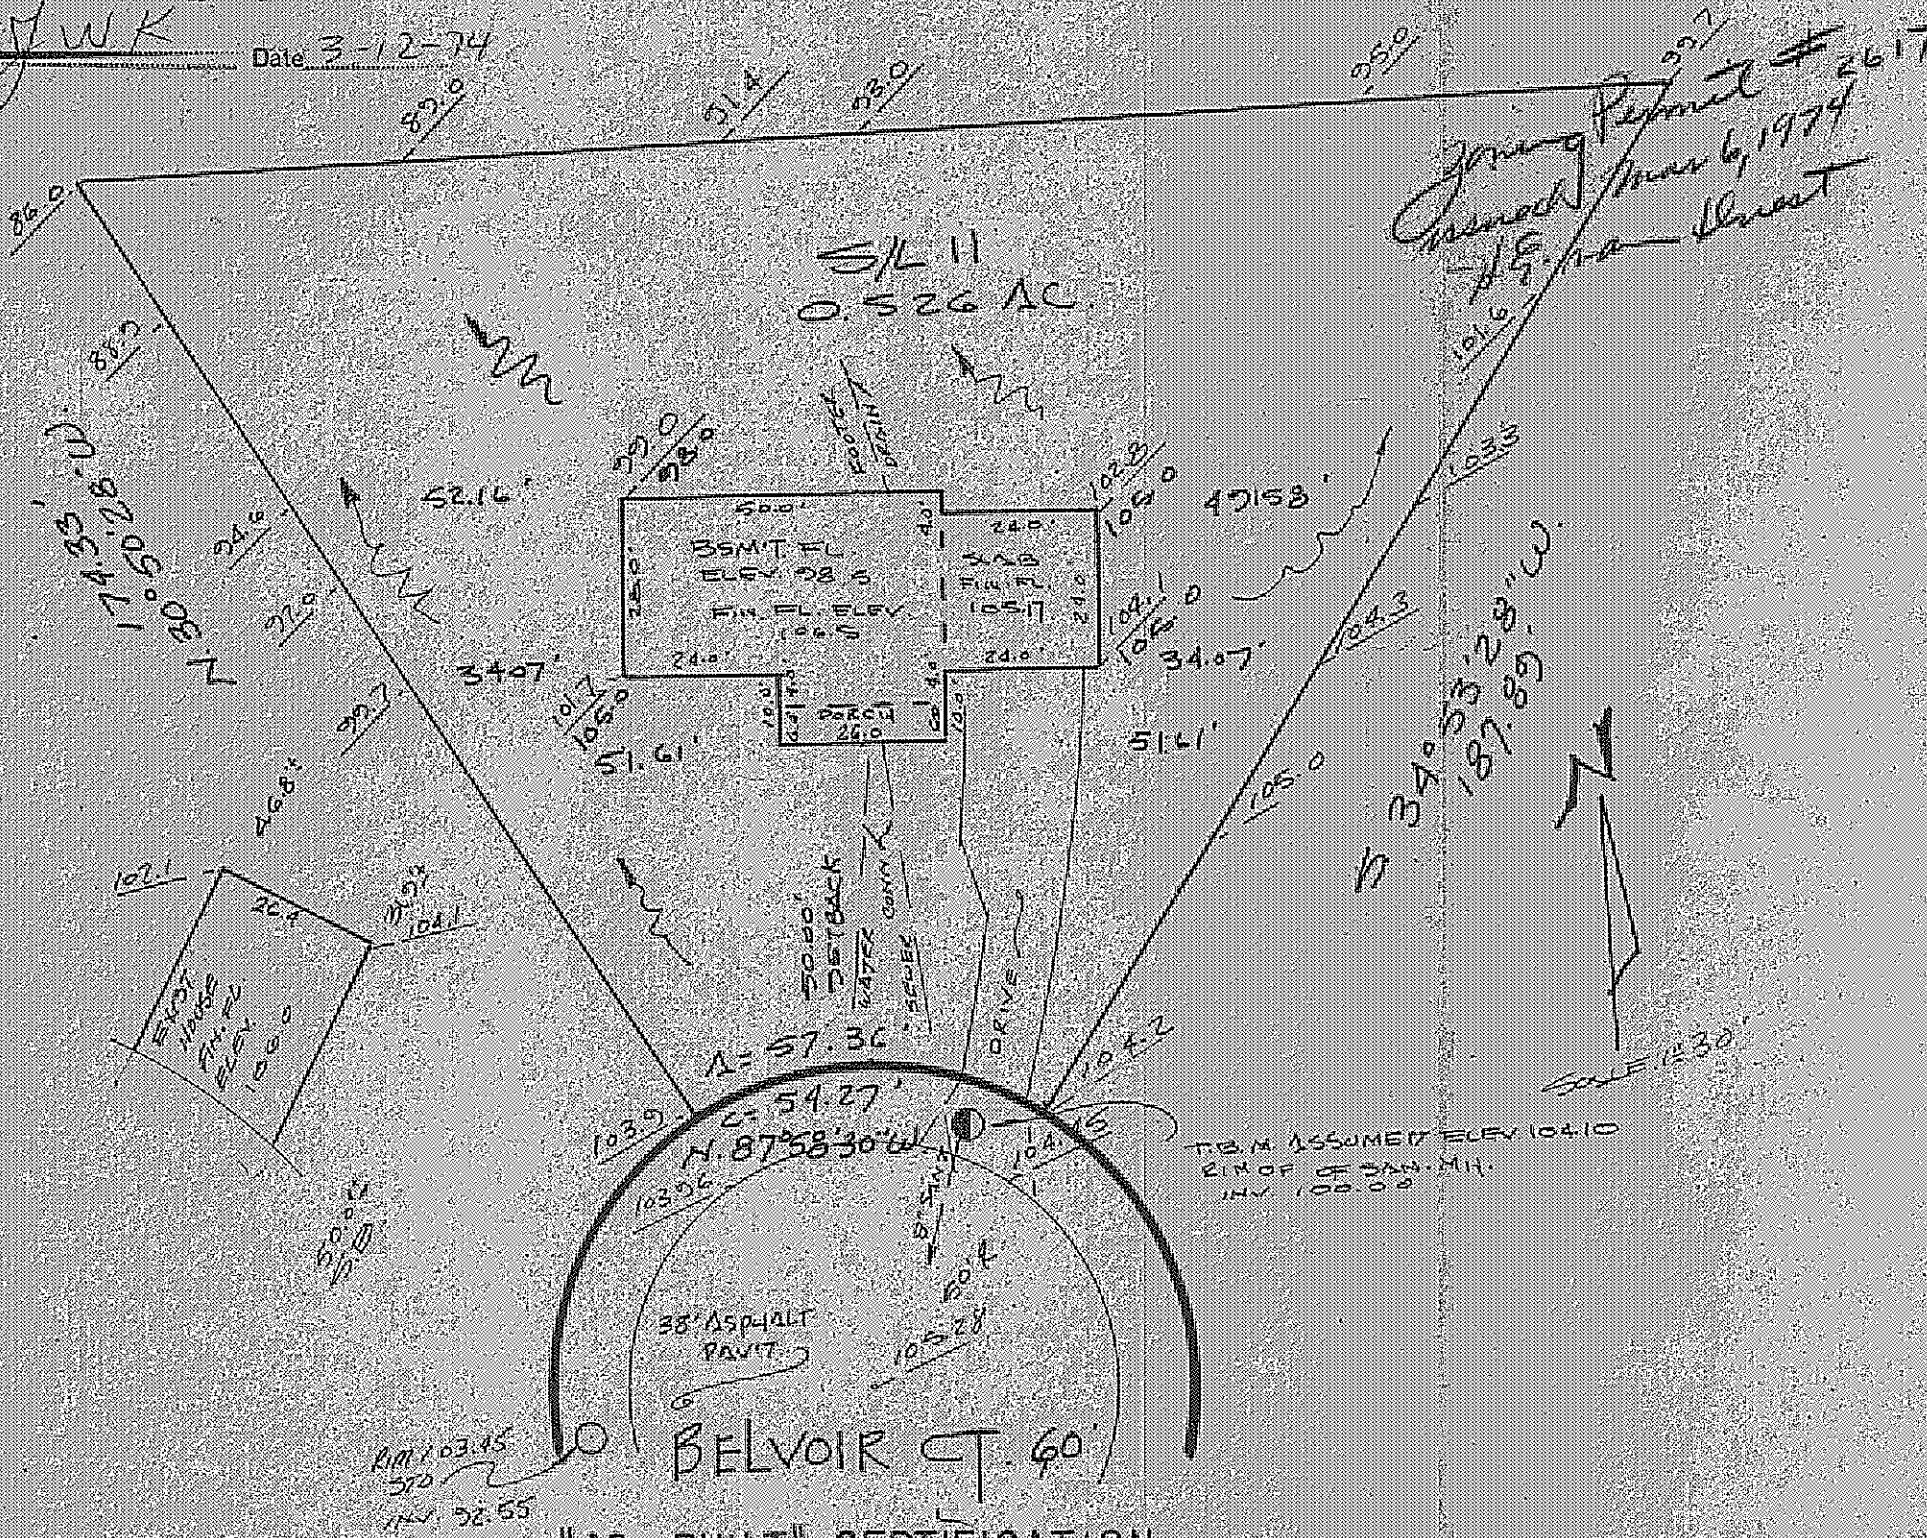

SITE PLAN

CONCORD

LAKE COUNTY, OHIO

TOWNSHIP

for: TOM REED

CLIENT

OWNER

ADDRESS

STREET

CITY

ZIP

CHERRY HILL SUBD.

SUBDIVISION 2-103 NAME

11 VOL - PG.

SUBLOT NO.

STREET

LOT

TRACT

VOLUME

PAGE

PERM PARCEL #

STREET

LEGEND

SANITARY MANHOLE

STORM MANHOLE

INLET OR CATCH BASIN

HYDRANT

EXISTING CONTOURS

PROPOSED CONTOURS

EXIST. ELEV. 100.0

PROP. ELEV.

WATER VALVE (GAS)

WATER METER (GAS)

AS BUILT ELEVATION

INDICATES

DIRECTION OF

SURFACE DRAINAGE

REMARKS

ALL BOUNDARY DATA SHOWN WAS OBTAINED FROM (DEEDS RECORDED
SUBDIVISION PLAT OR OTHER PUBLIC RECORDS)

DESIGN CERTIFICATION

THIS PLAT WAS PREPARED BY ME, AND IS CORRECT
TO THE BEST OF MY KNOWLEDGE AND BELIEF

NAME SURVEYOR REGISTRATION NO. PS# 5244

CHECK LIST

DIMENSIONS

BEARINGS

TIE TO NEAREST STREET

SUBLOT NO. PARCEL NO.

SURROUNDING OWNERS

BLDG DIMENSIONS FIN. GR.

BLDG TIES FLR GRADES

APRON TYPE WIDTH THICKNESS

SIDEWALK TYPE WIDTH THICKNESS

CULVERT TYPE DIA. LENGTH

WATER MAIN SIZE LOCATION

SAN SEWER SIZE % GR LOC

SAN MH CAST ELEV INV ELEV

SAN CONN SIZE LOC DEPTH

STORM SEWER SIZE % GR LOC

STORM MH CAST ELEV INV ELEV

PAVT TYPE GRADE CURBS

GASLINE LOC SIZE PRESSURE

SEPTIC TANK SIZE LOC

WELL LOCATION

REVISIONS

NO	DATE	BY
1		
2		
3		
4		
5		

PLAN PREPARED BY

DEBEVEC SALO & ASSOC, INC.

130 EAST JACKSON ST PAINESVILLE

DRAWN BY

SCALE

PHONE

CHK'D

DATE

NO.

CREW

APPD

DRAWING NO

CHIEF

4118

"AS BUILT" CERTIFICATION

I, HEREBY CERTIFY THAT THE CIRCLED GRADES ARE EXISTING FINISH
GRADES CHECKED IN FIELD ON 19 BY
SURVEYING AND ARE CORRECT TO THE BEST OF MY KNOWLEDGE AND BELIEF

REGISTERED SURVEYOR

REG. NO.