
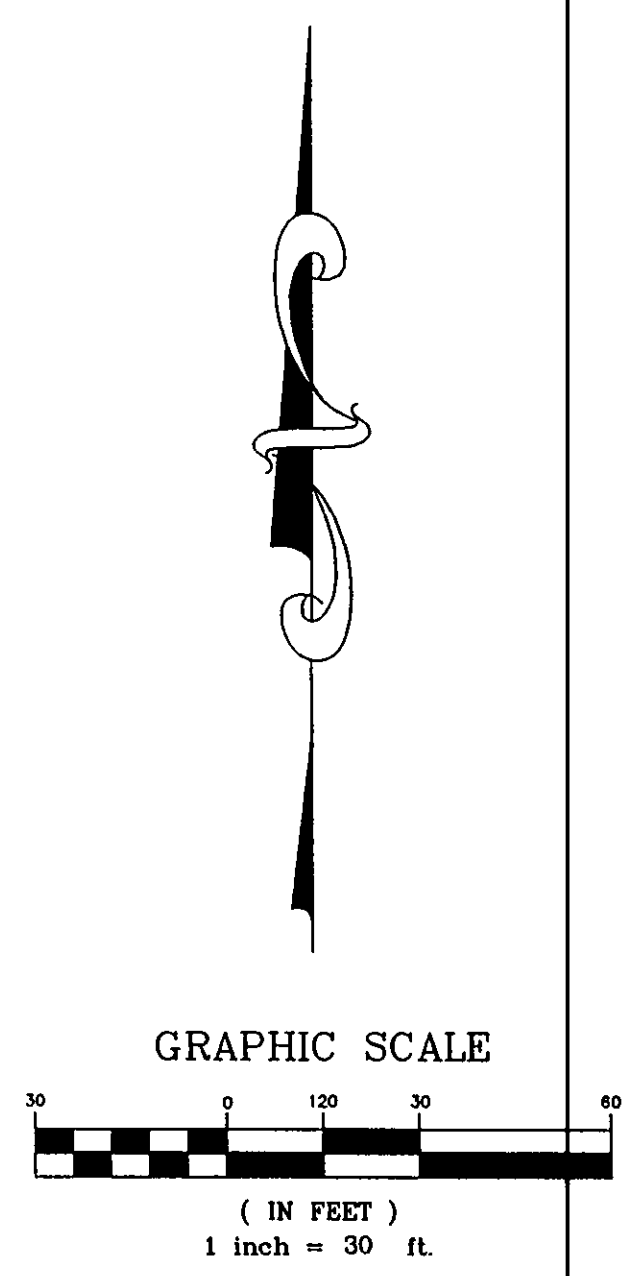


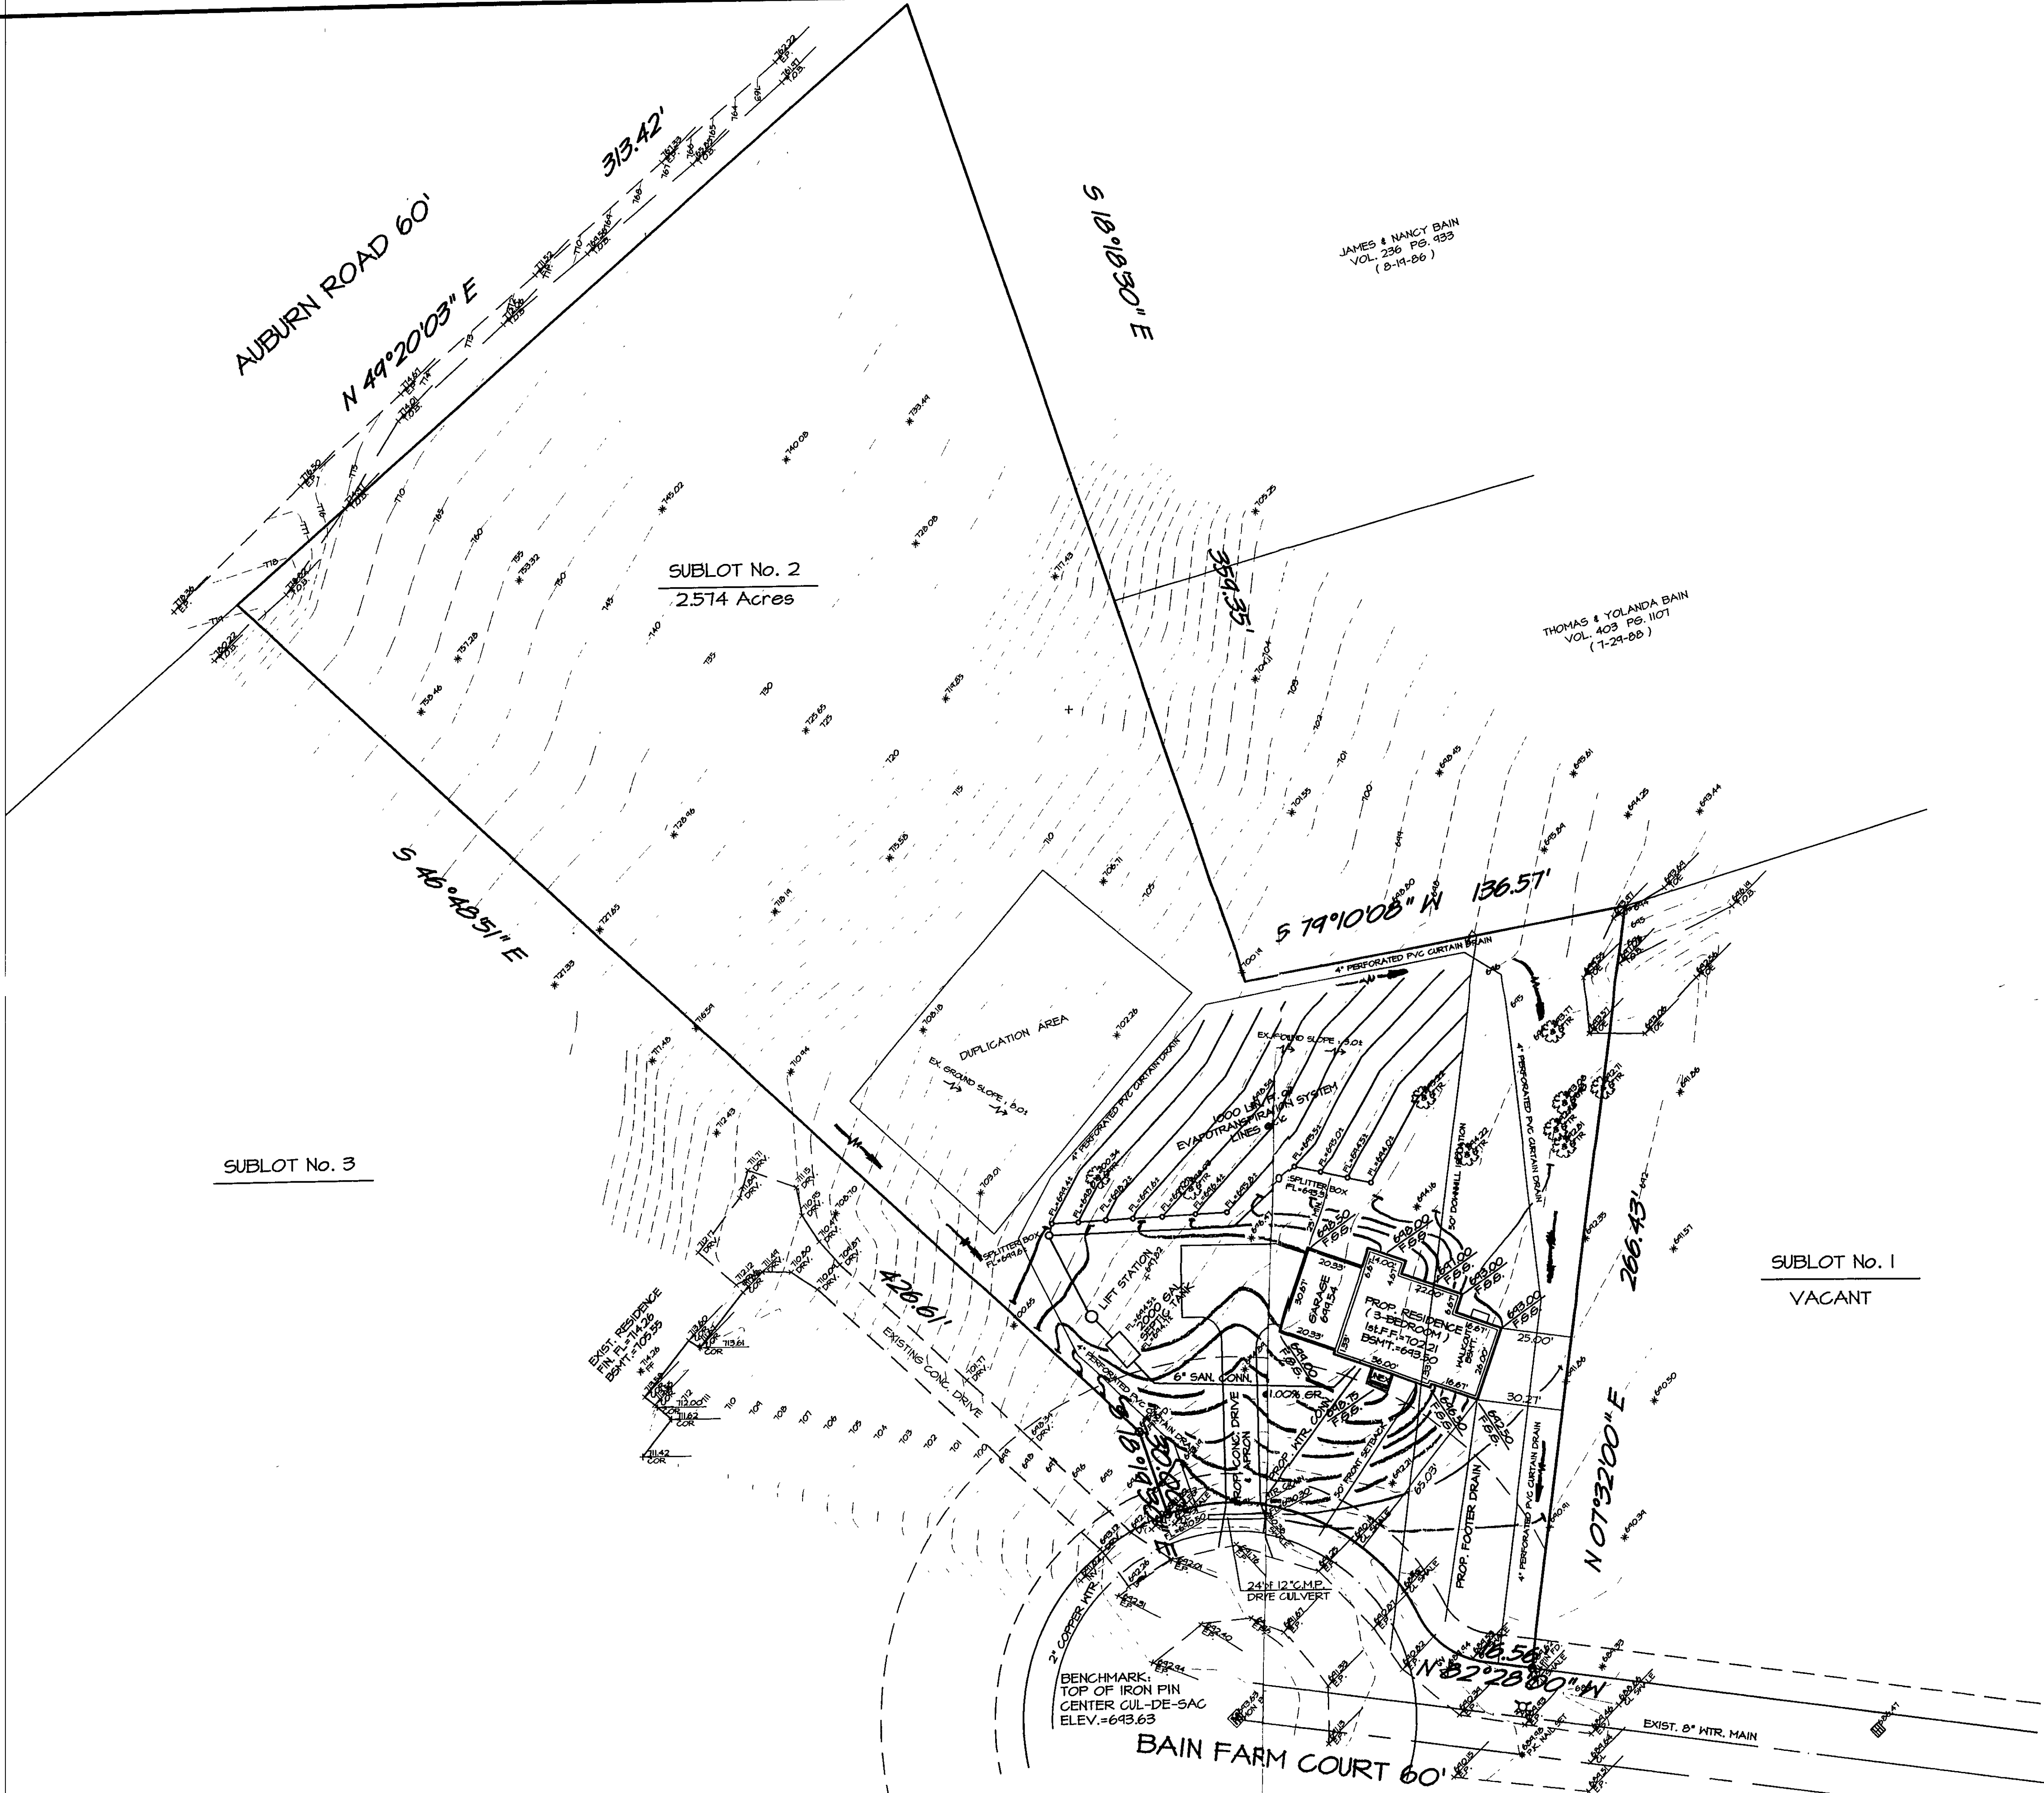

REVIEWED AND ACCEPTED
LAKE COUNTY GENERAL
HEALTH DISTRICT
Date: 6-8-98
By: David B. Morris
SEWAGE DISPOSAL PERMIT MUST BE
OBTAINED BY A LAKE COUNTY LICENSED
ENGINEER BEFORE INSTALLATION IS
STARTED.

ZONING PERMIT #0698-5110
ISSUED 6/19/98
SUBJECT TO APPROVAL BY:
Lake County Sanitary Eng. ☐
Lake County Eng. Dept. ☒
Lake County Planning Comm. ☐
Lake County Bldg. Dept. ☒
Grading Plan As shown and/or
THOMAS P. GILL
Lake County Engineer
By: G.H. Date: 6-23-98

LAKE, INC.
ENGINEERS & SURVEYORS
30601 ERLID AVENUE WICKLIFFE, OHIO 44092
PHONE: (216) 585-2100 FAX: (216) 585-5122

Rev. No.	Description	Date	By	CHKD
1	REV. SITE PLAN, HOUSE LOCATION, SEPTIC SYSTEM & GRADES PER HEALTH DEPT.	01/08/98	D. Abbott	
2	REV. SITE PLAN, HOUSE LOCATION, SEPTIC SYSTEM & GRADES PER BUILDER.	05/04/98	D. Abbott	
3	REV. SITE PLAN, SEPTIC SYSTEM ISOLATION DISTANCE PER LAKE COUNTY HEALTH DEPT.	05/24/98	D. Abbott	

SITE PLAN for
SIGNATURE HOMES Inc.
BAIN FARM SUBDIVISION, CONCORD

Drawn By: D. Abbott
Filename: 97\123
Checked By:
Approved By:
Date: DEC. 4, 1997

SUBLOT # 2

Rev 5/2/98

PRINTED
MAY 29 1998

Scale:	1" = 30'
Sheet No.	Of
1	2
#57-123	