

SITE PLAN

COLUMBIA COUNTY, OHIO

for: Ray Jones
OWNER
721 Southwood Dr. College
ADDRESS
CITY

PROPOSED LOT: 2.25 AC
SUBDIVISION: 2.25 AC
SHEET NO.: 1
VOLUME: 1
PAGE: 1
SHEET NO.: 1
STREET: 1

LEGEND

SANITARY MANHOLE
STORM MANHOLE
INLET ON CATCH BASIN
HYDRANT
EXISTING CONTOURS
PROPOSED CONTOURS
EXIST. ELEV. 100.00 PROP. ELEV. 100.00

WATER VALVE (GAS)
WATER METER (GAS)
AS BUILT ELEVATION
INDICATES DIRECTION OF SURFACE DRAINAGE

REMARKS

ALL BOUNDARY DATA SHOWN WAS OBTAINED FROM IDEAS, RECORDED SUBDIVISION PLAT ON OTHER PUBLIC RECORDS
LOCATIONS AS SHOWN OF ADJACENT WELLS AND SEPTIC TANKS OBTAINED FROM LAKE COUNTY HEALTH DEPARTMENT

DESIGN CERTIFICATION

THIS PLAN WAS PREPARED BY ME, AND IS CORRECT TO THE BEST OF MY KNOWLEDGE AND BELIEF
NAME Thomas P. Gilles SURVEYOR REGISTRATION NO. 26343

CHECK LIST

NO. OF BEDROOMS
NO. OF BATHS
NO. OF GARAGES
NO. OF POOLS
NO. OF DECKS
NO. OF PATIOS
NO. OF PORCHES
NO. OF STAIRS
NO. OF ELEVATORS
NO. OF HALLS
NO. OF CLOSETS
NO. OF LINEN CLOSETS
NO. OF PANTRY
NO. OF BREAKFAST ROOM
NO. OF DINING ROOM
NO. OF LIVING ROOM
NO. OF KITCHEN
NO. OF ENTRY
NO. OF PORCH
NO. OF PATIO
NO. OF DECK
NO. OF POOL
NO. OF DOG HOUSE
NO. OF SHED
NO. OF GARAGE
NO. OF POOL
NO. OF DECK
NO. OF PATIO
NO. OF PORCH
NO. OF ELEVATOR
NO. OF HALL
NO. OF CLOSET
NO. OF LINEN CLOSET
NO. OF PANTRY
NO. OF BREAKFAST ROOM
NO. OF DINING ROOM
NO. OF LIVING ROOM
NO. OF KITCHEN
NO. OF ENTRY
NO. OF PORCH
NO. OF PATIO
NO. OF DECK
NO. OF POOL
NO. OF DOG HOUSE
NO. OF SHED
NO. OF GARAGE

PLAN PREPARED BY:

BABCOCK • JONES & ASSOCIATES, INC.
PAINESVILLE, OHIO

NO. DATE BY
1 10/10/83 T.P.G.
2 10/10/83 T.P.G.
3 10/10/83 T.P.G.
4 10/10/83 T.P.G.
5 10/10/83 T.P.G.

"AS BUILT" CERTIFICATION

I, HEREBY CERTIFY THAT THE CIRCLED GRADES ARE EXISTING FINISH GRADES CHECKED IN THE FIELD ON 10/10/83 AND ARE CORRECT TO THE BEST OF MY KNOWLEDGE AND BELIEF.

REGISTERED SURVEYOR

REG. NO.

T.B.M. - 124 SHM (M)
ELEV 773.21


ZONING PERMIT #4639

ISSUED 6-21-83

SUBJECT TO APPROVAL BY:

Lake County Sanitary Eng. ☐
Lake County Eng. Dept. ☒
Lake County Planning Comm. ☐
Lake County Bldg. Dept. ☒

Lawrence M. Jones

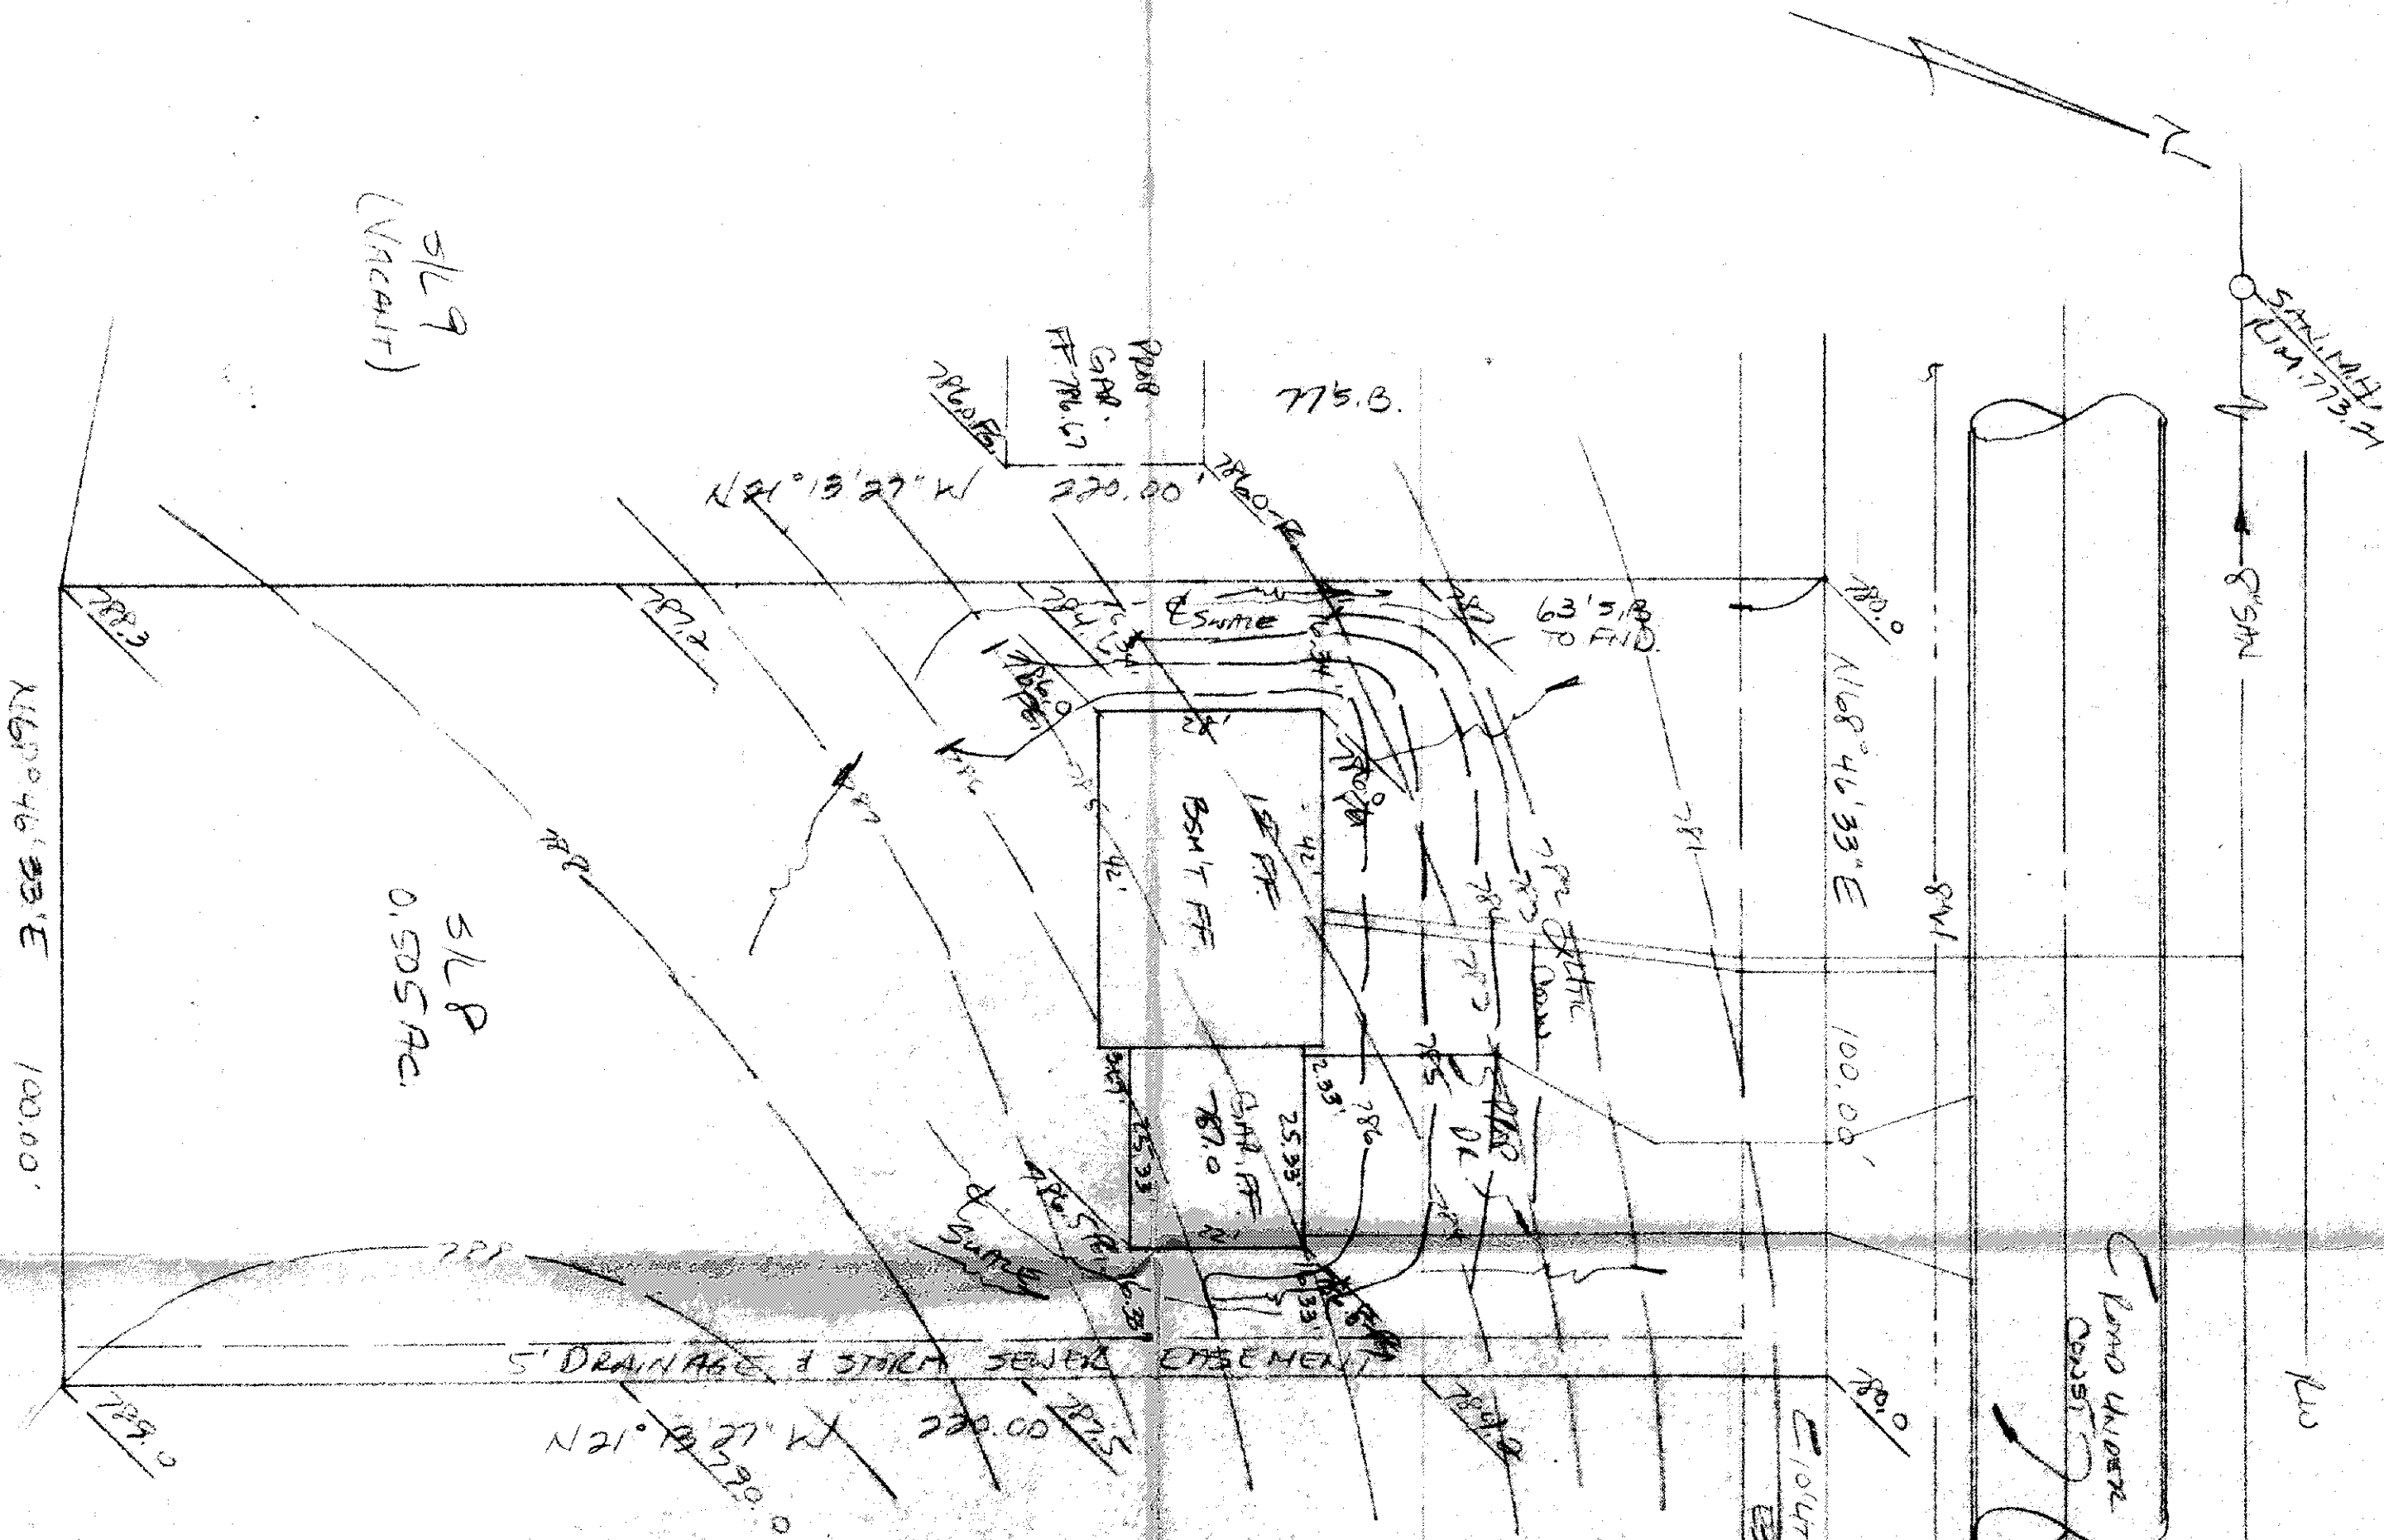

Grading Plan Approved as shown and/or noted THOMAS P. GILLES, P.E. Lake County Engineer Date: 23 Jun 83
By: TCO
OCCUPANCY PERMIT NOT TO BE ISSUED UNTIL ALL CONSTRUCTION IMPROVEMENTS COMPLETED