


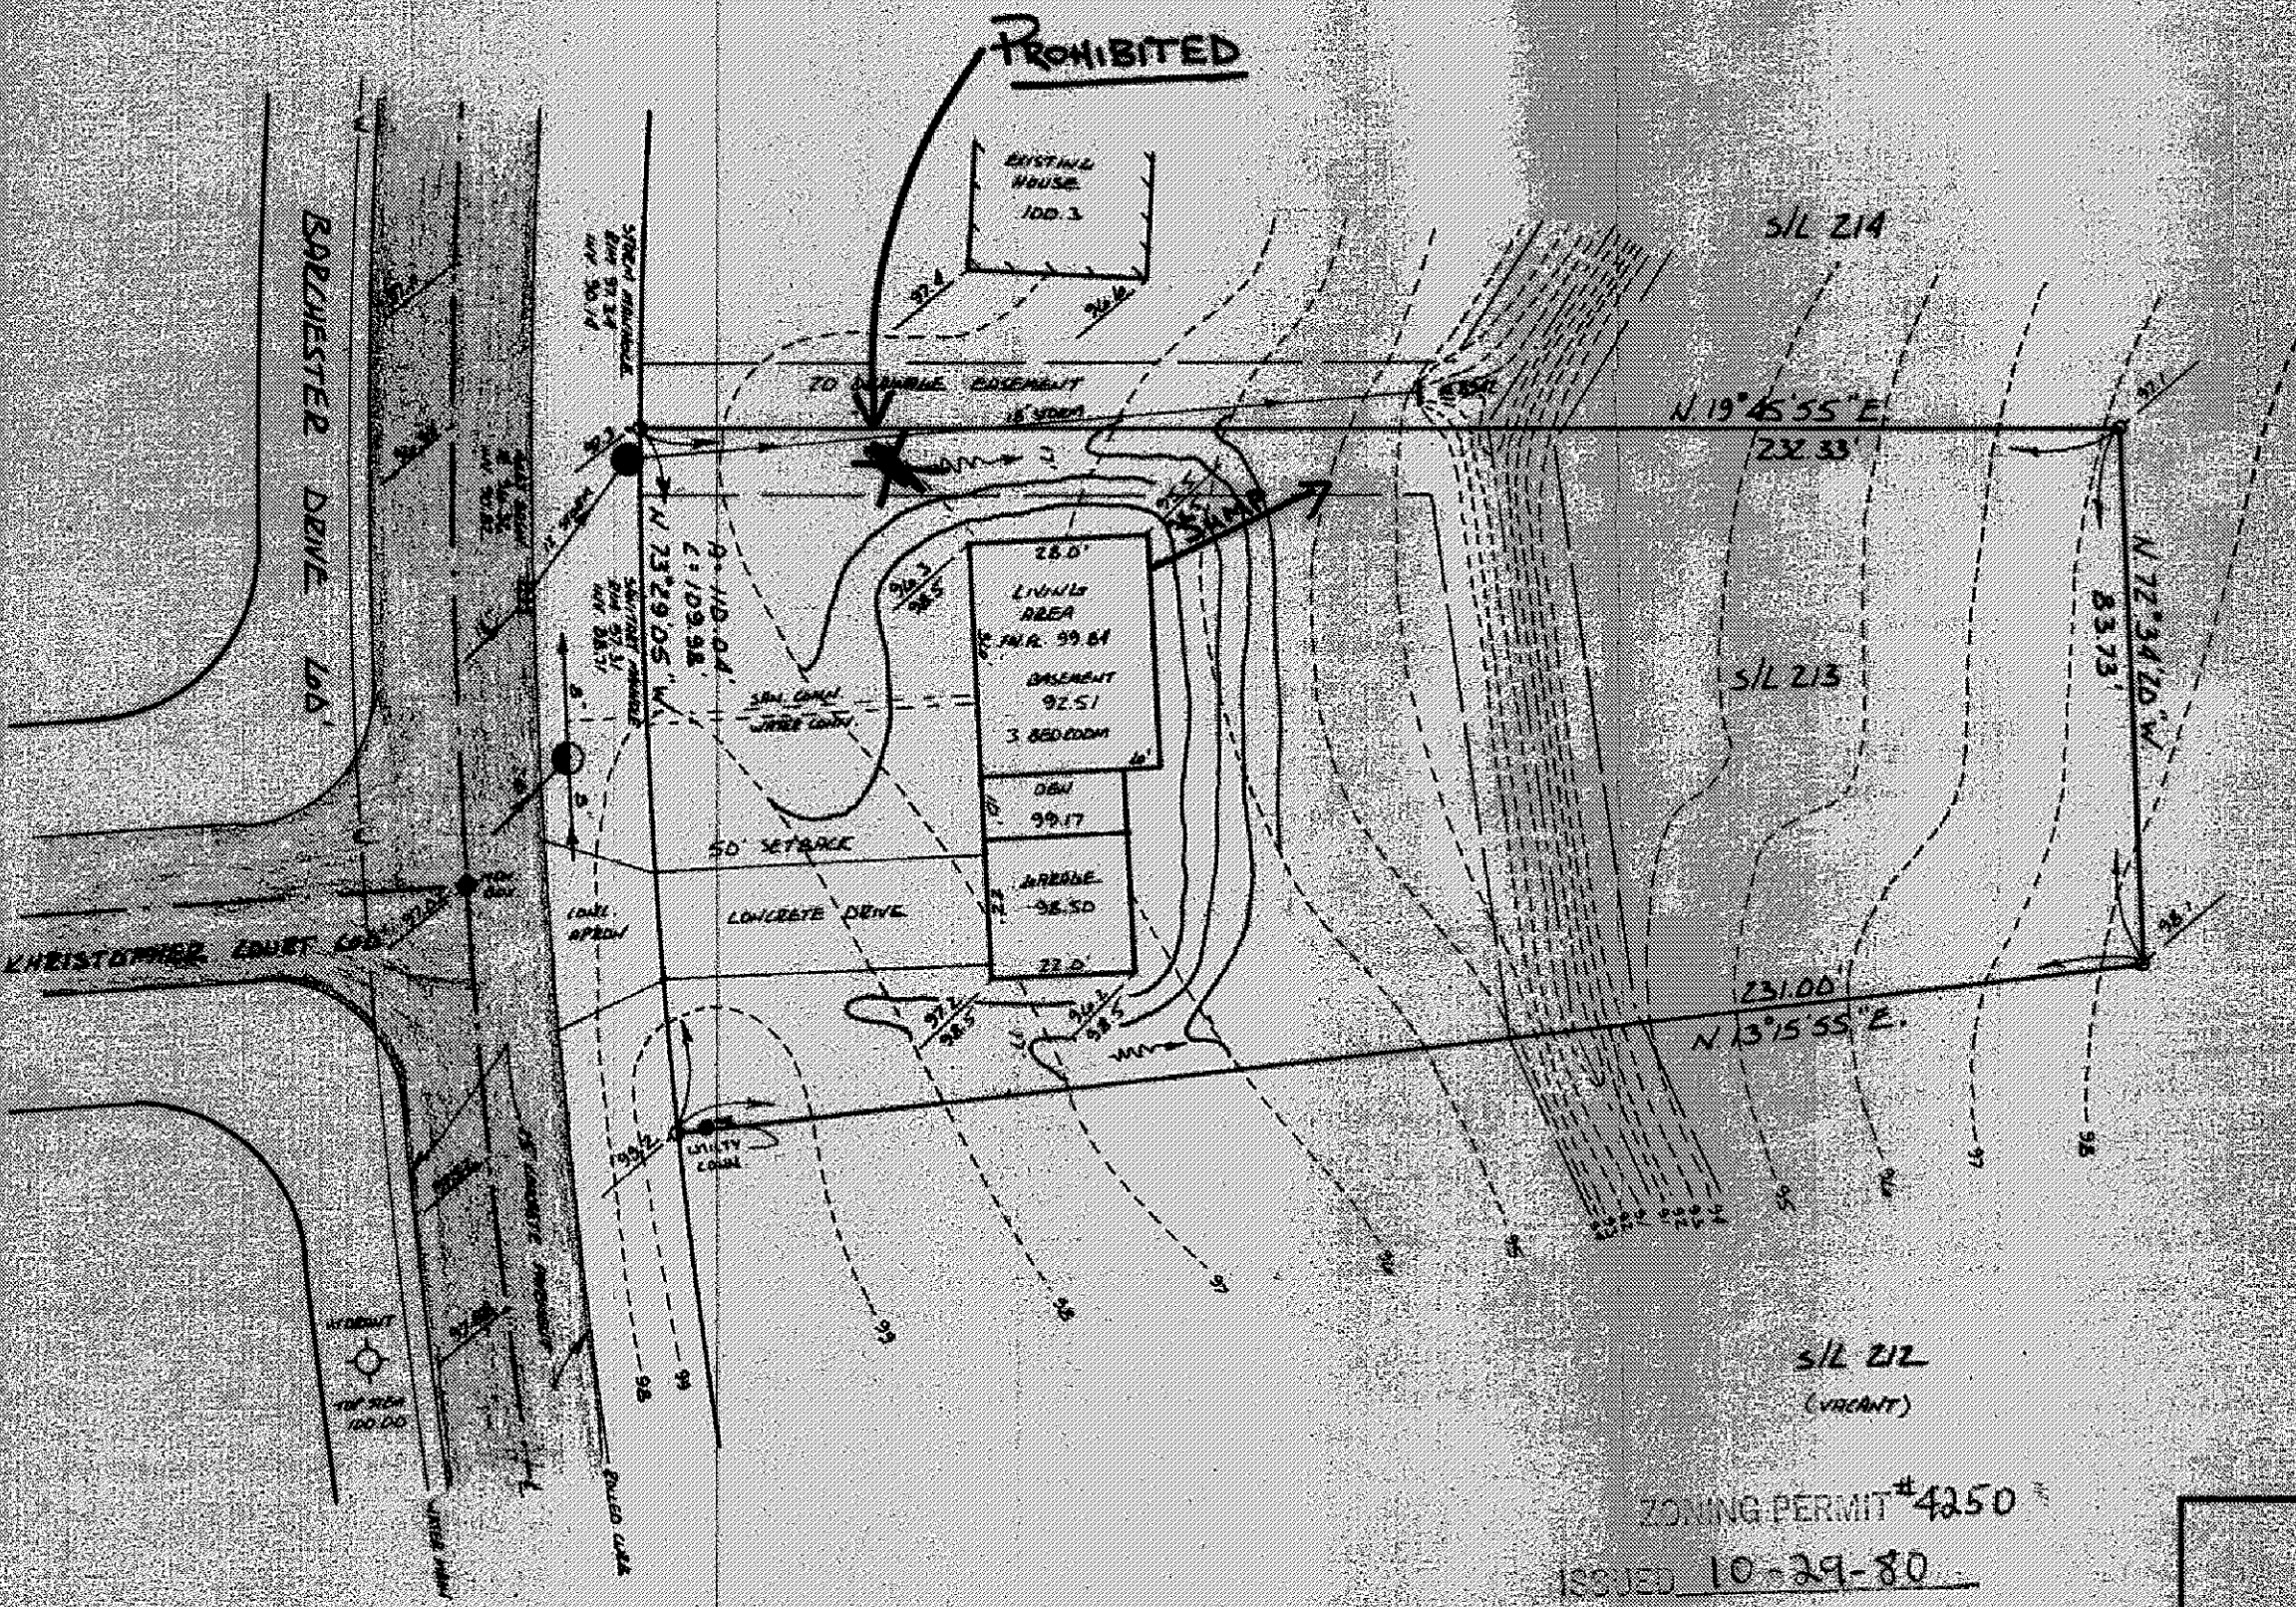


Grading Plan Approved
as shown and/or noted
THOMAS P. GILLES, P.E.
Lake County Engineer
Date 10-31-80

By *[Signature]*

I HEREBY CERTIFY THAT THIS PLAN
WAS PREPARED BY ME AND IS CORRECT
TO THE BEST OF MY KNOWLEDGE
AND BELIEF.

[Signature]
P.E. SURVEYOR S-63516

JOHN C. SKONIECZNY
7739 VIEWMOUNT DRIVE
PRINCEVILLE OHIO 44077
352-7742

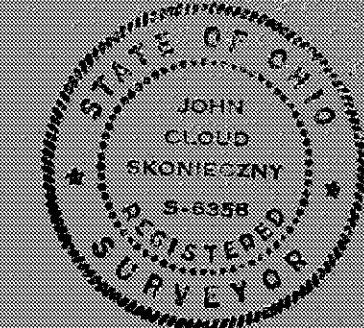

0 1/4" PW SET
EXISTING LEADER
PROPOSED
WATER SWALE

ZONING PERMIT #4250
ISSUED 10-29-80

SUBJECT TO APPROVAL BY:
Lake County Surveyor Eng. ☐
Lake County Health Dept. ☒
Lake County Planning Comm. ☐
Lake County Eng. Dept. ☒
Temo & Marano

SITE PLAN FOR CHARLES RUDOLPH		
SCALE: 1" = 30'	APPROVED BY <i>JCS</i>	DRAWN BY SJK
DATE: OCTOBER 1980	PLAT Z-5-1	
OF SUBLOT 213 IN THE CHILDRS HILLS SUBDIVISION NO. 4 TOWNSHIP OF CONCORD LAKE COUNTY OHIO		
DRAWING NUMBER 80-320		