

S/L 3 9851 Baxter Rd.

Grading Plan Approved
as shown and/or noted
THOMAS P. GILLEN
Lake County Eng.


By *720*

1.24.83



BLECK

CONCORD, OHIO

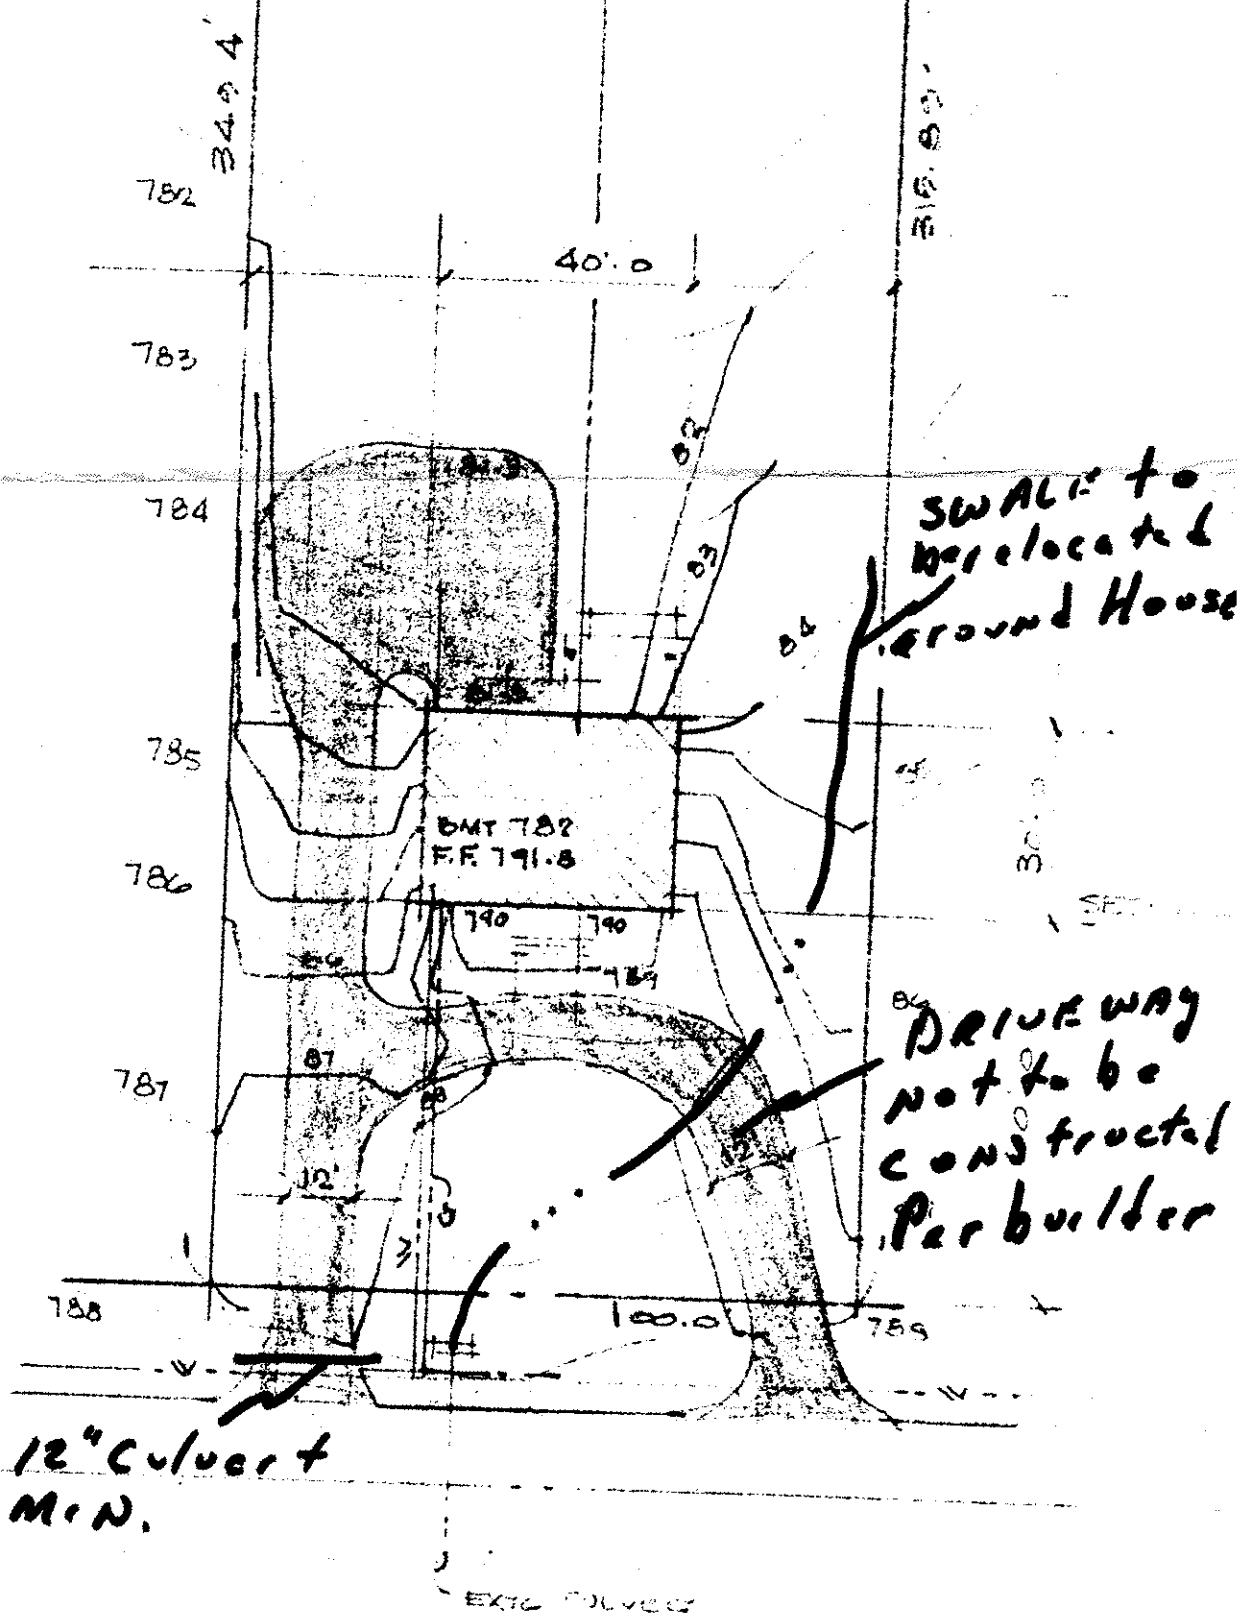

ZONING PERMIT #4679

ISSUED 8-16-83

SUBJECT TO APPROVAL BY:

Lake County Sanitary Eng. ☐

Lake County Eng. Dept. ☒

Lake County Planning Comm. ☐

Lake County Eldg. Dept. ☒

Tene S. Marano

SITE PLAN
1" = 30'-0"