


Address Mr. Jones
of St. 84 the could not
the down spouts into storm sewer
only pump pump discharge
8-23-80



Grading Plan Approved
as shown and/or noted
THOMAS P. GILLES, P.E.
Lake County Engineer
Date 10/1/84

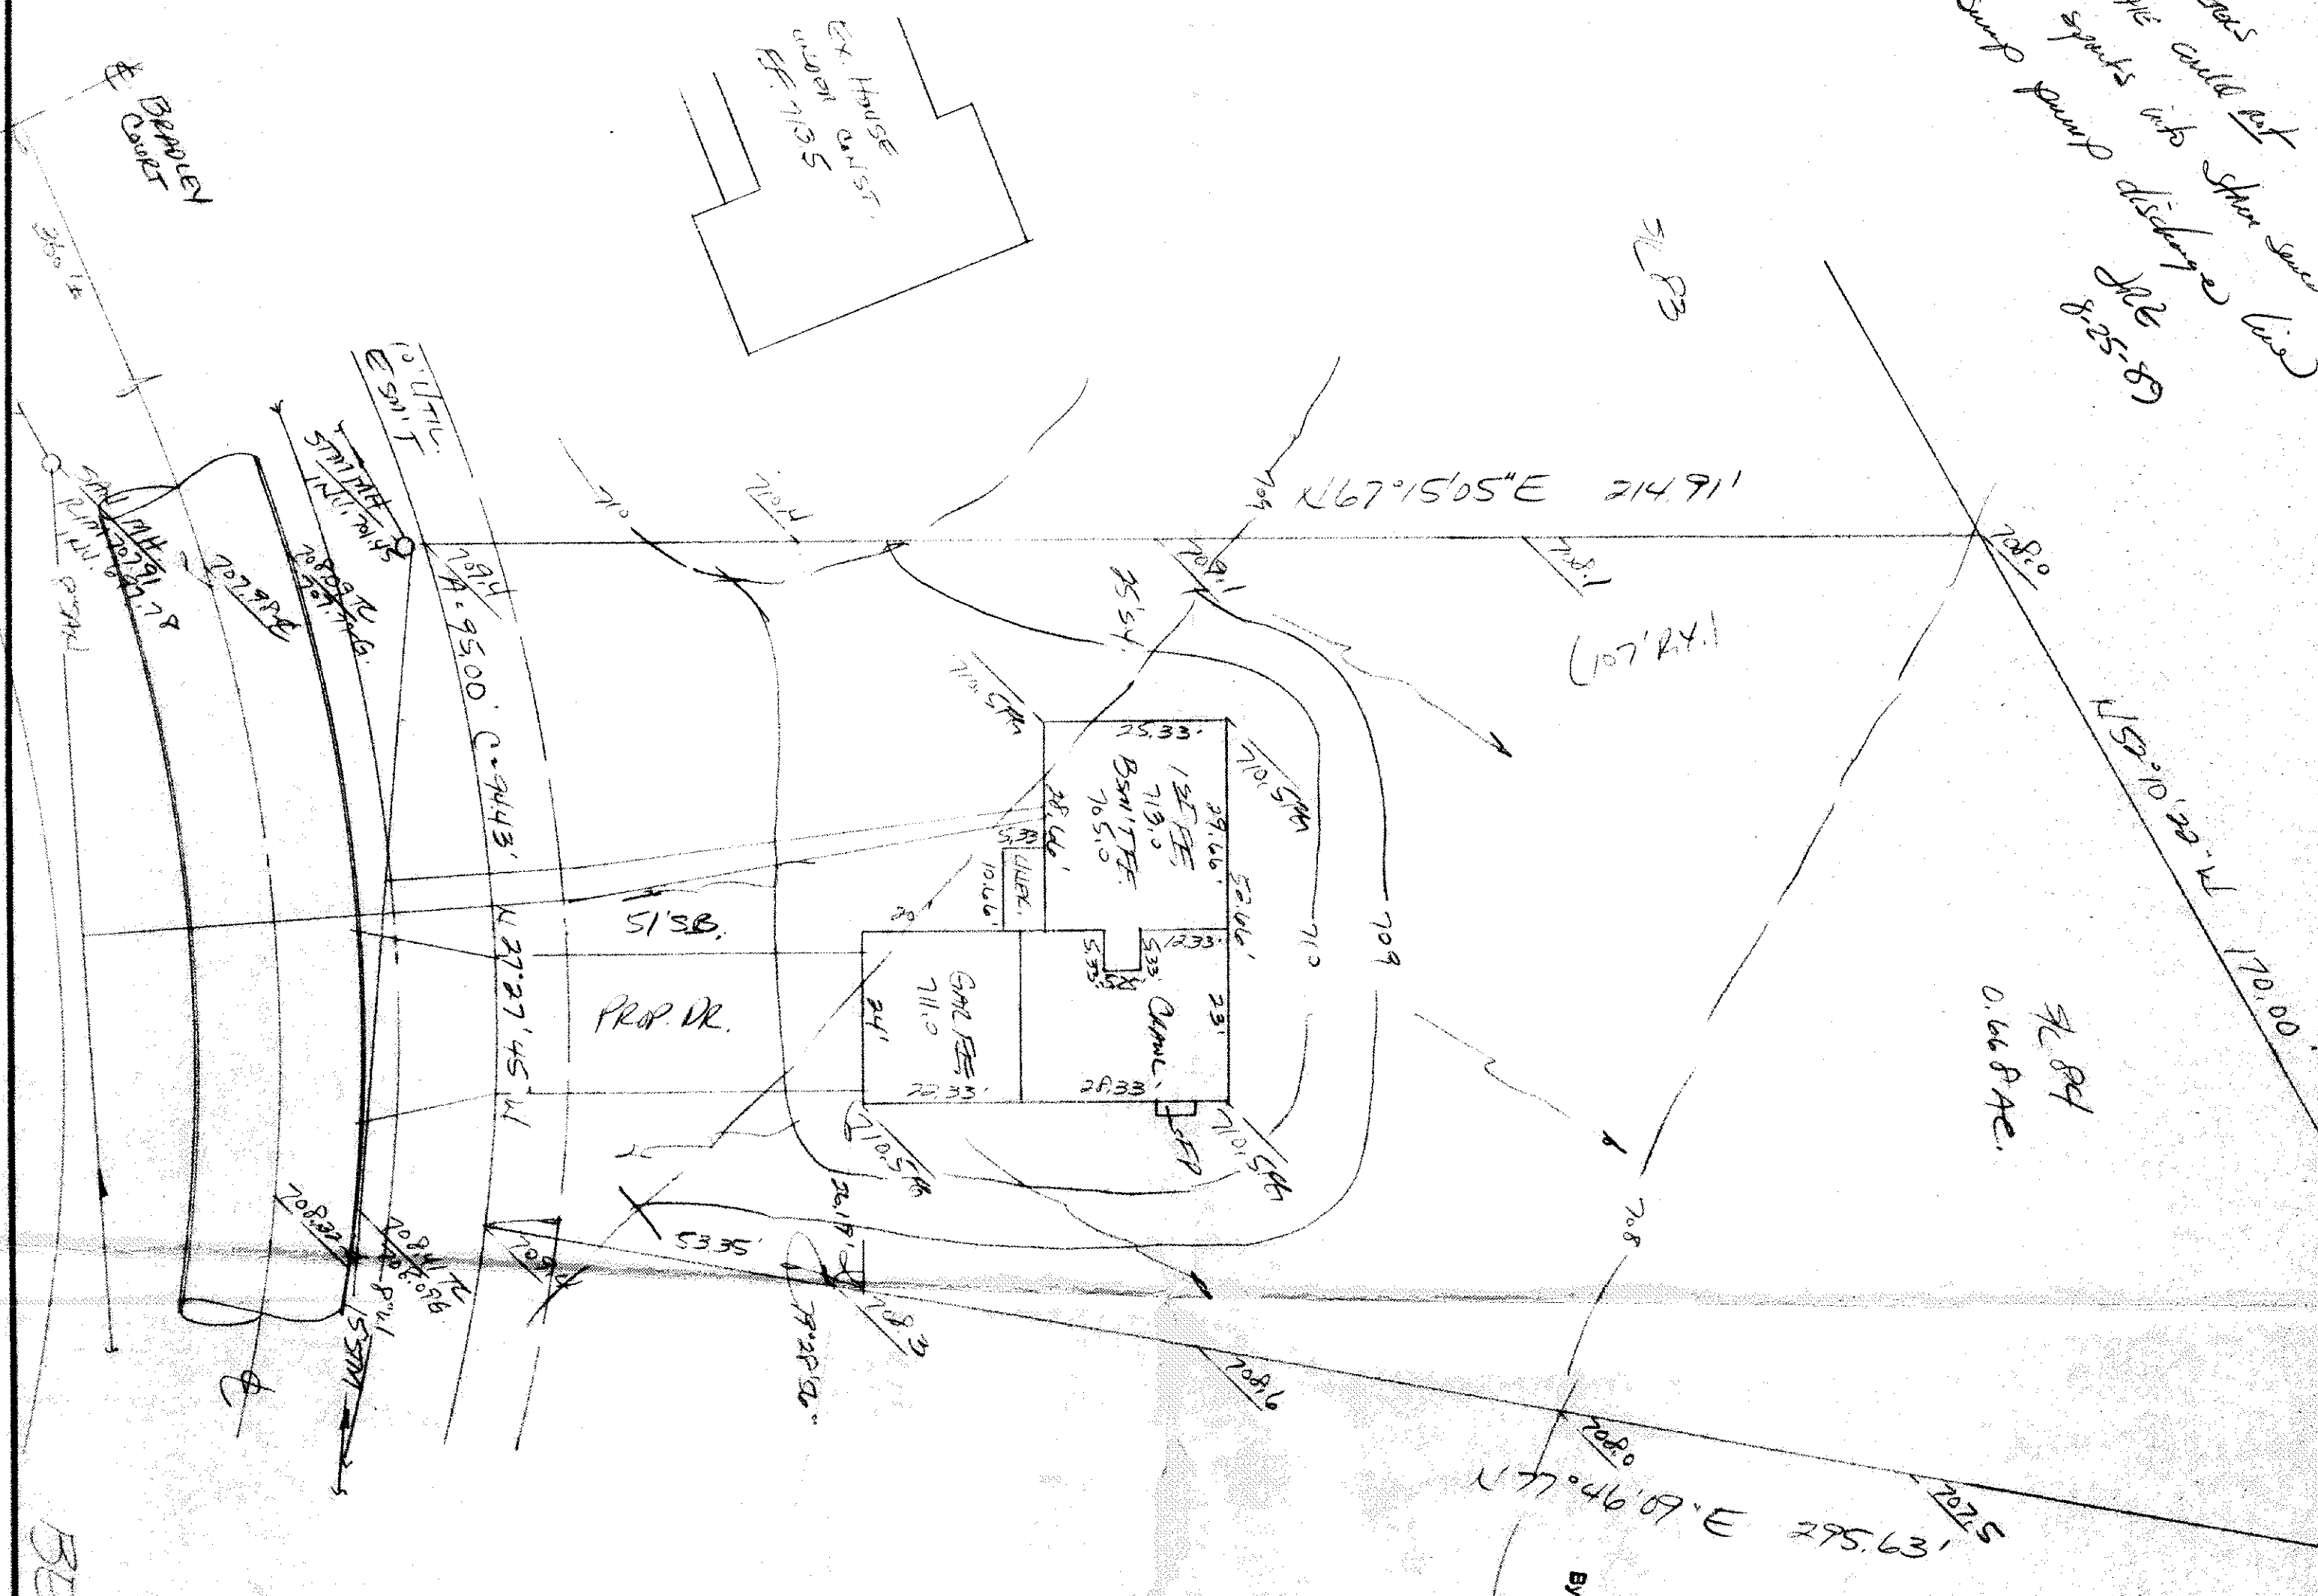

BEVER DR-60'

SITE PLAN

45-1-1987

Caledon Township, Lake County, Ohio

FOR: THOMAS P. GILLES

ADDRESS	STREET	CITY	ZIP
SUBDIVISION			
VOLUME			
PAGE			
SHEET NO.			
SHEET			

LEGEND	WATER VALVE (GAS)	WATER METER (GAS)
STORM MANHOLE	AS BUILT ELEVATION	INDICATES DIRECTION OF SURFACE DRAINAGE
INLET OR CATCH BASIN		
HYDRAULIC		
EXISTING CONTOURS		
PROPOSED CONTOURS		
EXIST. ELEV.		
PROP. ELEV.		

REMARKS

ALL BOUNDARY DATA SHOWN WAS OBTAINED FROM IDEAS, RECORDED SUBDIVISION PLAT OR OTHER PUBLIC RECORDS

LOCATIONS AS SHOWN OF ADJACENT WELLS AND SEPTIC TANKS OBTAINED FROM LAKE COUNTY HEALTH DEPARTMENT

DESIGN CERTIFICATION

THIS PLAT WAS PREPARED BY ME, AND IS CORRECT TO THE BEST OF MY KNOWLEDGE AND BELIEF.

NAME THOMAS P. GILLES SURVEYOR REGISTRATION NO. 46343

CHECK LIST

NO. OF BEDROOMS	WATER MAIN SIZE, LOCATION
SEWER SIZE	SEWER SIZE, LOCATION
SEWER INVERT ELEV.	SEWER INVERT ELEV.
SEWER MANHOLE	SEWER MANHOLE
SEWER INLET OR CATCH BASIN	SEWER INLET OR CATCH BASIN
SEWER HYDRAULIC	SEWER HYDRAULIC
SEWER EXISTING CONTOURS	SEWER EXISTING CONTOURS
SEWER PROPOSED CONTOURS	SEWER PROPOSED CONTOURS
SEWER EXIST. ELEV.	SEWER EXIST. ELEV.
SEWER PROP. ELEV.	SEWER PROP. ELEV.

PLAN PREPARED BY:

BABCOCK • JONES & ASSOCIATES, INC.

PAINESVILLE, OHIO

NO.	DATE	BY
1		
2		
3		
4		
5		

"AS BUILT" CERTIFICATION

I, HEREBY CERTIFY THAT THE CIRCLED GRADES ARE EXISTING FINISH GRADES CHECKED IN THE FIELD ON 19 19 19 AND ARE CORRECT TO THE BEST OF MY KNOWLEDGE AND BELIEF.

REGISTERED SURVEYOR REG. NO.

ISSUED 9-23-88

SUBJECT TO APPLICABLE LAWS

Lake County Sanitary Eng. ☒

Lake County Planning Comm. ☐

Lake County Bldg. Dept. ☒

Teno J. Marano