

Concord Township Lake
COUNTY, OHIO

for: HHMK
CLIENT

CITY ZIP

SUBDIVISION 11-19 NAME BIG WHEEL SUB
40 VOL NO BIG WHEEL CT
 SUBLOT NO. _____ STREET _____

LOT	TRACT
VOLUME	PAGE
PERM. PARCEL NO.	STREET

20

- A. To be brought to finished grade
 1. Septic tank manhole covers
 2. Splitter box cover
 3. Distribution box cover
- B. No footer drains or downspouts to be discharged into septic tanks
- C. All waste water to be discharged into septic tanks

SANITARY	MANHOLE	WATER VALVE (GAS)	↑
STORM	MANHOLE	WATER METER (GAS)	---
INLET OR CATCH BASIN	HYDRANT	AS BUILT ELEVATION	---
EXISTING CONTOURS	PROPOSED CONTOURS	INDICATES DIRECTION OF SURFACE DRAINAGE	
EXIST. ELEV.	100.0	PROP. ELEV.	↑

REMARKS

ALL BOUNDARY DATA SHOWN WAS OBTAINED FROM (DEEDS, RECORDED
SUBDIVISION PLAT OR OTHER PUBLIC RECORDS)

LOCATIONS AS SHOWN OF ADJACENT WELLS AND SEPTIC TANKS OBTAINED FROM
LANE COUNTY HEALTH DEPARTMENT

DESIGN CERTIFICATION

THIS PLAT WAS PREPARED BY ME, AND IS CORRECT
TO THE BEST OF MY KNOWLEDGE AND BELIEF

CHECK LIST

NO. OF BEDROOMS
DIMENSIONS
BEATINGS
TIE TO NEAREST STREET
SUBLOT NO. PARCEL NO.
SURROUNDING OWNERS
BLDG. DIMENSIONS FIN. GR.
BLDG. TIERS FL'N. GRADES
FURNIT. TYPE WIDTH THICKNESS
SIDEWALK TYPE WIDTH THICKNESS
CULVERT TYPE DIA. LENGTH
ROCK OUTCROPPINGS

WATER MAIN SIZE, LOCATION
SAN. SEWER SIZE % GR. LOC.
SAN. MH. CAST. ELEV. INV. ELEV.
SAN. CONN. SIZE, LOC. DEPTH
STORM SEWER SIZE % GR. LOC.
STORM MH. CAST. ELEV. INV. ELEV.
PAV'T TYPE GRADE CURBS
BASE LIME LAY. SIZE THICKNESS
SEPTIC TANK LOCATION & DUPPLICATION AREAS
WELL LOCATION
ISOLATION RADIIUS FROM WELL

PLAN PREPARED BY:

BABCOCK • JONES & ASSOCIATES, INC.

PAINESVILLE, OHIO

DRAWN BY H7	SCALE 1" = 30'	PHONE NO. 357-1811
----------------	-------------------	-----------------------

DATE	10/7/88
OFFICER	OFF-171-4

CHIEF				
-------	--	--	--	--

"AS BUILT" CERTIFICATION

I, HEREBY CERTIFY THAT THE CIRCLED GRADES ARE EXISTING
FINISH GRADES CHECKED IN THE FIELD ON _____, 19____
AND ARE CORRECT TO THE BEST OF MY KNOWLEDGE AND BELIEF

REGISTERED SURVEYOR

REG. NO.

T609 - TS554 - 5/39

640.05

#5997

88-11-01


BY THE COURT:

[illegible]

500

100

Ten 8. Marand

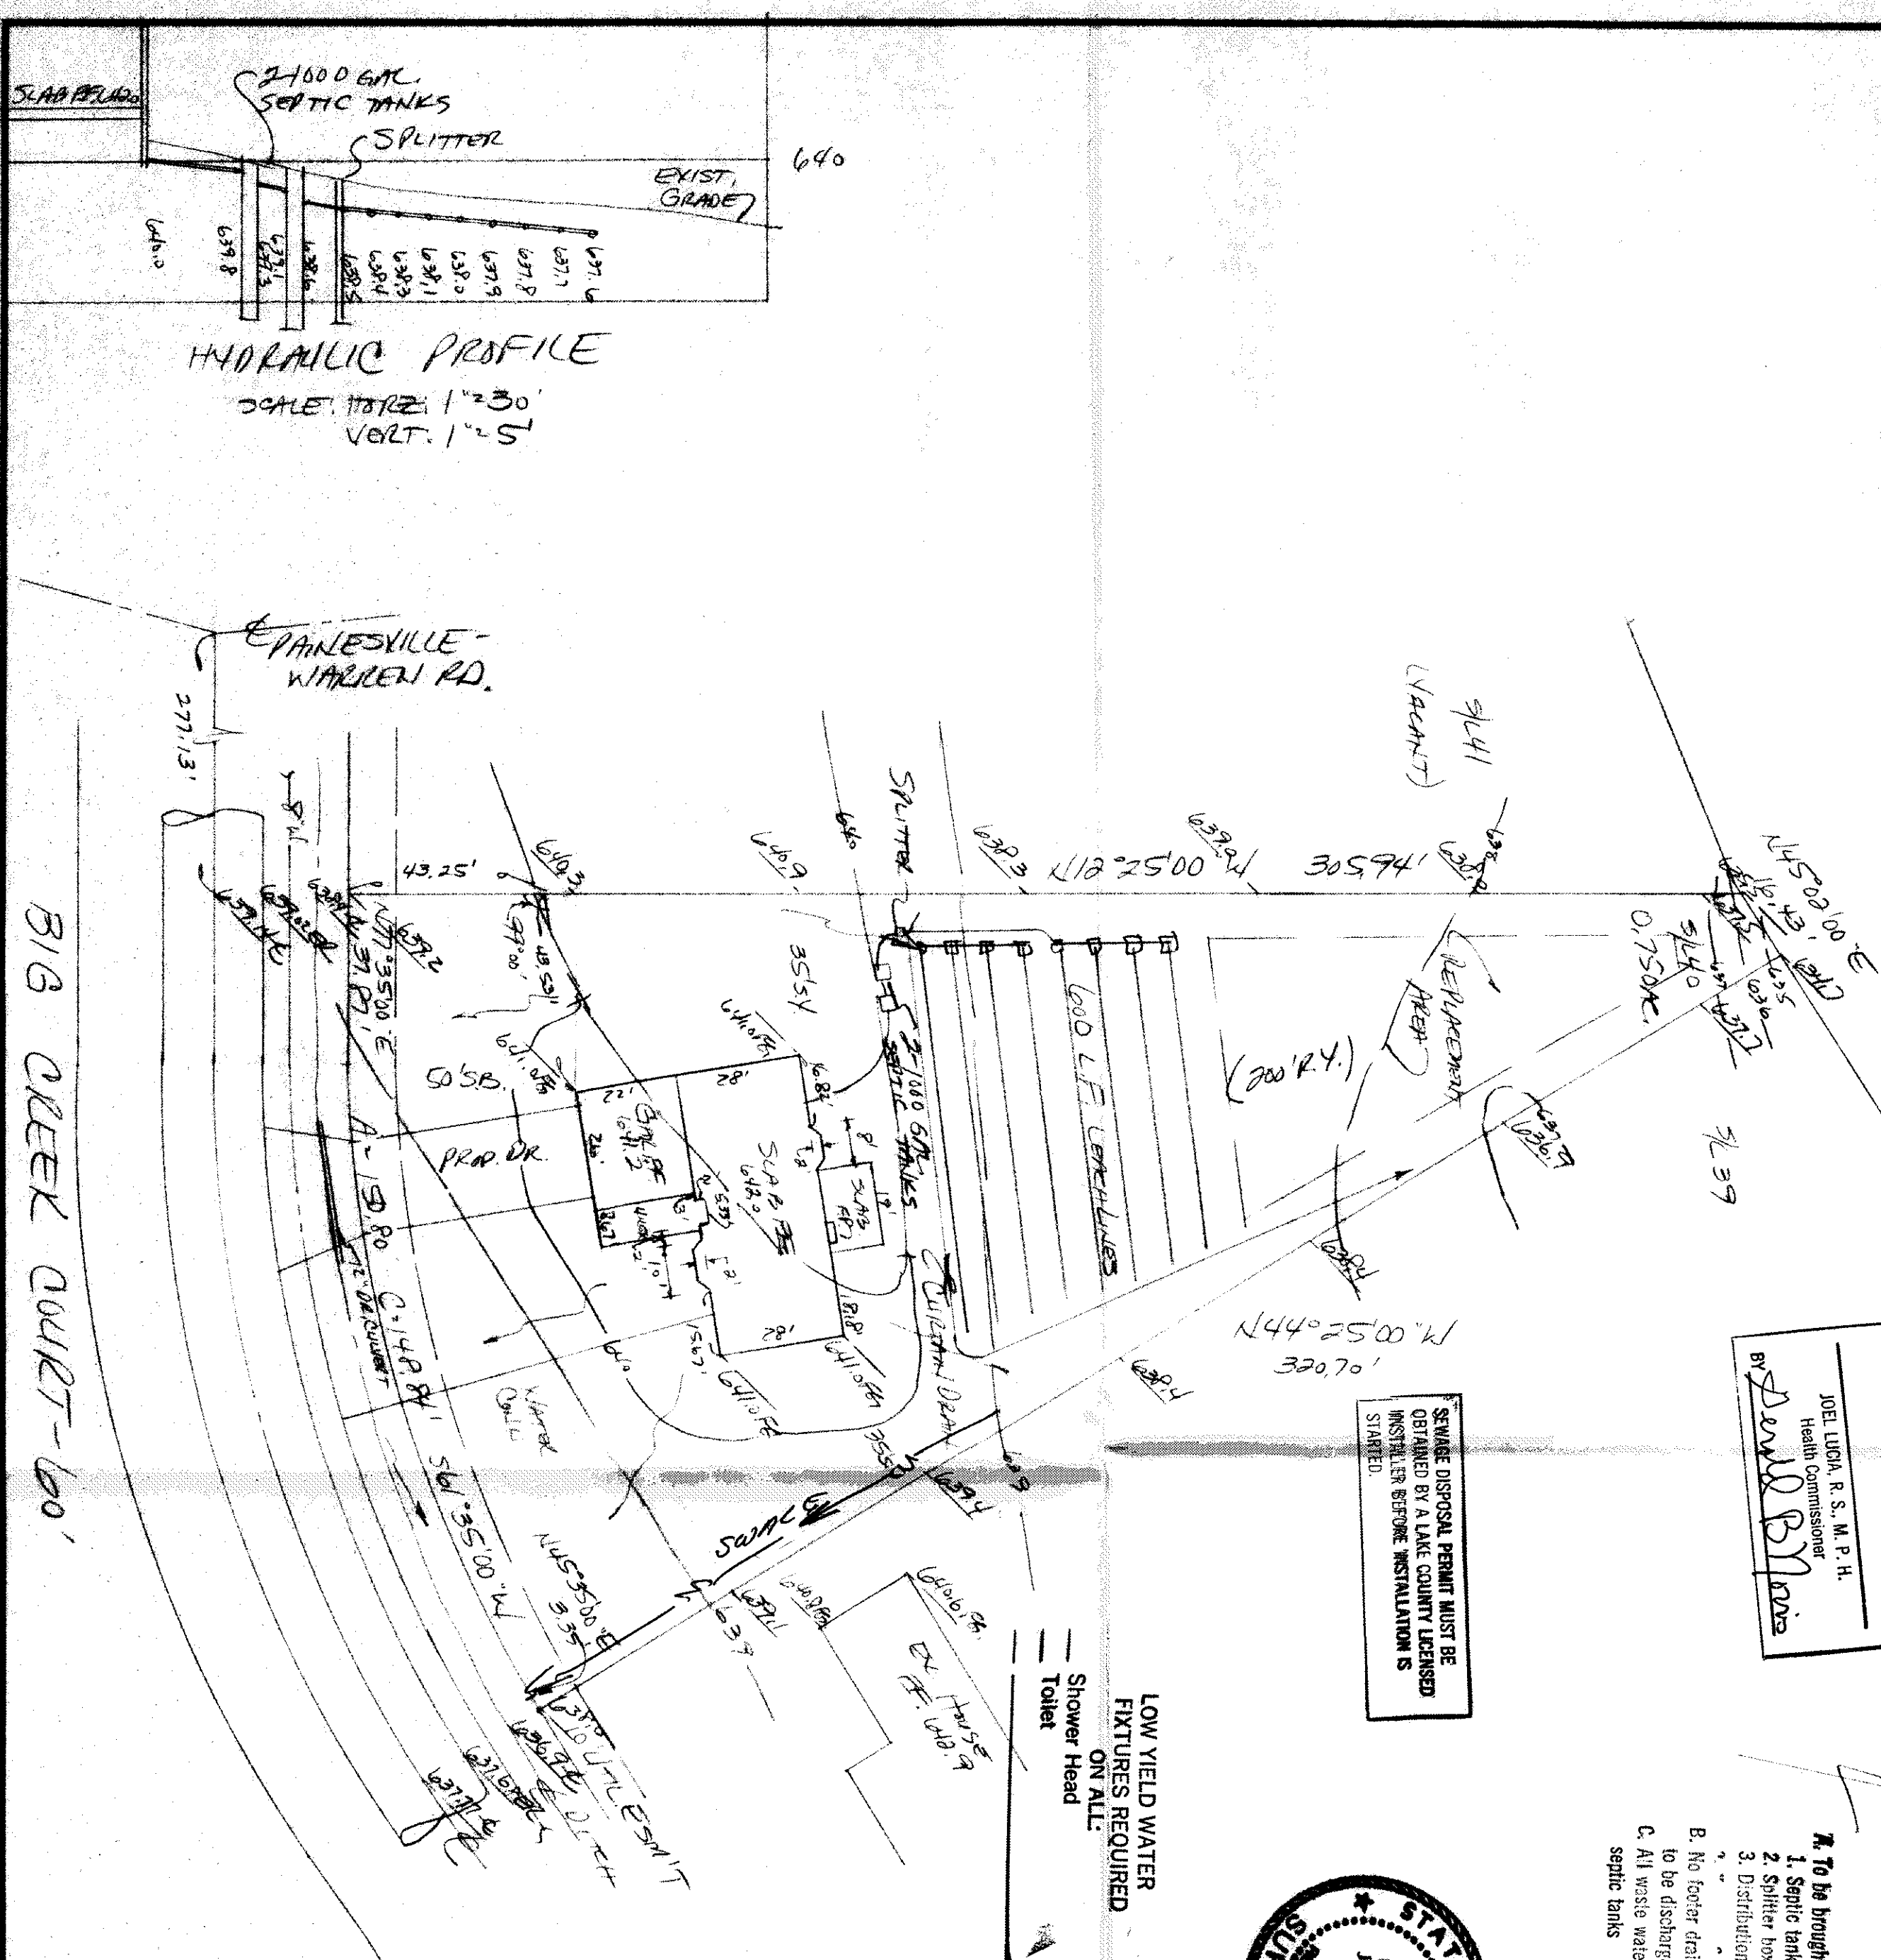

Reviewed and Accepted _____
 LAKE COUNTY GENERAL HEALTH DISTRICT
 Date 10-11-88

 JOEL LUCIA, R. S., M. P. H.
 Health Commissioner
 BY David B. Jones

SEWAGE DISPOSAL PERMIT MUST BE OBTAINED BY A LAKE COUNTY LICENSED INSTALLER BEFORE INSTALLATION IS STARTED.

