

SITE PLAN

Collected Township, Lake County, Ohio

for: Robert L. Dray

CLIENT OWNER

ADDRESS STREET CITY ZIP

LOT TRACT
SUBDIVISION NAME
VOLUME PAGE
SHEET NO. PERM. TANGENT NO. STREET

LEGEND

SANITARY MANHOLE
STORM MANHOLE
INLET OR CATCH BASIN
HYDRANT
EXISTING CONTOURS
PROPOSED CONTOURS
EXIST. ELEV. 100.0 PROP. ELEV. 100.0

WATER VALVE (GAS)
WATER METER (GAS)
AS BUILT ELEVATION
INDICATES DIRECTION OF SURFACE DRAINAGE

REMARKS

ALL BOUNDARY DATA SHOWN WAS OBTAINED FROM (DEEDS, RECORDED SUBDIVISION PLAT OR OTHER PUBLIC RECORDS)
LOCATIONS AS SHOWN OF ADJACENT WELLS AND SEPTIC TANKS OBTAINED FROM LAKE COUNTY HEALTH DEPARTMENT

DESIGN CERTIFICATION

THIS PLAT WAS PREPARED BY ME, AND IS CORRECT TO THE BEST OF MY KNOWLEDGE AND BELIEF.

NAME SURVEYOR REGISTRATION NO.

CHECK LIST

NO. OF BEDROOMS
SEWING
BATHING
TIE TO NEAREST STREET
SUBLOT NO. PARCEL NO.
SURROUNDING OWNERS
BLDG. DIMENSIONS FIN. GR.
BLDG. TYPE GRADE CURBS
PAV'T TYPE GRADE CURBS
SIDEWALK TYPE WIDTH THICKNESS
SEPTIC TANK LOCATION & DIMENSIONS
WELL LOCATION
ROCK OUTCROPPINGS
ISOLATION RADII FROM WELL

WATER MAIN SIZE, LOCATION
SAN. SEWER SIZE, GR. LOC.
SAN. MH. CAST ELEV. INV. ELEV.
SAN. CONN. SIZE, LOC. DEPTH
STORM SEWER SIZE, GR. LOC.
STORM MH. CAST ELEV. INV. ELEV.
PAV'T TYPE GRADE CURBS
SIDEWALK TYPE WIDTH THICKNESS
SEPTIC TANK LOCATION & DIMENSIONS
WELL LOCATION
ROCK OUTCROPPINGS
ISOLATION RADII FROM WELL

PLAN PREPARED BY: BABCOCK • JONES & ASSOCIATES, INC.

NO.	DATE	BY
1	11/17/90	BA
2	11/17/90	BA
3	11/17/90	BA
4	11/17/90	BA
5	11/17/90	BA

"AS BUILT" CERTIFICATION


I, HEREBY CERTIFY THAT THE CIRCLED GRADES ARE EXISTING FINISH GRADES CHECKED IN THE FIELD ON 19 19 AND ARE CORRECT TO THE BEST OF MY KNOWLEDGE AND BELIEF.

REGISTERED SURVEYOR REG. NO.

THM - 1441 IN TREE - 31 31 at R/W
ERED - 641.00

"I, the undersigned hereby certify that this topography indicated by 6", 1' or 2' contours, and elevations shown hereon, represent an actual field survey made by me on the 19th day of 1990 and that the elevations were taken at appropriate intervals and that as of that date they existed as indicated hereon."

Page No.

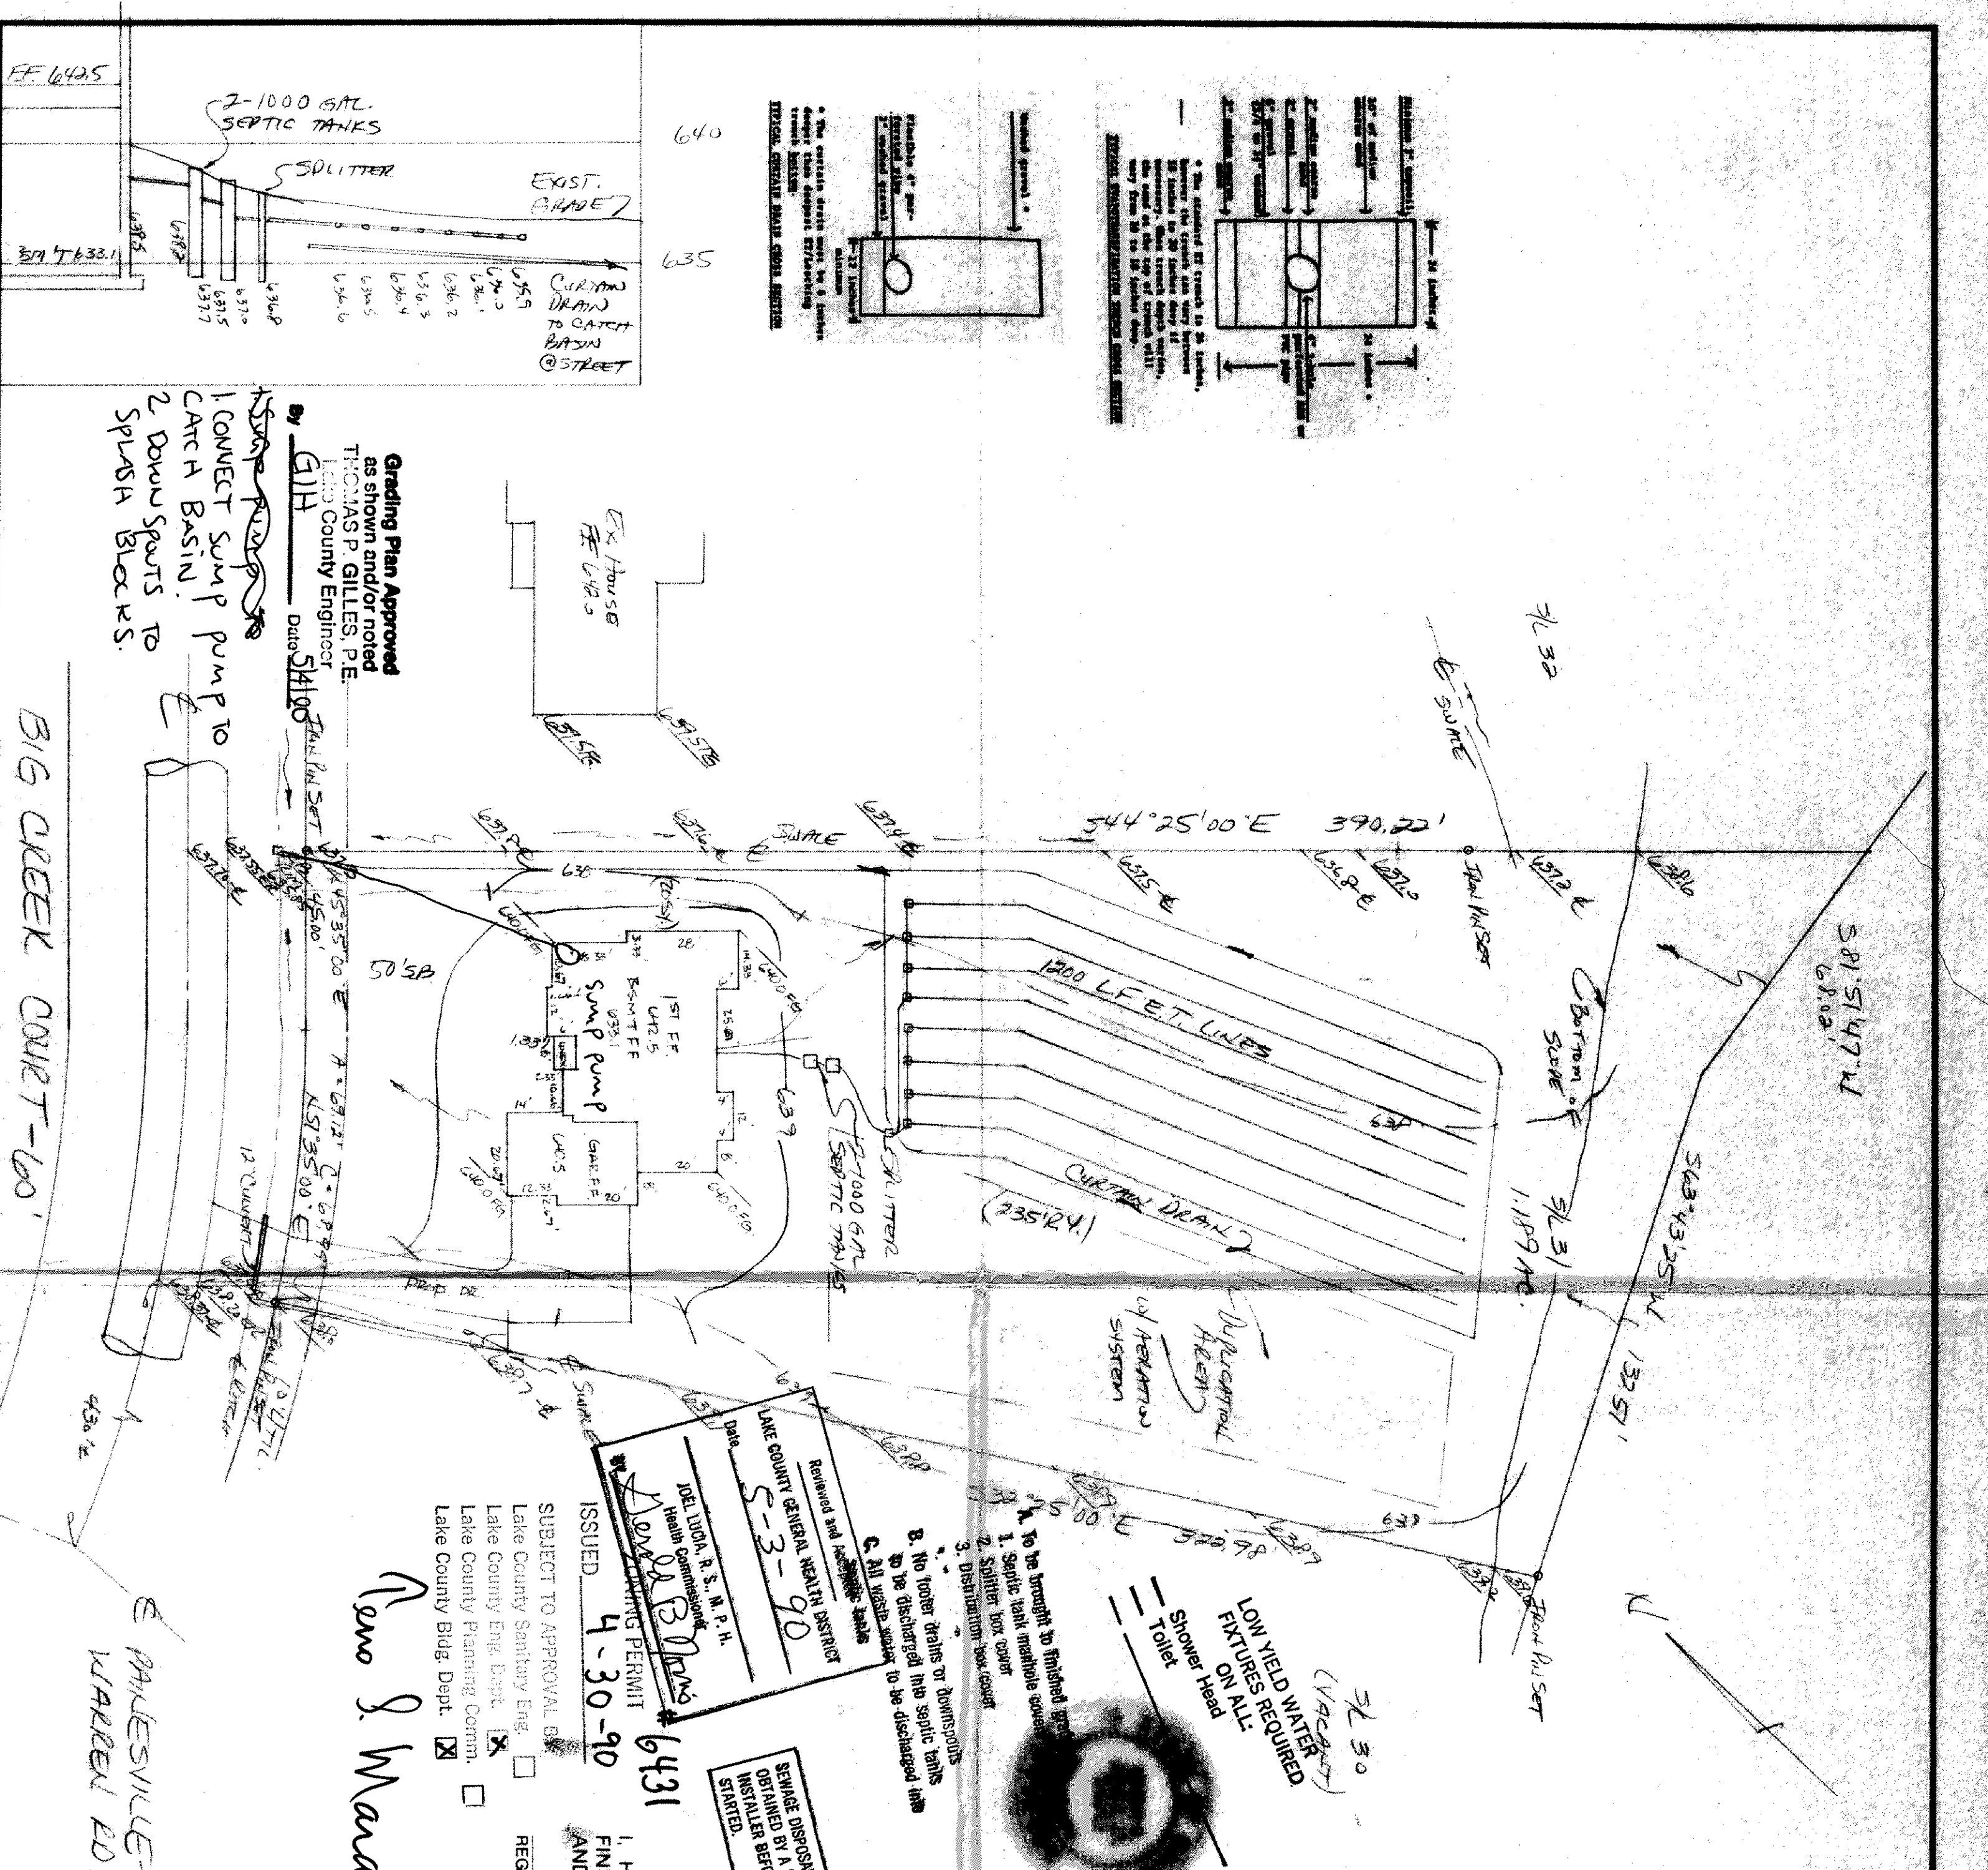

Grading Plan Approved as shown and/or noted THOMAS P. GILLES, P.E. Lake County Engineer Date 5/10/90

BIG CREEK COURT-60'

PAINESVILLE WARREN ED.

SITE PLAN

Coloan Township, Lake County, Ohio

for: SHIMPOCK CONSTRUCTION

ADDRESS STREET CITY ZIP

Big Creek Sub	LOT	TRACT
SUBDIVISION 1119	VOLUME	PAGE
31	1	1
SUBLOT NO. Big Creek Sub	PERM. PARCEL NO.	STREET

LEGEND

SANITARY MANHOLE	WATER VALVE (GAS)
STORM MANHOLE	WATER METER (GAS)
INLET OR CATCH BASIN	AS BUILT ELEVATION
HYDRANT	INDICATES DIRECTION OF SURFACE DRAINAGE
EXISTING CONTOURS	
PROPOSED CONTOURS	
EXIST. ELEV. 100.0	PROF. ELEV. 100.0

REMARKS

ALL BOUNDARY DATA SHOWN WAS OBTAINED FROM (DEEDS, RECORDED SUBDIVISION PLAT OR OTHER PUBLIC RECORDS)
LOCATIONS AS SHOWN OF ADJACENT WELLS AND SEPTIC TANKS OBTAINED FROM LAKE COUNTY HEALTH DEPARTMENT

DESIGN CERTIFICATION

THIS PLAT WAS PREPARED BY ME, AND IS CORRECT TO THE BEST OF MY KNOWLEDGE AND BELIEF.

NAME SURVEYOR REGISTRATION NO.

CHECK LIST

NO. OF BEDROOMS	WATER MAIN SIZE, LOCATION
DIMENSIONS	SAN. SEWER SIZE, % GR. LOC.
BEARINGS	SAN. IN. CAST ELEV. INV. ELEV.
TIE TO NEAREST STREET	SAN. CONN. SIZE, LOC. DEPTH
SUBLOT NO. PARCEL NO.	STORM SEWER SIZE, % GR. LOC.
SURROUNDING OWNERS	STORM SEWER CAST ELEV. INV. ELEV.
SEWER DIMENSIONS, FIN. GR.	SAFETY TYPE GRADE CURBS
ELEV. TIES P.T.N. GRADES	GAS LINE LOC. SIZE PRESSURE
ADJON TYPE WIDTH THICKNESS	SEPTIC TANK LOCATION & DUPPLICATION AREA
SIDEWALK TYPE DIA. LENGTH	WELL LOCATION
ROCK OUTCROPPINGS	ISOLATION RADIIUS FROM WELL

PLAN PREPARED BY:

BABCOCK • JONES & ASSOCIATES, INC.

PAINESVILLE, OHIO

NO.	DATE	BY	SCALE	PHONE NO.
1	9/14/88	117	1" = 30'	357-1811
2				
3				
4				
5				
6				

"AS BUILT" CERTIFICATION

I, HEREBY CERTIFY THAT THE CIRCLED GRADES ARE EXISTING FINISH GRADES CHECKED IN THE FIELD ON 19____ AND ARE CORRECT TO THE BEST OF MY KNOWLEDGE AND BELIEF.

REGISTERED SURVEYOR REG. NO.


76M - 1144 IN TREE - 31 31 DE R/W
ELEV. - 641.00

ZONING PERMIT #5973

ISSUED 9-19-88

SUBJECT TO: Lake County Health Dept. Lake County Public Works Comm. Lake County Planning Dept. Lake County Public Works Dept.

Tom F. Marano

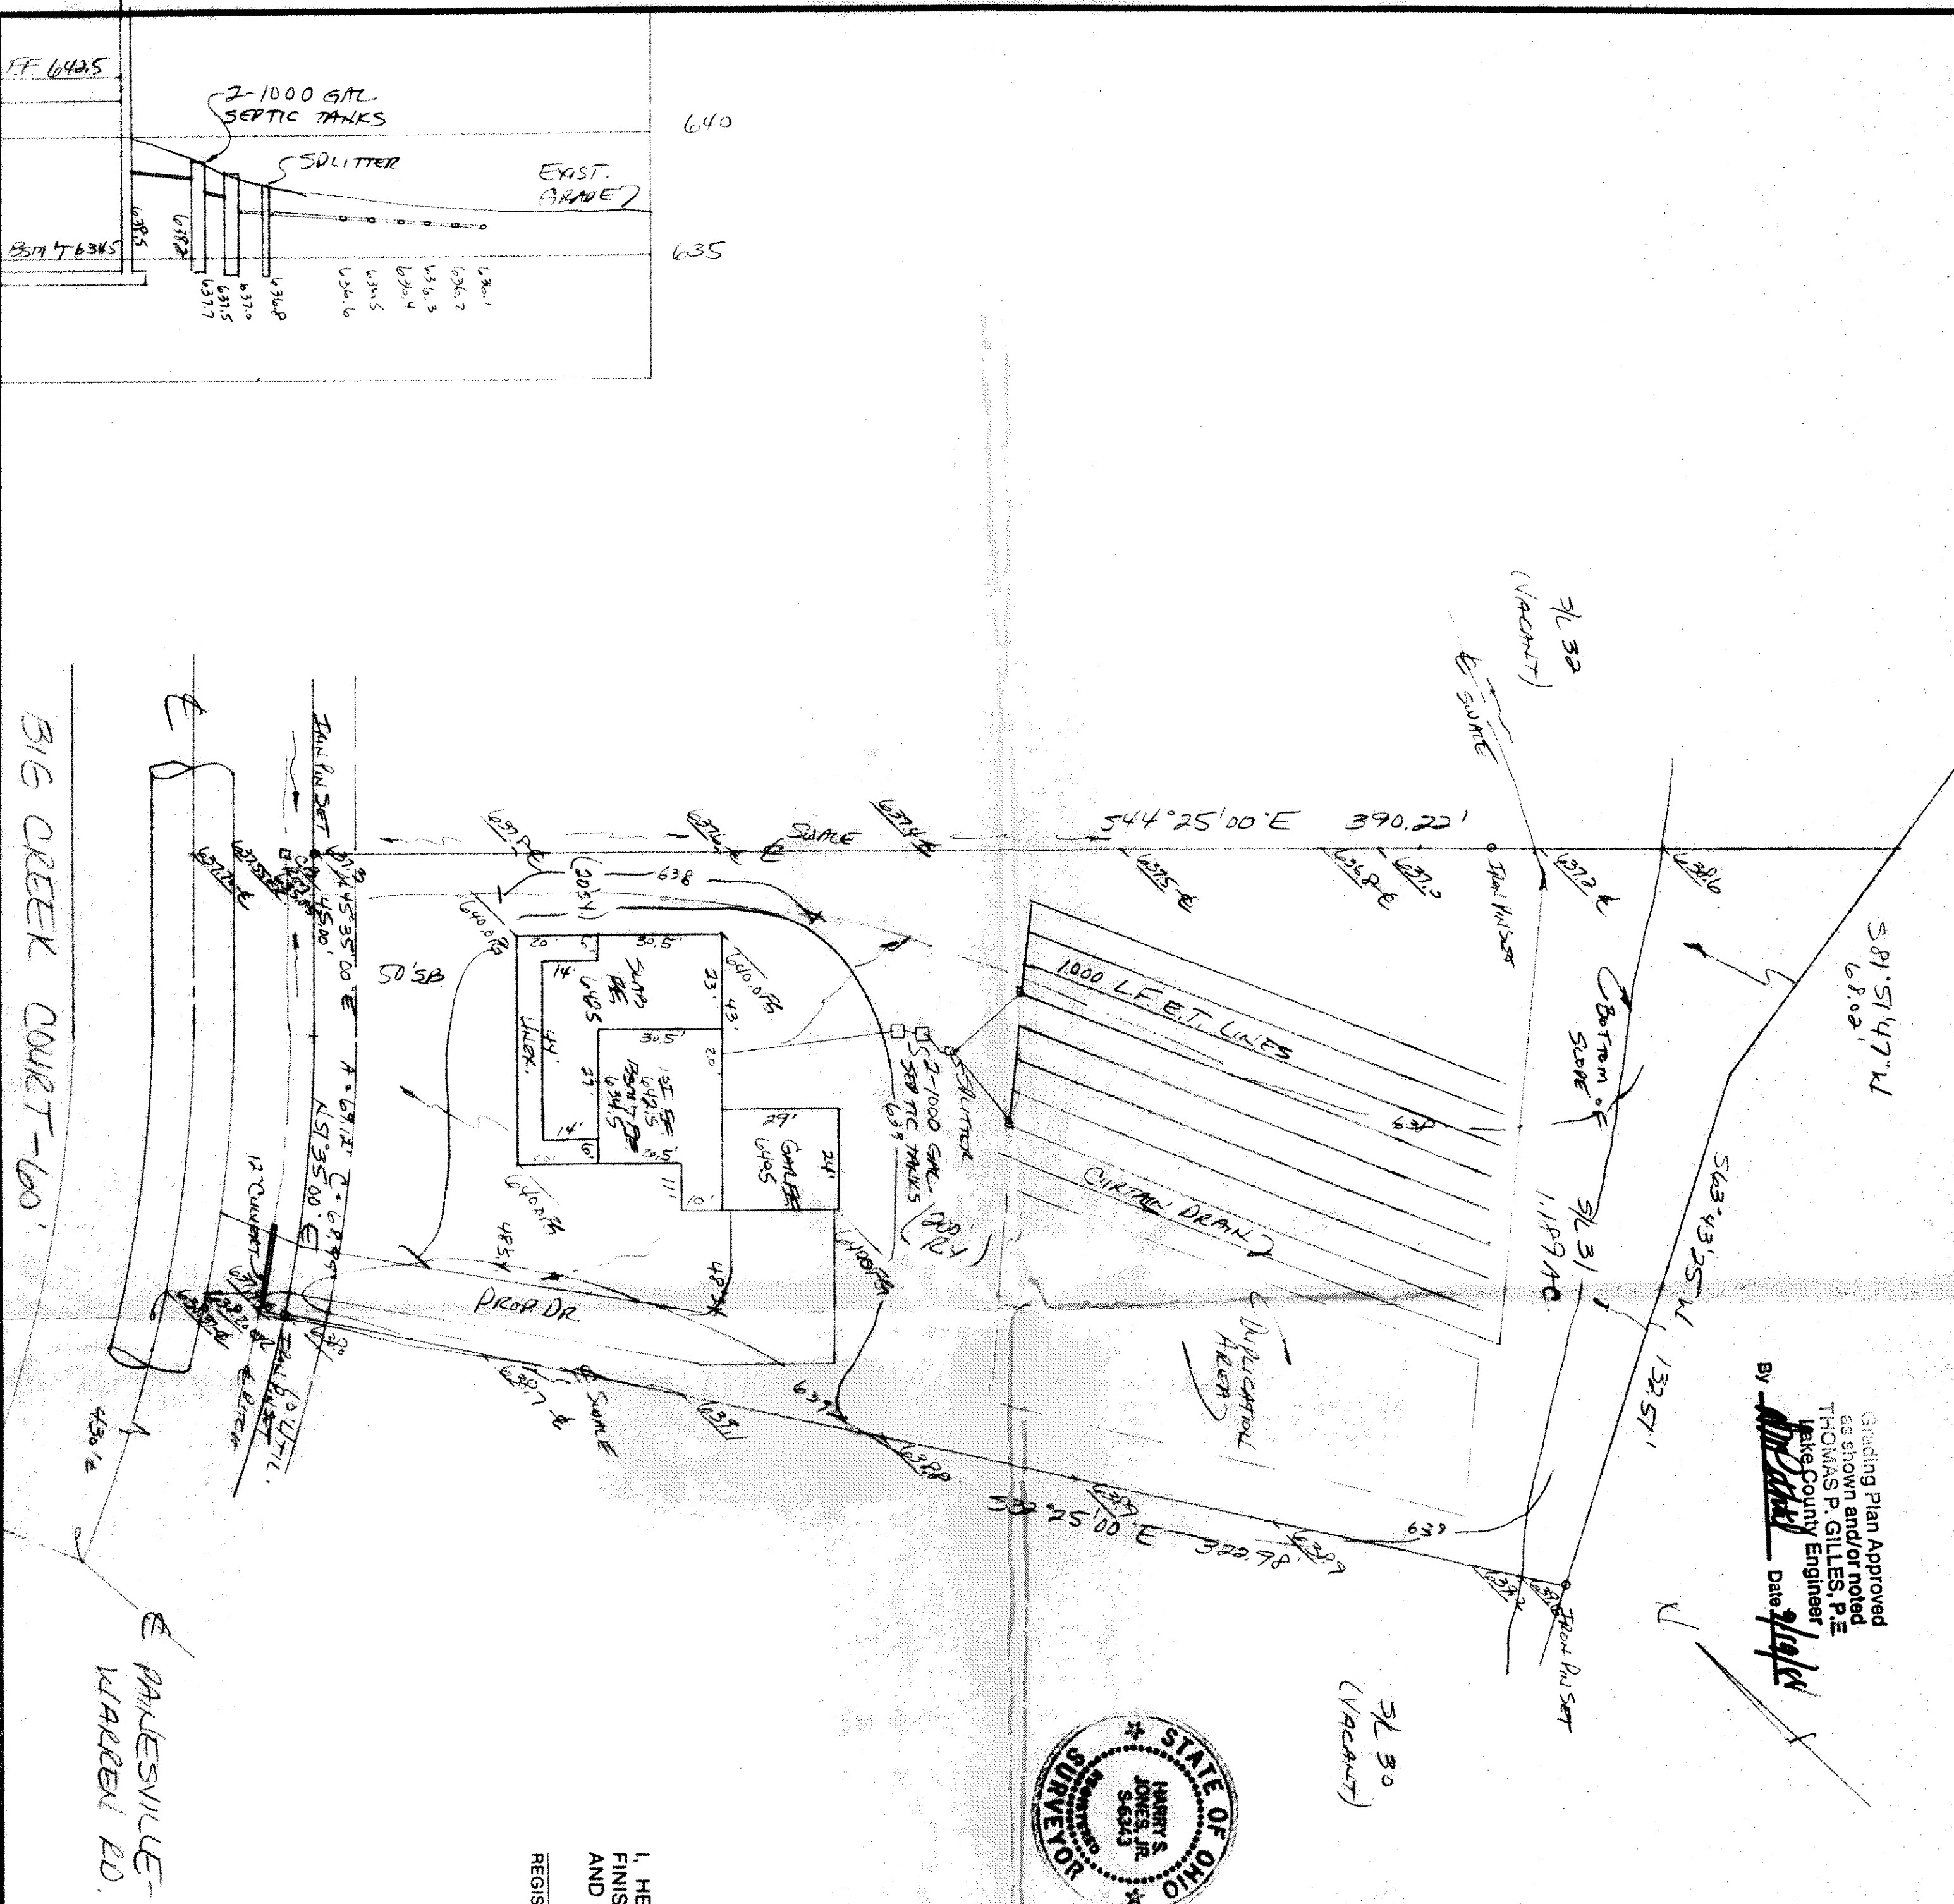

Grading Plan Approved as shown and/or noted THOMAS P. GILLES, P.E. Lake County Engineer Date 9/19/88

