

SCALE: 1"=30'

1/4" = 1' 0"

CURVE DATA

R = 65.00'
A = 53.32'
C = 51.84'
B = 71°55'00" W

GRANDE ROUE POINTE SUBD.

S 78°05'15"E 383.01'

S 25°59'11"E 438.85'

S 12°35'21"W 214.12'

S 12°31'

N 05°25'00"W 457.39'

APPROXIMATE BOTTOM OF BANK

SET 6100

DUPPLICATION AREA

SEWER LAYOUT, PRELIMINARY, BEING REVIEWED BY A LAKE COUNTY LICENSED ENGINEER BEFORE INSTALLATION IS

Reviewed and Accepted
LAKE COUNTY GENERAL HEALTH DISTRICT
4-13-94
JES. LIPKA, E.S., M.P.E.
Health Commissioner

LOW YIELD WATER
FIXTURES REQUIRED
ON ALL
Summer Head
Tank

- A. To be brought to finished grade
- 1. Septic tank manhole cover
- 2. Splitter box cover
- 3. Distribution box cover
- B. No foot or draft for downspouts to be discharged into septic tank
- C. All waste water to be discharged into septic tanks


SITE PLAN
FOR
VINCE TASSONE
BEING S/L 36 IN THE BIG CREEK SUBD. IN THE
TOWNSHIP OF CONCORD, LAKE COUNTY, OHIO

HYDRAULIC PROFILE
VERT. 1" = 3' HORIZ. 1" = 30'

1000 GPM Tank
1000 GPM Tank

FF-6410

* Grinder Pump
Rego in Pumping
in Basement

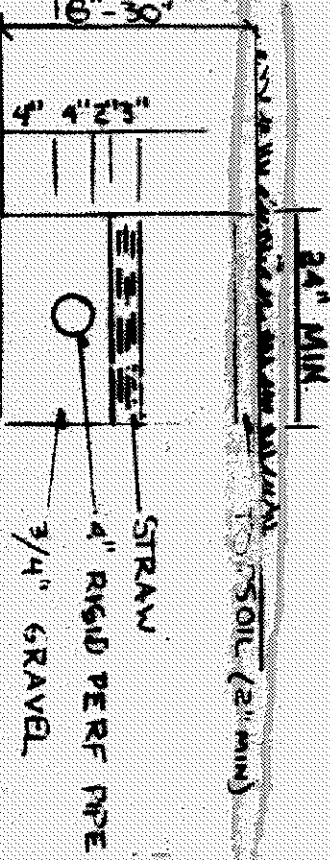

ZONING PERMIT

ISSUED 4-14-94

#0494-7753

SUBJECT TO APPROVAL BY:

- Lake County Sanitary Eng. ☐
- Lake County Eng. Dept. ☒
- Lake County Planning Comm. ☐
- Lake County Bldg. Dept. ☒

Grading Plan Approved
as shown and/or noted
THOMAS P. GILLES, P.E.
Lake County Engineer

By Date 4-15-94

BIG CREEK COURT 60'

VILLAGE SURVEYING CO.
FAIRPORT HARBOR, OHIO 44017
(216) 357-1359

I, the undersigned hereby certify that
this map, as indicated by 1' contours,
and elevations shown herein represent an
actual field survey made by me on
June 11, 1993
and that the elevations were taken at
appropriate intervals and that as of that

THOMAS P. GILLES

THOMAS P. GILLES

BENCHMARK - 633.44
RIM STM. M.H. INV. - 628.56