


N

N 89° 10' 15" E 118.62'

PUMP TO
1000+ LF
FOLLOWING
CONTOURS

BEING A PART OF ORIGINAL LOT NO 11,
TOWNSHIP OF CONCORD, COUNTY OF LAKE, CHRO

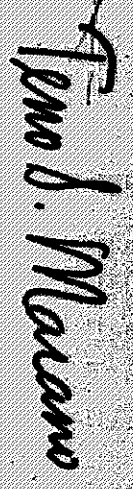

Date 6-1-15

