

SITE PLAN  
FOR  
TOM REED  
7220 PAINESVILLE, RAVENNA RD.  
CONCORD TWP.

SCALE: 1" = 40'


BENCHMARK-820.00(ASSUMED)  
IRISPIKE IN C&I POLE  
OPPOSITE SE CORNER

Grading Plan Approved  
as shown and/or noted  
THOMAS P. GILLES, P.E.  
Lake County Engineer

By THP Date 6-15-87

PARCEL B

PARCEL C

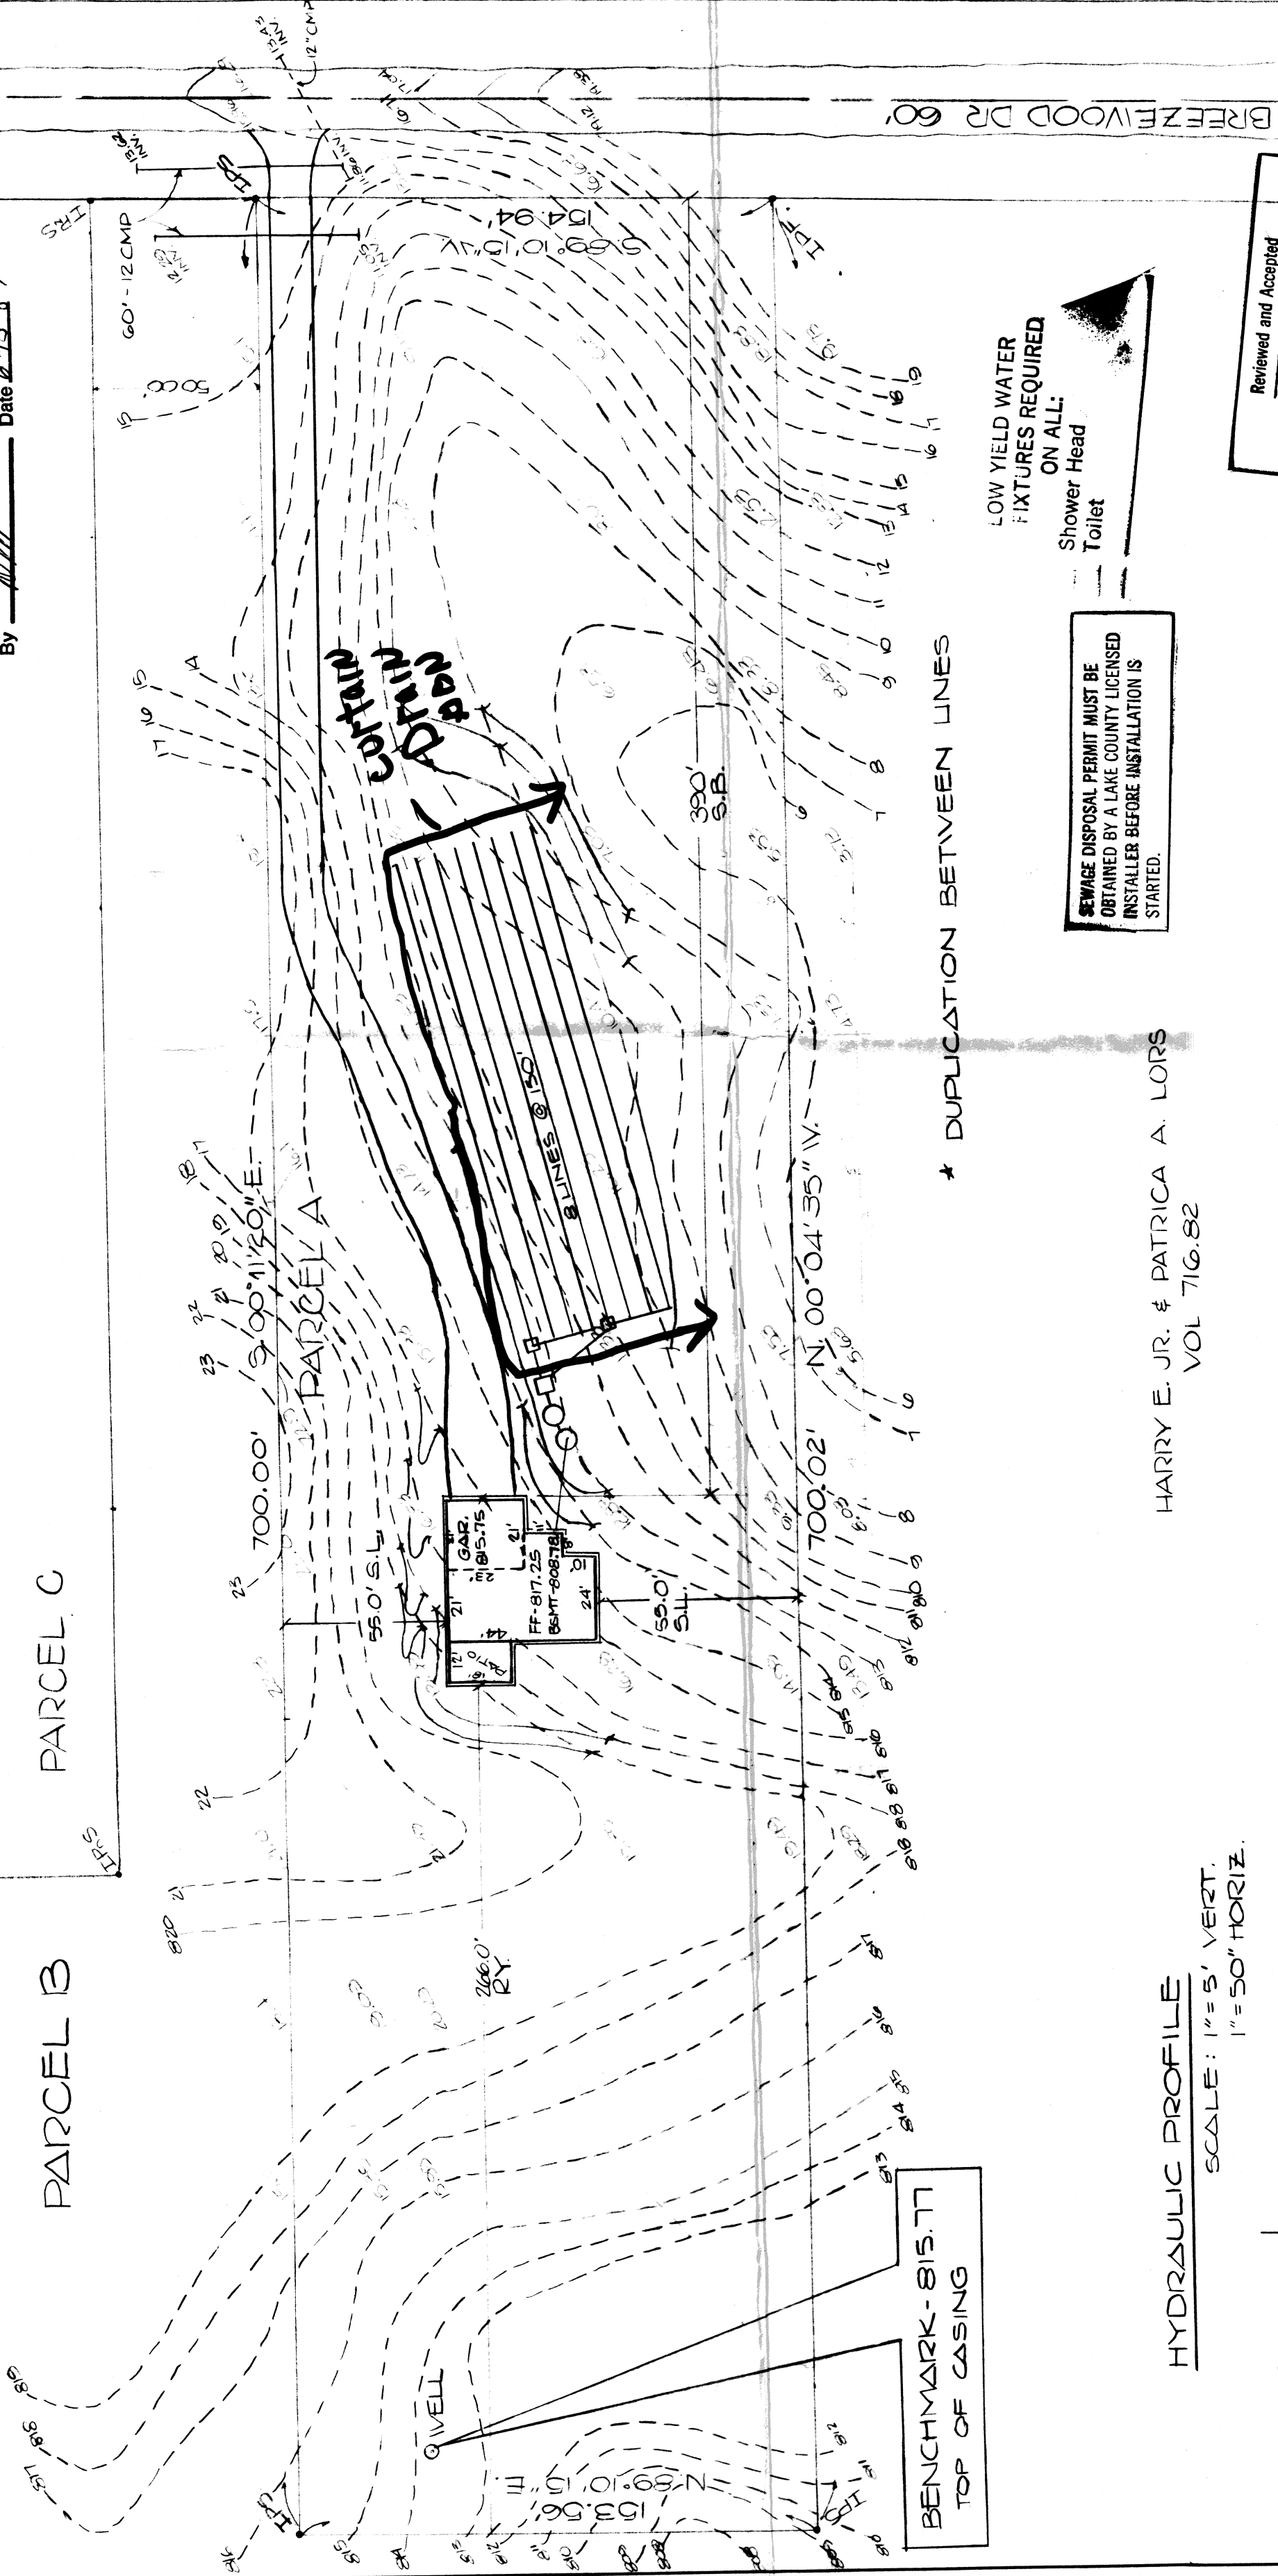

BENCHMARK-815.77  
TOP OF CASING


\* DUPLICATION BETWEEN LINES

LOW YIELD WATER  
FIXTURES REQUIRED  
ON ALL:  
Shower Head  
Toilet

SEWAGE DISPOSAL PERMIT MUST BE  
OBTAINED BY A LAKE COUNTY LICENSED  
INSTALLER BEFORE INSTALLATION IS  
STARTED.

HARRY E. JR. & PATRICA A. LORS  
VOL 716.82

HYDRAULIC PROFILE  
SCALE: 1" = 5' VERT.  
1" = 50' HORIZ.

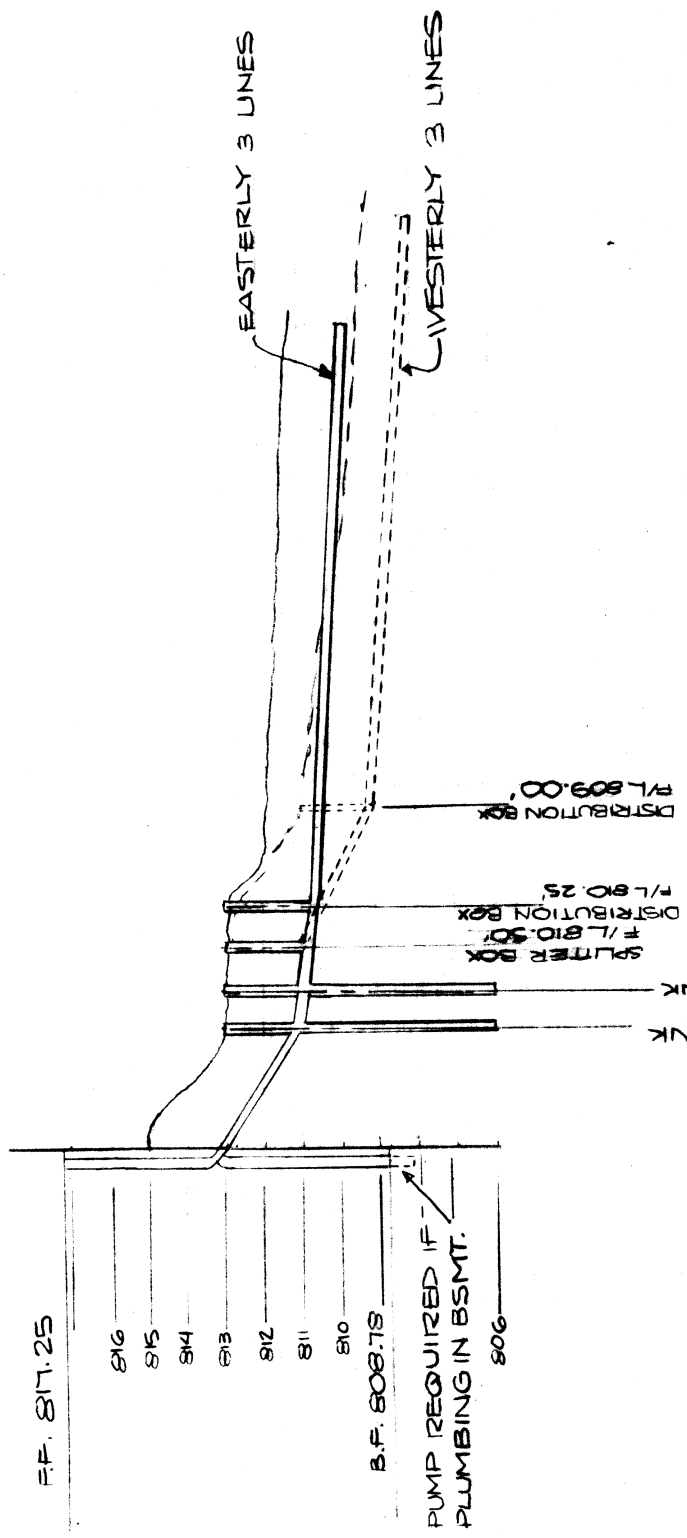

- A. To be brought to finished grade
1. Septic tank manhole covers
  2. Splitter box cover
  3. Distribution box cover
  4. Vent Pipes
- B. No footer drains or downspouts  
to be discharged into septic tanks  
All waste water to be discharged into  
septic tanks

Reviewed and Accepted  
LAKE COUNTY GENERAL HEALTH DISTRICT  
Date 6-12-87  
JOEL LUCIA, R. S. M. P. H.  
Health Commissioner  
JOEL LUCIA



THIS PLAT WAS PREPARED BY ME AND IS  
TRUE AND ACCURATE TO THE BEST OF MY  
KNOWLEDGE AND BELIEF.

VILLAGE SURVEYING CO.  
THOMAS M. COFFMAN, P.S.  
202 THIRD ST., FAIRPORT HARBOR, OHIO 44071 (216) 357-1359

Thomas M. Coffman  
THOMAS M. COFFMAN, P.S.  
NO. 6857

ZONING PERMIT #5545  
ISSUED 6-10-87

SUBJECT TO THE ZONING  
Lake County Health Dist. ☐  
Lake County Health Dist. ☒  
Lake County Health Dist. ☒  
Lake County Health Dist. ☒

Tono S. Marano