
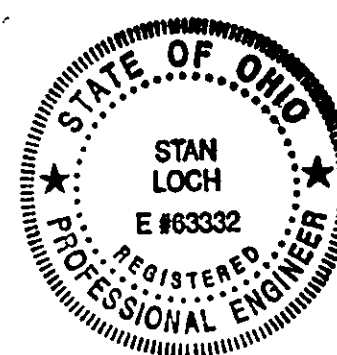


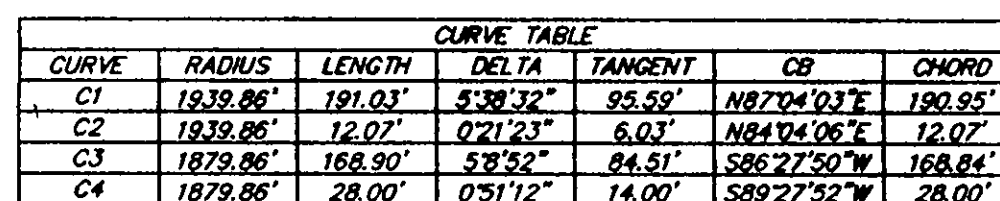


STARU 7-03-01
Name Reg.# P.E.#63322.

Grading Plan Approved
as shown and/or noted
JAMES R. GILLS, P.E.
Lake County Engineer



By JRM Date 7/26/09

**ROOF DRAINS
SHALL DISCHARGE
TO SPLASH BLOCKS.**

CONCORD TOWNSHIP ZONING OFFICE
ZONING PERMIT # 0701-10A53
10-4-01 ISSUED

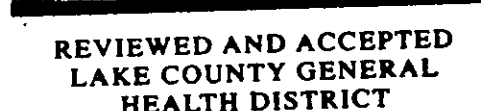

**SEWAGE DISPOSAL PERMIT MUST BE
OBTAINED BY A LAKE COUNTY LICENSED
INSTALLER BEFORE INSTALLATION IS
STARTED**

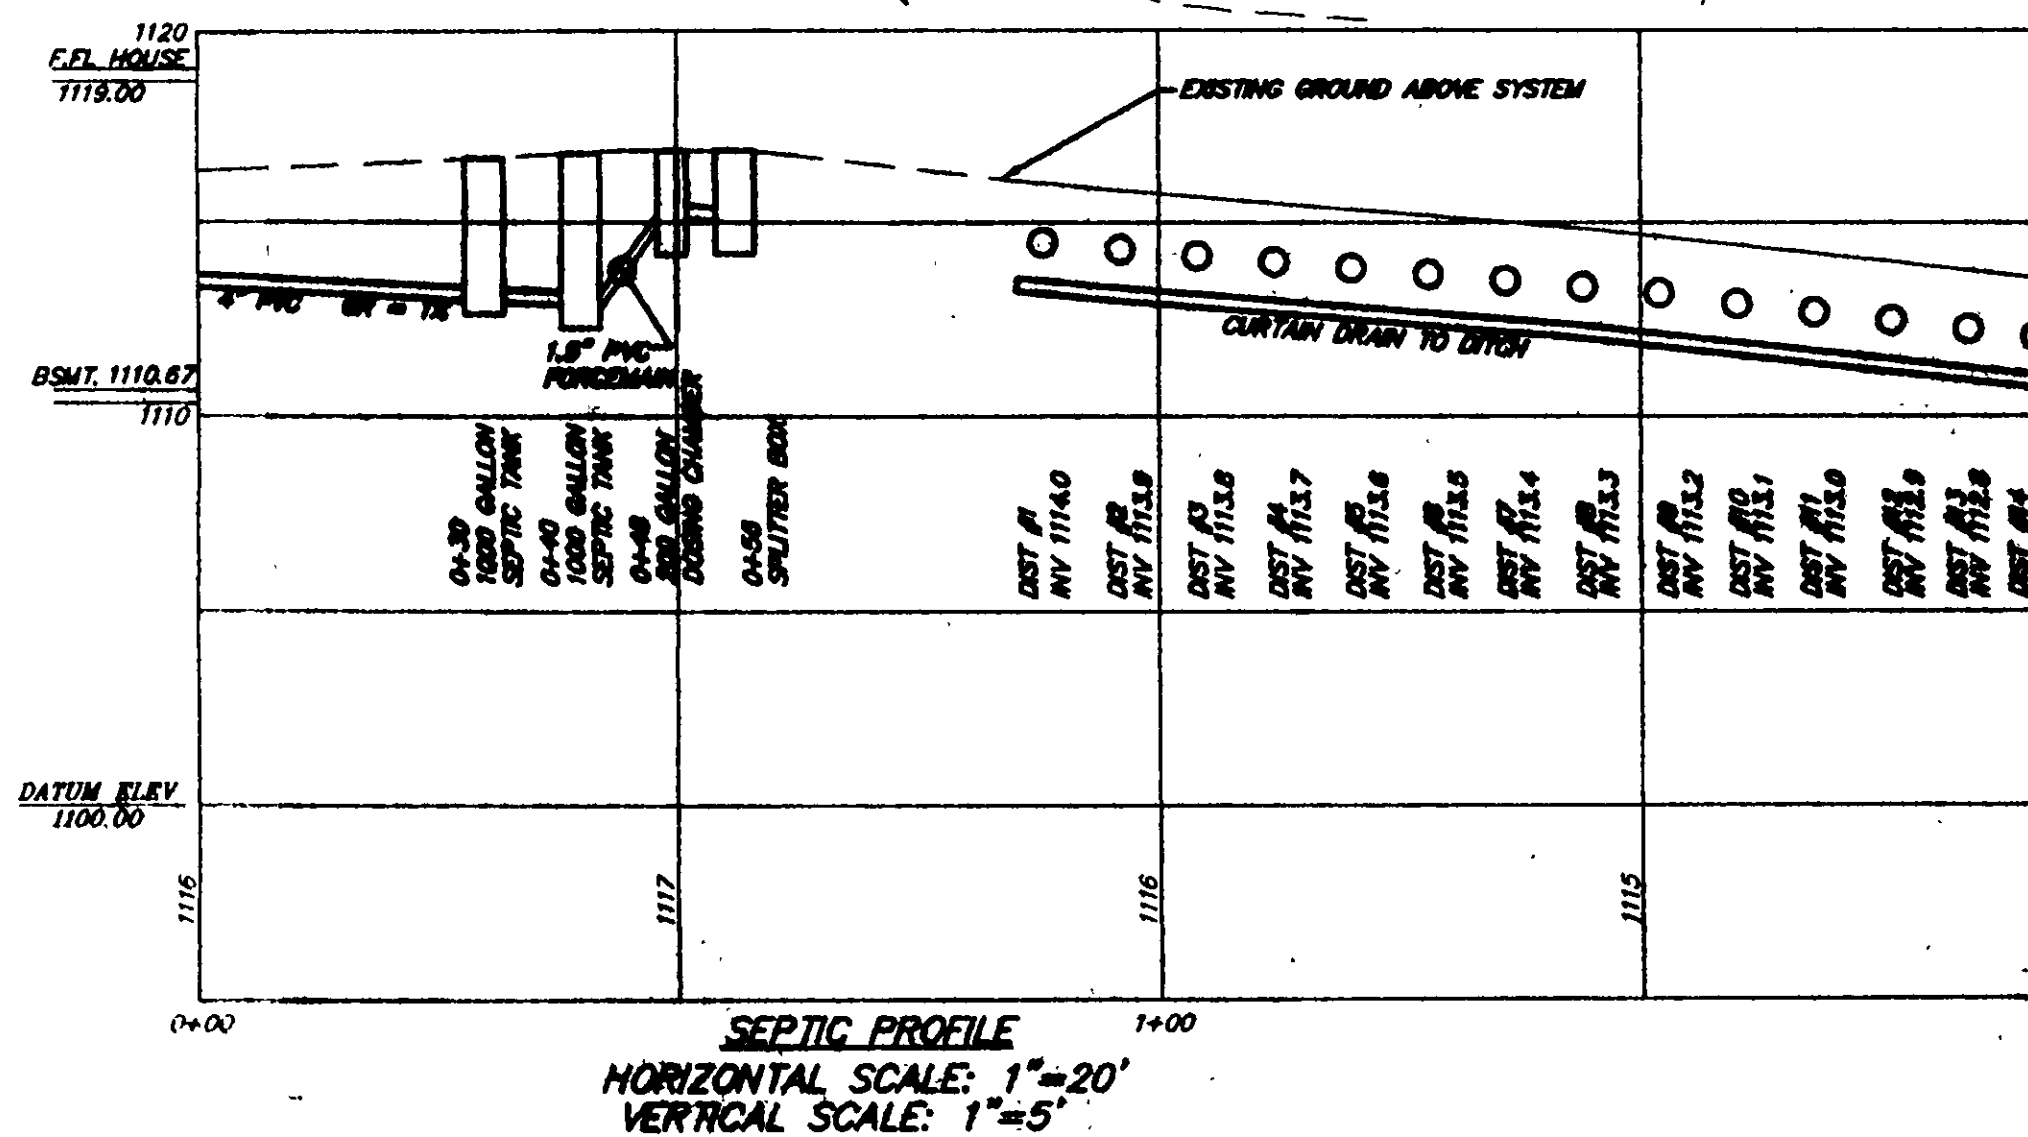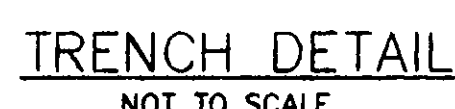

SEPTIC PROFILE
HORIZONTAL SCALE: 1"=20'
VERTICAL SCALE: 1"=5'

5784 HESLEY ROAD MENTOR OHIO 44060
440-639-9950 FAX 639-9790

AZTECH

ENGINEERING and SURVEYING
Civil Engineering · Land Surveying

**SITE PLAN FOR:
ALBERT & MARIA CHRISTOPHER
BEING S/L 47 IN THE
HAWTHORNE WOODS SUBDIVISION
TOWNSHIP OF CONCORD
COUNTY OF LAKE
STATE OF OHIO**

[illegible]