


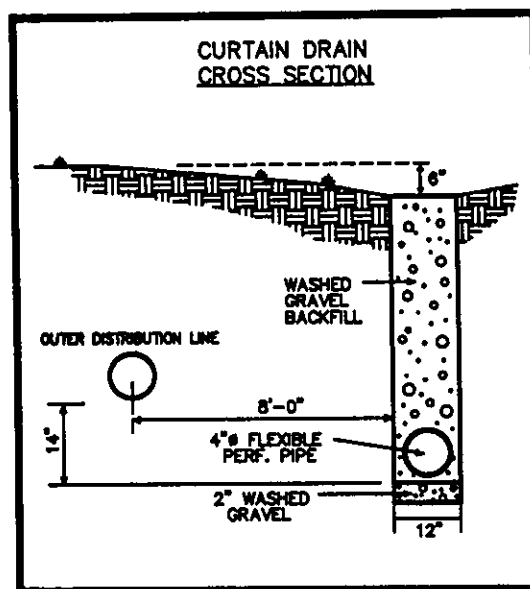

REVIEWED AND ACCEPTED
LAKE COUNTY GENERAL
HEALTH DISTRICT

Date 10-27-99 BY D.L.L.
curtain drain to ditch

SEWAGE DISPOSAL PERMIT MUST BE
OBTAINED BY A LAKE COUNTY LICENSED
INSTALLER BEFORE INSTALLATION IS
STARTED


ex. house
ft. 1113.11

Grading Plan Approved
as shown and/or noted
THOMAS P. GILLES, P.E.
Lake County Engineer

By JAM Date 11/5/99
12" culvert required
Swale as shown

ZONING PERMIT #1199+ 9614
ISSUED 11/2/99

SUBJECT TO APPROVAL BY:
Lake County Sanitary Eng. ☐
Lake County Eng. Dept. ☒
Lake County Planning Comm. ☐
Lake County Bldg. Dept. ☒

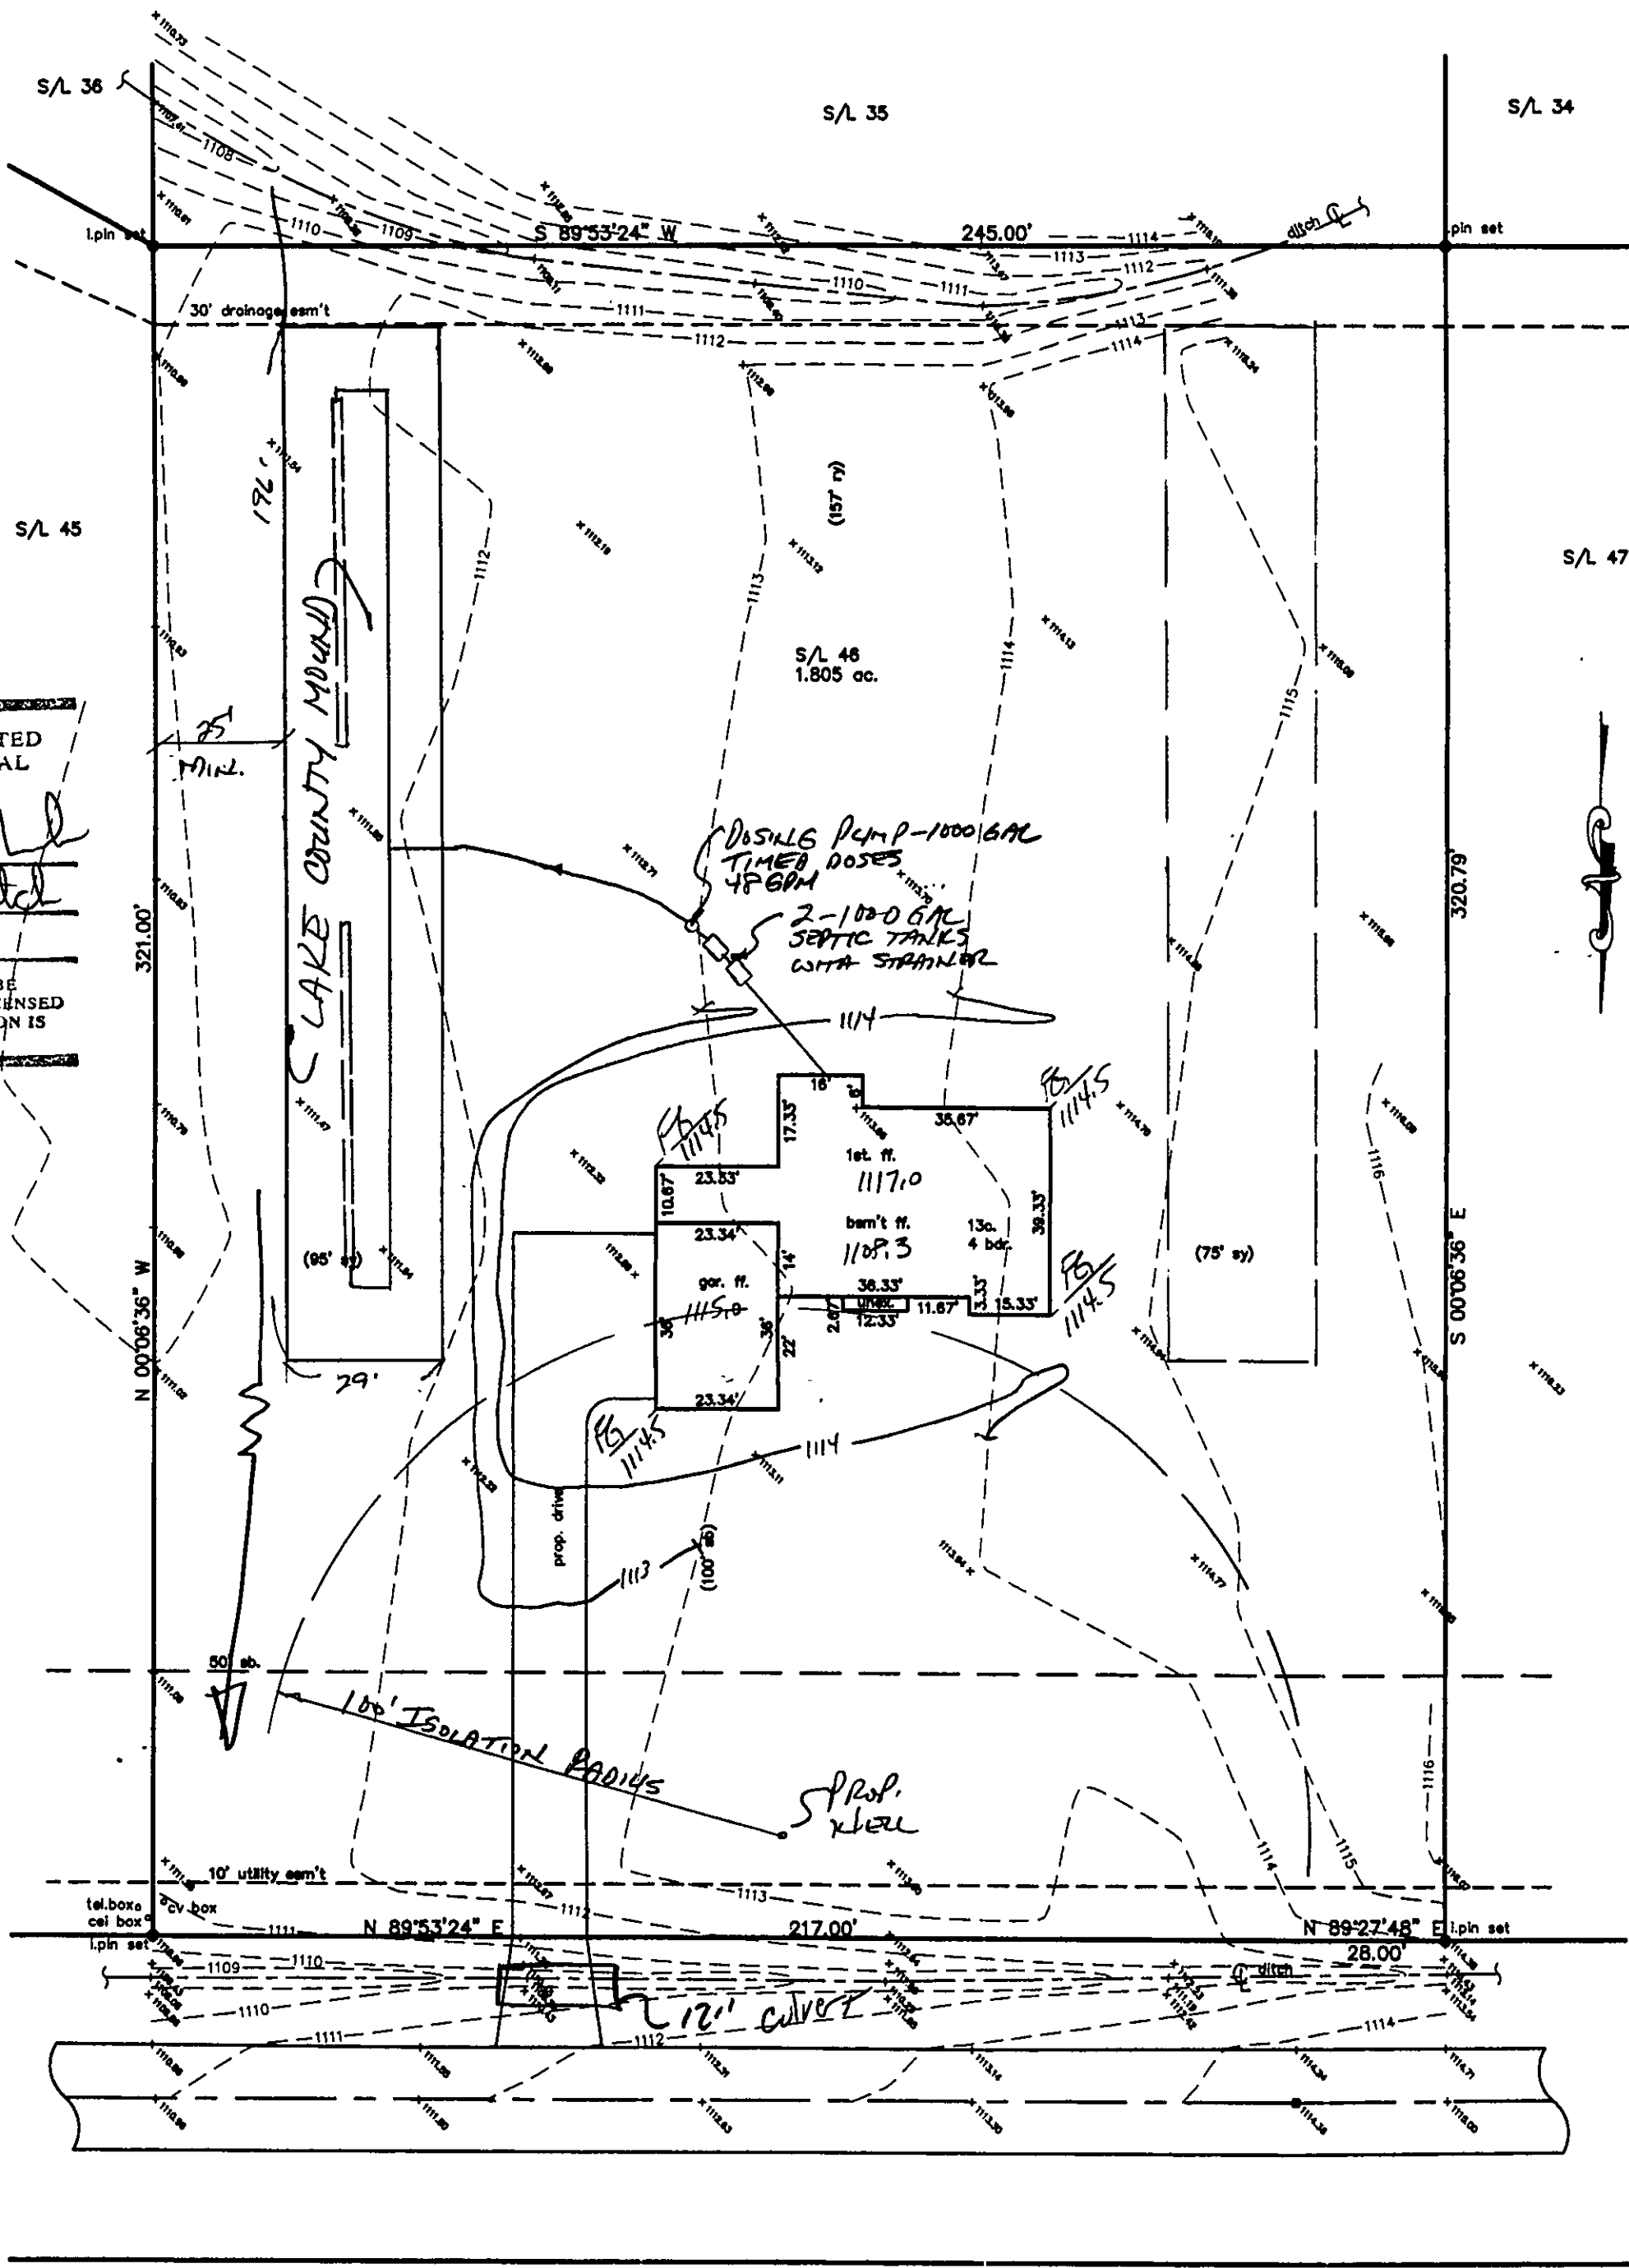

SITE PLAN

CONCORD TWP. LAKE COUNTY, OHIO

for: **LORENZO**

CLIENT _____ OWNER _____

ADDRESS _____ STREET _____ CITY _____ ZIP _____

HAWTHORNE WOODS

SUBDIVISION 15-46 NAME _____ TRACT _____ STREET _____

46 VOL-PG. BRIARWYCK WOODS AVE LOT _____

SUBLOT NO. _____ STREET _____ VOL-PG. _____ PERM. PARCEL NO. _____

LEGEND

SANITARY MANHOLE --- (S) --- DIST. ELEV. --- 100.0 --- PROP. ELEV. --- 100.0

STORM MANHOLE --- (S) --- AS BUILT ELEVATION

INLET OR CATCH BASIN --- (S) --- INDICATES DIRECTION OF SURFACE DRAINAGE

HYDRANT --- (H) ---

EXISTING CONTOURS --- (dashed line) ---

PROPOSED CONTOURS --- (solid line) ---

REMARKS

ALL BOUNDARY DATA SHOWN WAS OBTAINED FROM (DEEDS, RECORDED SUBDIVISION PLAT OR OTHER PUBLIC RECORDS)

LOCATIONS AS SHOWN OF ADJACENT WELLS AND SEPTIC TANKS OBTAINED FROM LAKE COUNTY HEALTH DEPARTMENT

DESIGN CERTIFICATION

THIS PLAT WAS PREPARED BY ME, AND IS CORRECT TO THE BEST OF MY KNOWLEDGE AND BELIEF.

NAME Harry Jones, Jr. SURVEYOR REGISTRATION NO. 6343

CHECK LIST

NO. OF BEDROOMS _____

DIMENSIONS _____

BEARINGS _____

TIE TO NEAREST STREET _____

SUBLOT NO. PARCEL NO. _____

SURROUNDING OWNERS _____

BLDG. DIMENSIONS FIN GR. _____

BLDG. TIES FL'R. GRADES _____

APRON TYPE WIDTH THICKNESS _____

SEWALK TYPE WIDTH THICKNESS _____

CULVERT TYPE DIA. LENGTH _____

ROCK OUTCROPPINGS _____

WATER MAIN SIZE, LOCATION _____

SAN. SEWER SIZE & GR. LOC. _____

SAN. MH. CAST. ELEV. INV. ELEV. _____

SAN. CONN. SIZE, LOC. DEPTH _____

STORM SEWER SIZE & GR. LOC. _____

STORM MH. CAST. ELEV. INV. ELEV. _____

PAVT TYPE GRADE CURBS _____

GAS LINE LOC. SIZE PRESSURE _____

SEPTIC TANK LOCATION & DUPLICATION AREA _____

WELL LOCATION _____

ISOLATION RADIUS FROM WELL _____

REVISIONS			PLAN PREPARED BY:	
NO.	DATE	BY	Bj BABCOCK JONES & ASSOCIATES, INC.	
1	8/9/99	H.J.	PAINESVILLE, OHIO	
2	10/18/99	H.J.	DRAWN BY A.H.	SCALE 1"=30'
3	10/20/99	H.J.	CHECKED H.J.	DATE 7/30/99
4			CREW W.B.	APP'D H.J.
5				

"AS BUILT" CERTIFICATION

I, HEREBY CERTIFY THAT THE CIRCLED GRADES ARE EXISTING FINISH GRADES CHECKED IN THE FIELD ON _____, 19____ AND ARE CORRECT TO THE BEST OF MY KNOWLEDGE AND BELIEF.

REGISTERED SURVEYOR _____ REG. NO. _____

PG 1/2

TBM - mon. box
elev 1114.375

"I, the undersigned hereby certify that this topography indicated by 6", 1", or 2" contours, and elevations shown hereon represent an actual field survey made by me on the 29th day of July, 1999 and that the elevations were taken at appropriate intervals and that as of that date they existed as indicated hereon."

Harry Jones, Jr. #6343
Name _____ Reg. No. _____

