

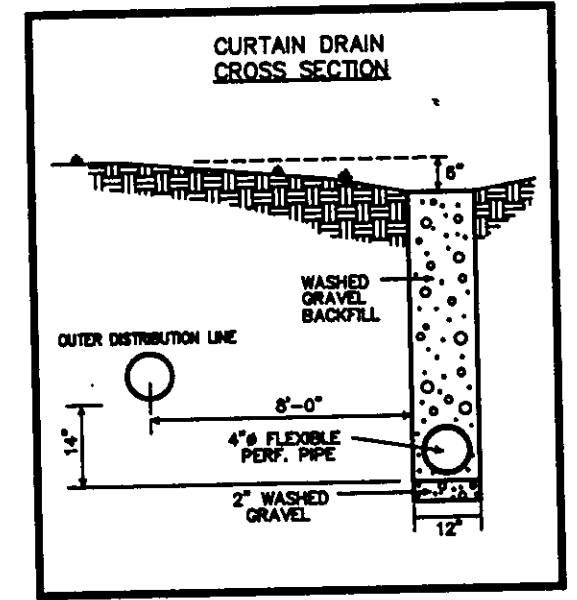
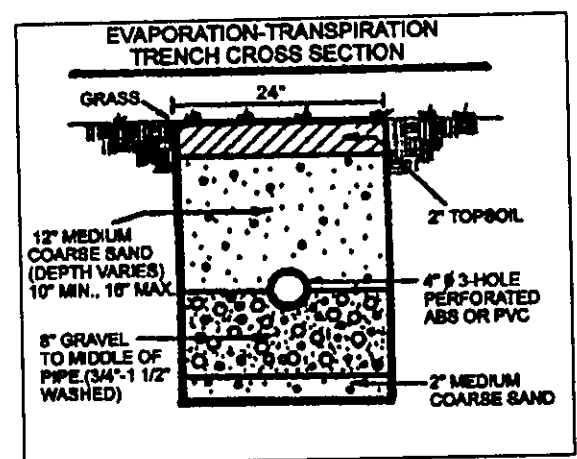


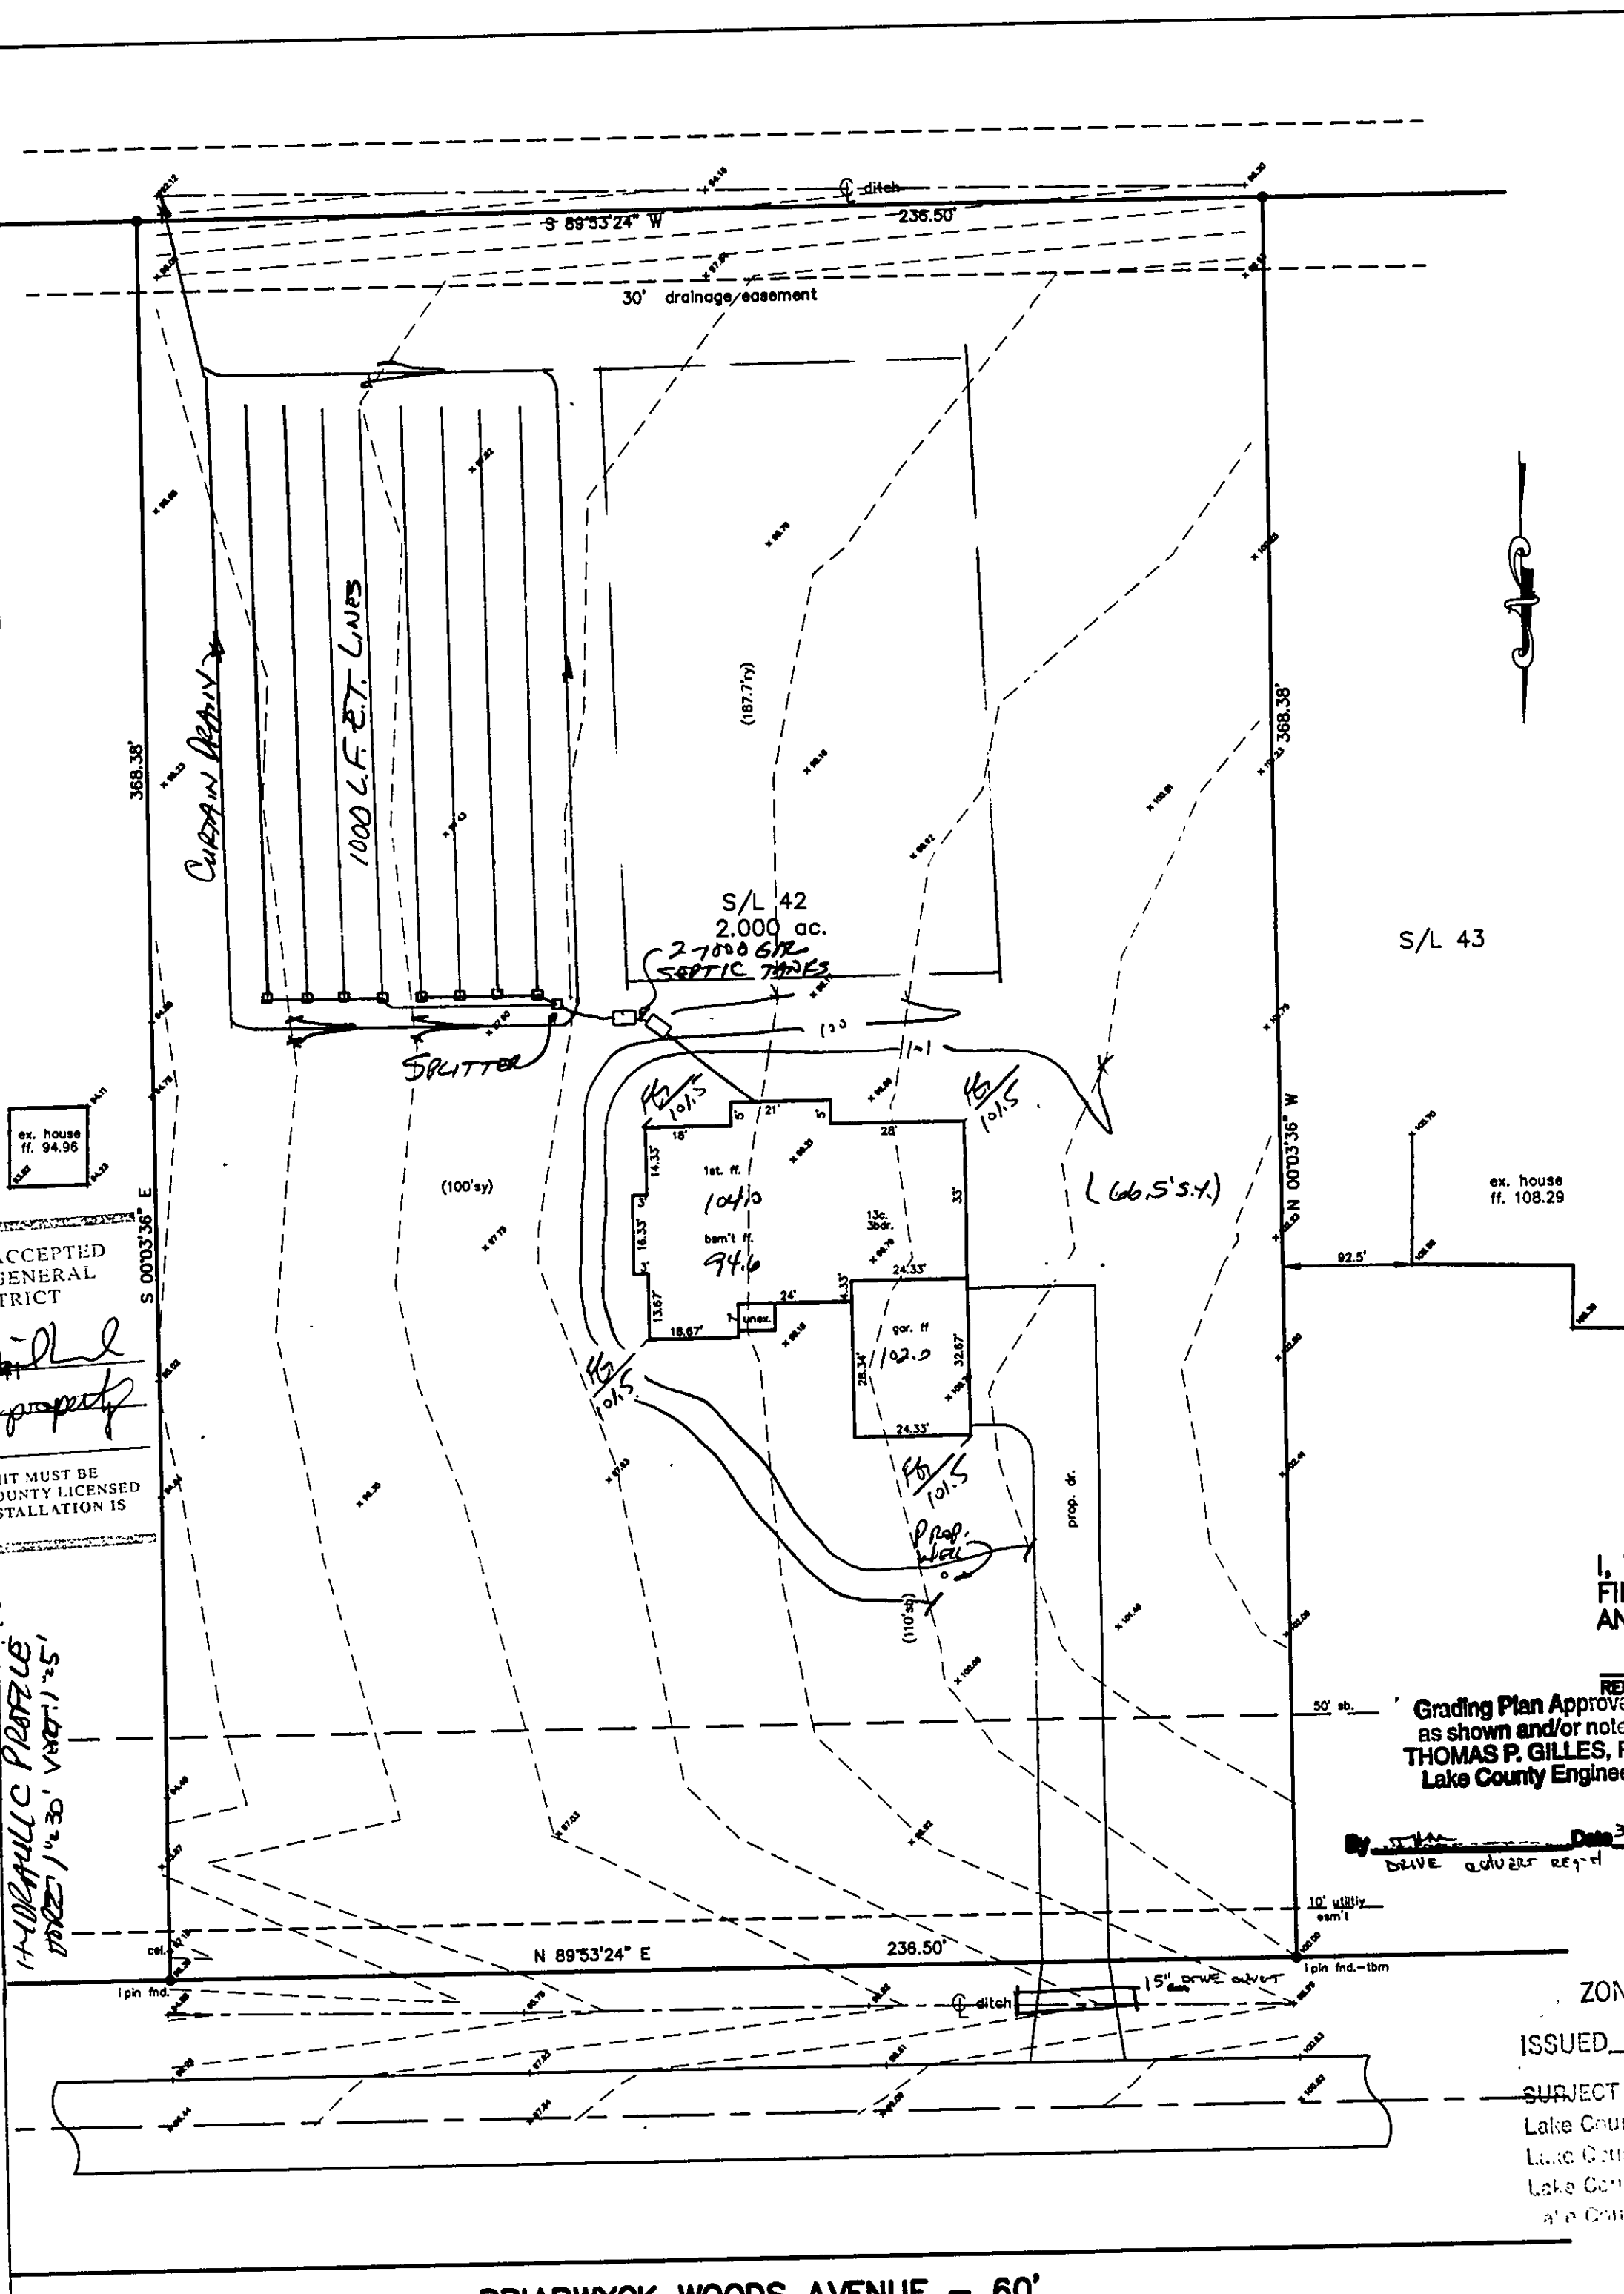

REVIEWED AND ACCEPTED
LAKE COUNTY GENERAL
HEALTH DISTRICT

Date: 3-3-99
35 Sept Fr property

SEWAGE DISPOSAL PERMIT MUST BE
OBTAINED BY A LAKE COUNTY LICENSED
INSTALLER BEFORE INSTALLATION IS
STARTED

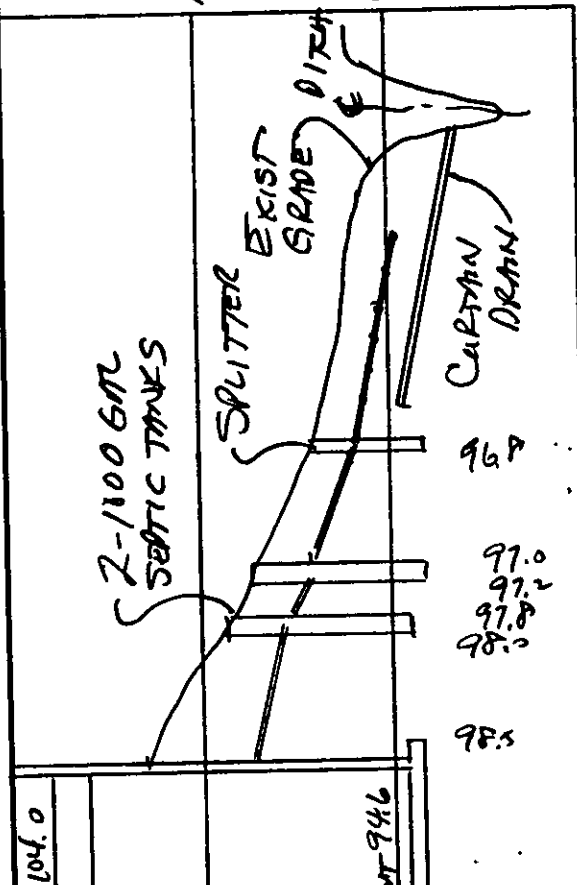

SITE PLAN

CONCORD TOWNSHIP, LAKE COUNTY, OHIO

for: WILSHIRE HOMES

CLIENT	OWNER
ADDRESS	STREET CITY ZIP

SUBDIVISION	NAME	TRACT	STREET
42	15-46		
SUBLOT NO.	STREET	LOT	PERM. PARCEL NO.
	BRIARWYCK WOODS AVE.		

LEGEND

SANITARY MANHOLE	AS BUILT ELEVATION
STORM MANHOLE	INDICATES DIRECTION OF SURFACE DRAINAGE
INLET OR CATCH BASIN	
HYDRANT	
EXISTING CONTOURS	
PROPOSED CONTOURS	

REMARKS

ALL BOUNDARY DATA SHOWN WAS OBTAINED FROM (DEEDS, RECORDED SUBDIVISION PLAT OR OTHER PUBLIC RECORDS)

LOCATIONS AS SHOWN OF ADJACENT WELLS AND SEPTIC TANKS OBTAINED FROM LAKE COUNTY HEALTH DEPARTMENT

DESIGN CERTIFICATION

THIS PLAT WAS PREPARED BY ME, AND IS CORRECT TO THE BEST OF MY KNOWLEDGE AND BELIEF.

Name: [Signature] Registration No. 6343

CHECK LIST

NO. OF BEDROOMS	WATER MAIN SIZE, LOCATION
DIMENSIONS	SAN. SEWER SIZE & GR. LOC.
BEARINGS	SAN. MH. CAST. ELEV. INV. ELEV.
TIE TO NEAREST STREET	SAN. CONN. SIZE, LOC. DEPTH
SUBLOT NO. PARCEL NO.	STORM SEWER SIZE & GR. LOC.
SURROUNDING OWNERS	STORM MH. CAST ELEV. INV. ELEV.
BLDG. DIMENSIONS FIN GR.	PAV'T TYPE GRADE CURBS
BLDG. TIES FL'R. GRADES	GAS LINE LOC. SIZE PRESSURE
APRON TYPE WIDTH THICKNESS	SEPTIC TANK LOCATION & DUPLICATION AREA
SIDEWALK TYPE WIDTH THICKNESS	WELL LOCATION
CULVERT TYPE DIA. LENGTH	ISOLATION RADIUS FROM WELL
ROCK OUTCROPPINGS	

REVISIONS		
NO.	DATE	BY
1		
2		
3		
4		
5		

PLAN PREPARED BY:			
BABCOCK JONES & ASSOCIATES, INC.			
PAINESVILLE, OHIO			
DRAWN BY	T.R.	SCALE	1"=30'
CHK'D.	H.J.	DATE	1/28/99
CREW	W.B.	APP'D	H.J.
CHIEF			

PHONE NO. 440-357-1811
DRAWING NO. 91-180-42

"AS BUILT" CERTIFICATION

I, HEREBY CERTIFY THAT THE CIRCLED GRADES ARE EXISTING FINISH GRADES CHECKED IN THE FIELD ON 3/17/99, 1999 AND ARE CORRECT TO THE BEST OF MY KNOWLEDGE AND BELIEF.

REGISTERED SURVEYOR

Grading Plan Approved as shown and/or noted by: THOMAS P. GILLES, P.E. Lake County Engineer

Date: 3/17/99

DRIVE ADJUTANT REG-11

10' utility eas't

15" DRIVE ADJUT

1pin ind.-tbn

50' ab.

REG. NO.

TBM-1.PIN FOUND ELEV=100.00

ZONING PERMIT #0299-9286

ISSUED 2/16/99

SUBJECT TO APPROVAL BY:

Lake County Sanitary Eng. ☐

Lake County Chgo. Eng. ☒

Lake County Planning Comm. ☐

at a County Ridge Dist ☒

"I, the undersigned hereby certify that this topography indicated by 6", 1", or 2" contours, and elevations shown hereon represent an actual field survey made by me on the 20th day of Jan, 1999 and that the elevations were taken at appropriate intervals and that as of that date they existed as indicated hereon."

Name: [Signature] Reg. No. 6343