


TOPOGRAPHICAL SURVEY
CDT CUSTOM HOMES

KNOWN AS BEING SUBLOT No. 6 IN THE HAUTHOENE
WOODS SUBDIVISION AS RECORDED IN VOL. 15, PG. 46
OF LAKE COUNTY MAP RECORDS; NOW IN THE:
TOWNSHIP OF CONCORD, COUNTY OF LAKE, STATE OF OHIO

"I, THE UNDERSIGNED HEEBY CERTIFY THAT THE TOPOGRAPHY SHOWN HEREON,
INDICATED BY ONE FOOT CONTOURS AND ELEVATIONS REPRESENTS AN ACTUAL
FIELD TOPOGRAPHIC SURVEY MADE BY ME ON THE 20TH DAY OF MARCH, 1997
AND THAT THE ELEVATIONS WERE TAKEN AT APPROPRIATE INTERVALS AND THAT
AS OF THAT DATE THEY EXISTED AS SHOWN HEREON."

BENCHMARK SURVEY CO.
5964 S. RIDGE RD
MADISON, OHIO 44057 428-8599

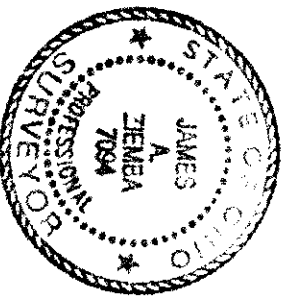


BEARINGS SHOWN HEREON ARE TO AN ASSUMED MERIDIAN AND ARE USED
TO INDICATE ANGLES ONLY. IRON PINS WERE FOUND OR SET AT ALL POINTS
THEREOF, ALL OF WHICH ARE CORRECT.

JAMES A. ZIEMBA
P.S. #7094


SCALE 1" = 30'



EXISTING GRADE
PROPOSED GRADE
PROPOSED FLOW

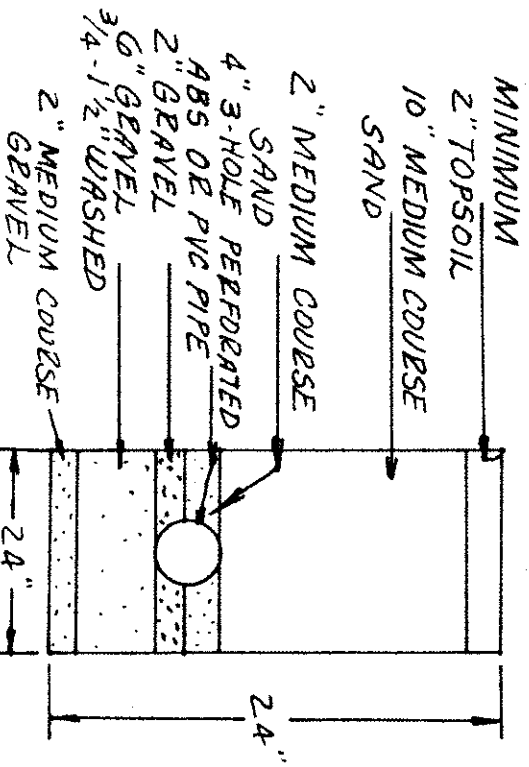

TYPICAL EVAPOTRANSPIRATION
TRENCH CROSS-SECTION

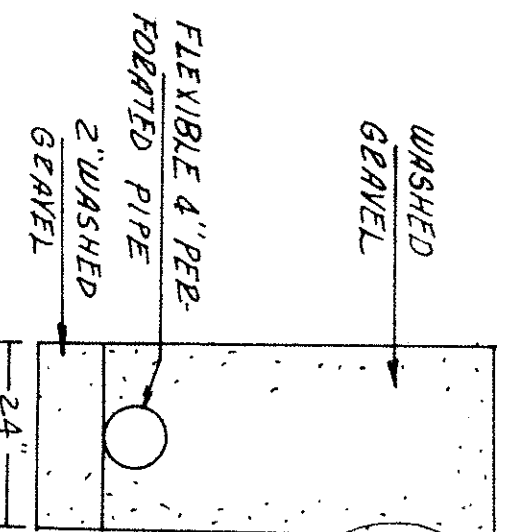


TYPICAL CURTAIN DRAIN
CROSS-SECTION

NOTE:
FOOTER DRAIN TO BE SUMP
PUMPED UP TO DRAINAGE
DRAIN- WHICH WILL GRAVITY
DRAIN GRADING PLAN APPROVED
AS SHOWN AND/OR NOTED
THOMAS P. GILLES, P.E.
Lake County Engineer


ROOF DRAINS
SHALL DISCHARGE
TO SPLASH BLOCKS.
15" ORIVE

By 6/14 Date 4.14.97

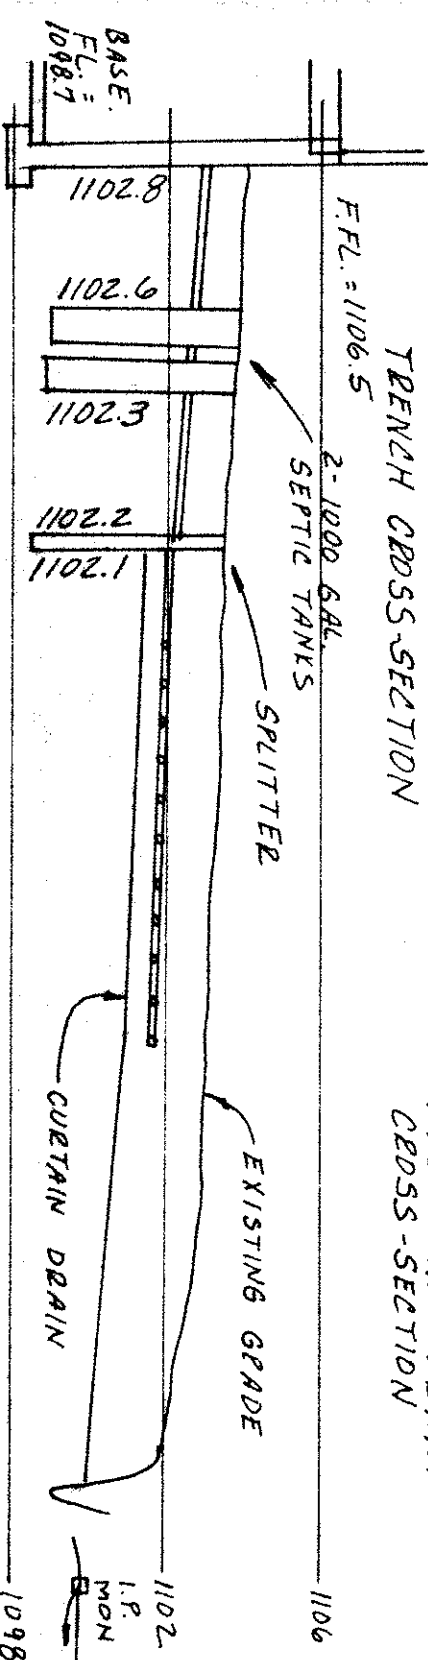

HYDRAULIC PROFILE
HORIZ. 1" = 40' VERT. 1" = 5'

BEAURVICH WOODS AVE. 60'

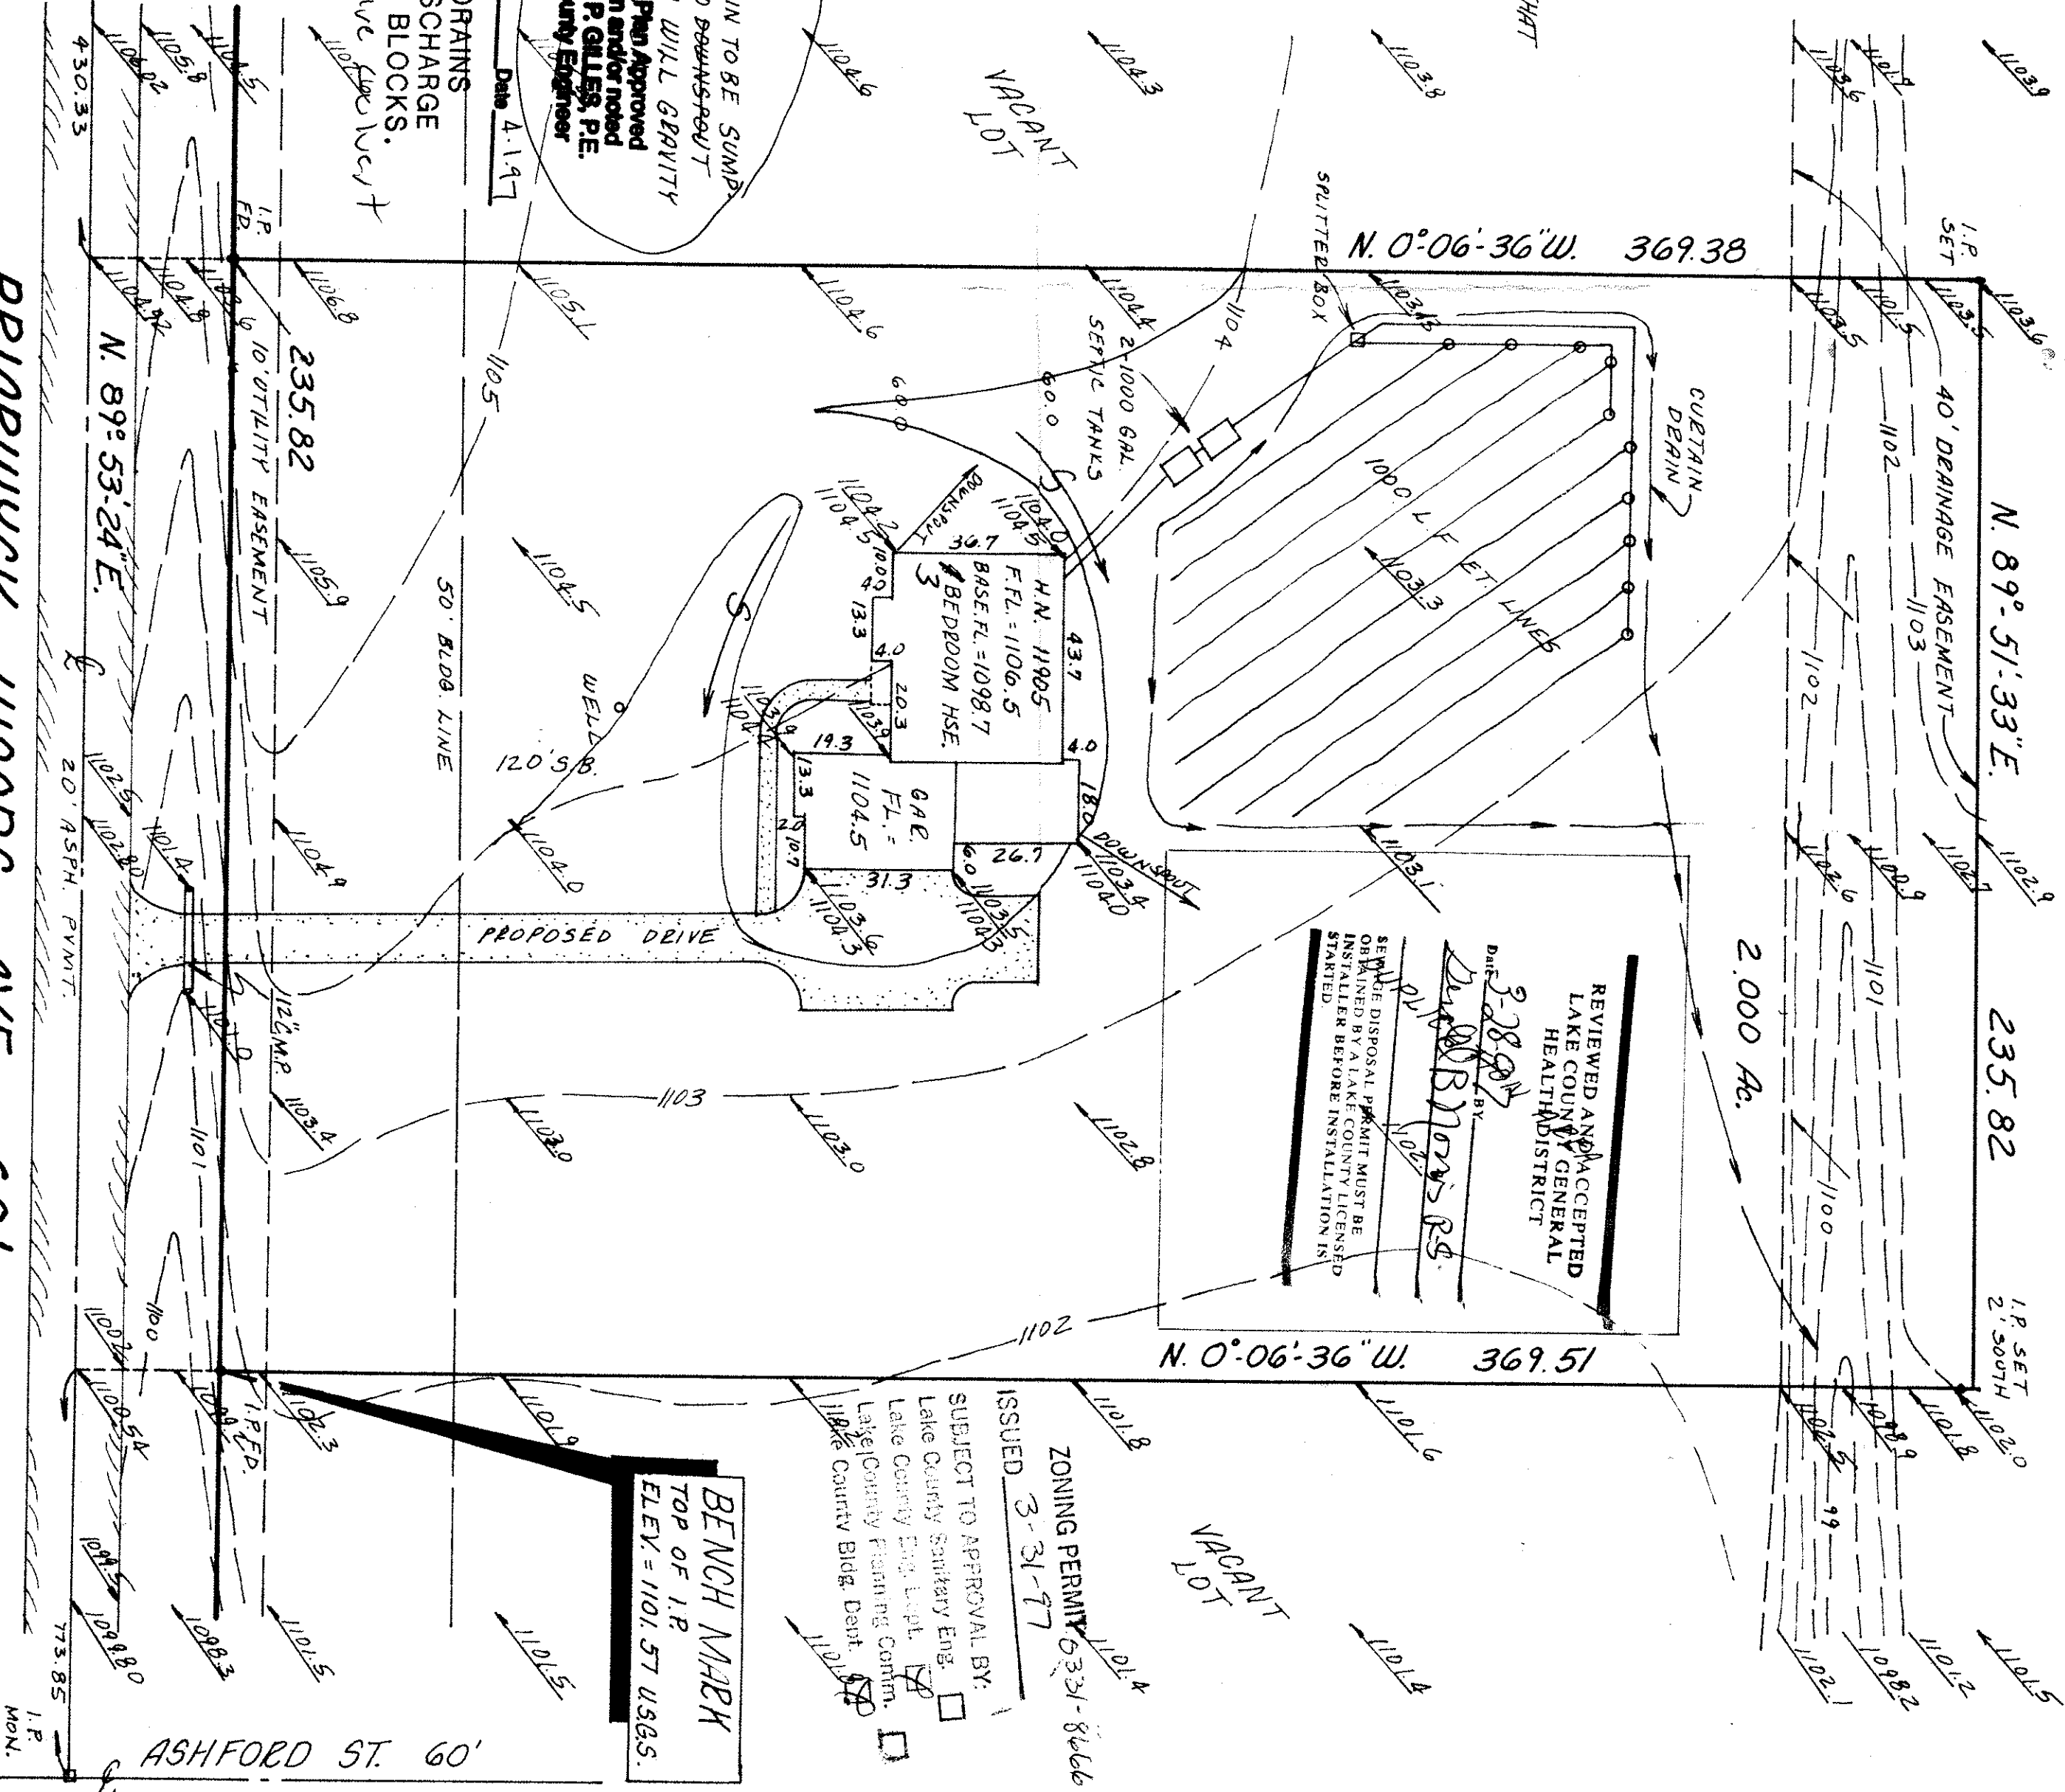

REVIEWED AND ACCEPTED
LAKE COUNTY GENERAL
HEALTH DISTRICT
Date 3-28-97
By [Signature]

SEWER DISPOSAL PERMIT MUST BE
OBTAINED BY A LAKE COUNTY LICENSED
INSTALLER BEFORE INSTALLATION IS
STARTED

ZONING PERMIT 6341-8466
ISSUED 3-31-97
SUBJECT TO APPROVAL BY:
Lake County Sanitary Eng. ☐
Lake County Eng. Dept. ☐
Lake County Planning Comm. ☐
Lake County Bldg. Dept. ☐

BENCH MARK
TOP OF I.R.
ELEV. = 1101.57 USGS.

ASHFORD ST. 60'