


UNDERGROUND UTILITIES:
THE SIZE AND LOCATION OF THE
UTILITIES SHOWN HEREON
HAVE BEEN OBTAINED FROM AVAILABLE RECORDS
AND FIELD SURVEY. THE ENGINEER HAS BEEN
ADVISED BY THE OWNER THAT THE UTILITIES
SHOWN ARE NEARLY THE COMPLETE LIST. THE
ENGINEER HAS BEEN ADVISED THAT THE
CONTRACTOR SHALL VERIFY THE DEPTH AND LOCATION
OF UTILITY CONNECTIONS. UUPS: 1-800-362-2164

NOTE:
ALL EROSION AND SEDIMENT CONTROL SPECIFICATIONS
ARE TO BE IN ACCORDANCE WITH THE LAKE COUNTY
EROSION AND SEDIMENT CONTROL RULES AS
ADOPTED DECEMBER 21, 1999


PAGE 1 #
08A014-E
00011-0
SCALE 1"=30'
25 50
APRIL, 2006

CONCORD TOWNSHIP ZONING OFFICE
Zoning Permit # 0406 12052 0508-134B1
Date Issued 5/14/08
Subject to Approval By:
☒ Lake Co. Engineer/Storm Water Mgmt.
☒ Lake Co. Utilities Dept.
☒ Lake Co. Soil + Water District
☒ Lake Co. Health District
☒ Lake Co. Building Dept.

LAWRENCE DAKIN
DC #2002R044427
NOT PART OF SUB.

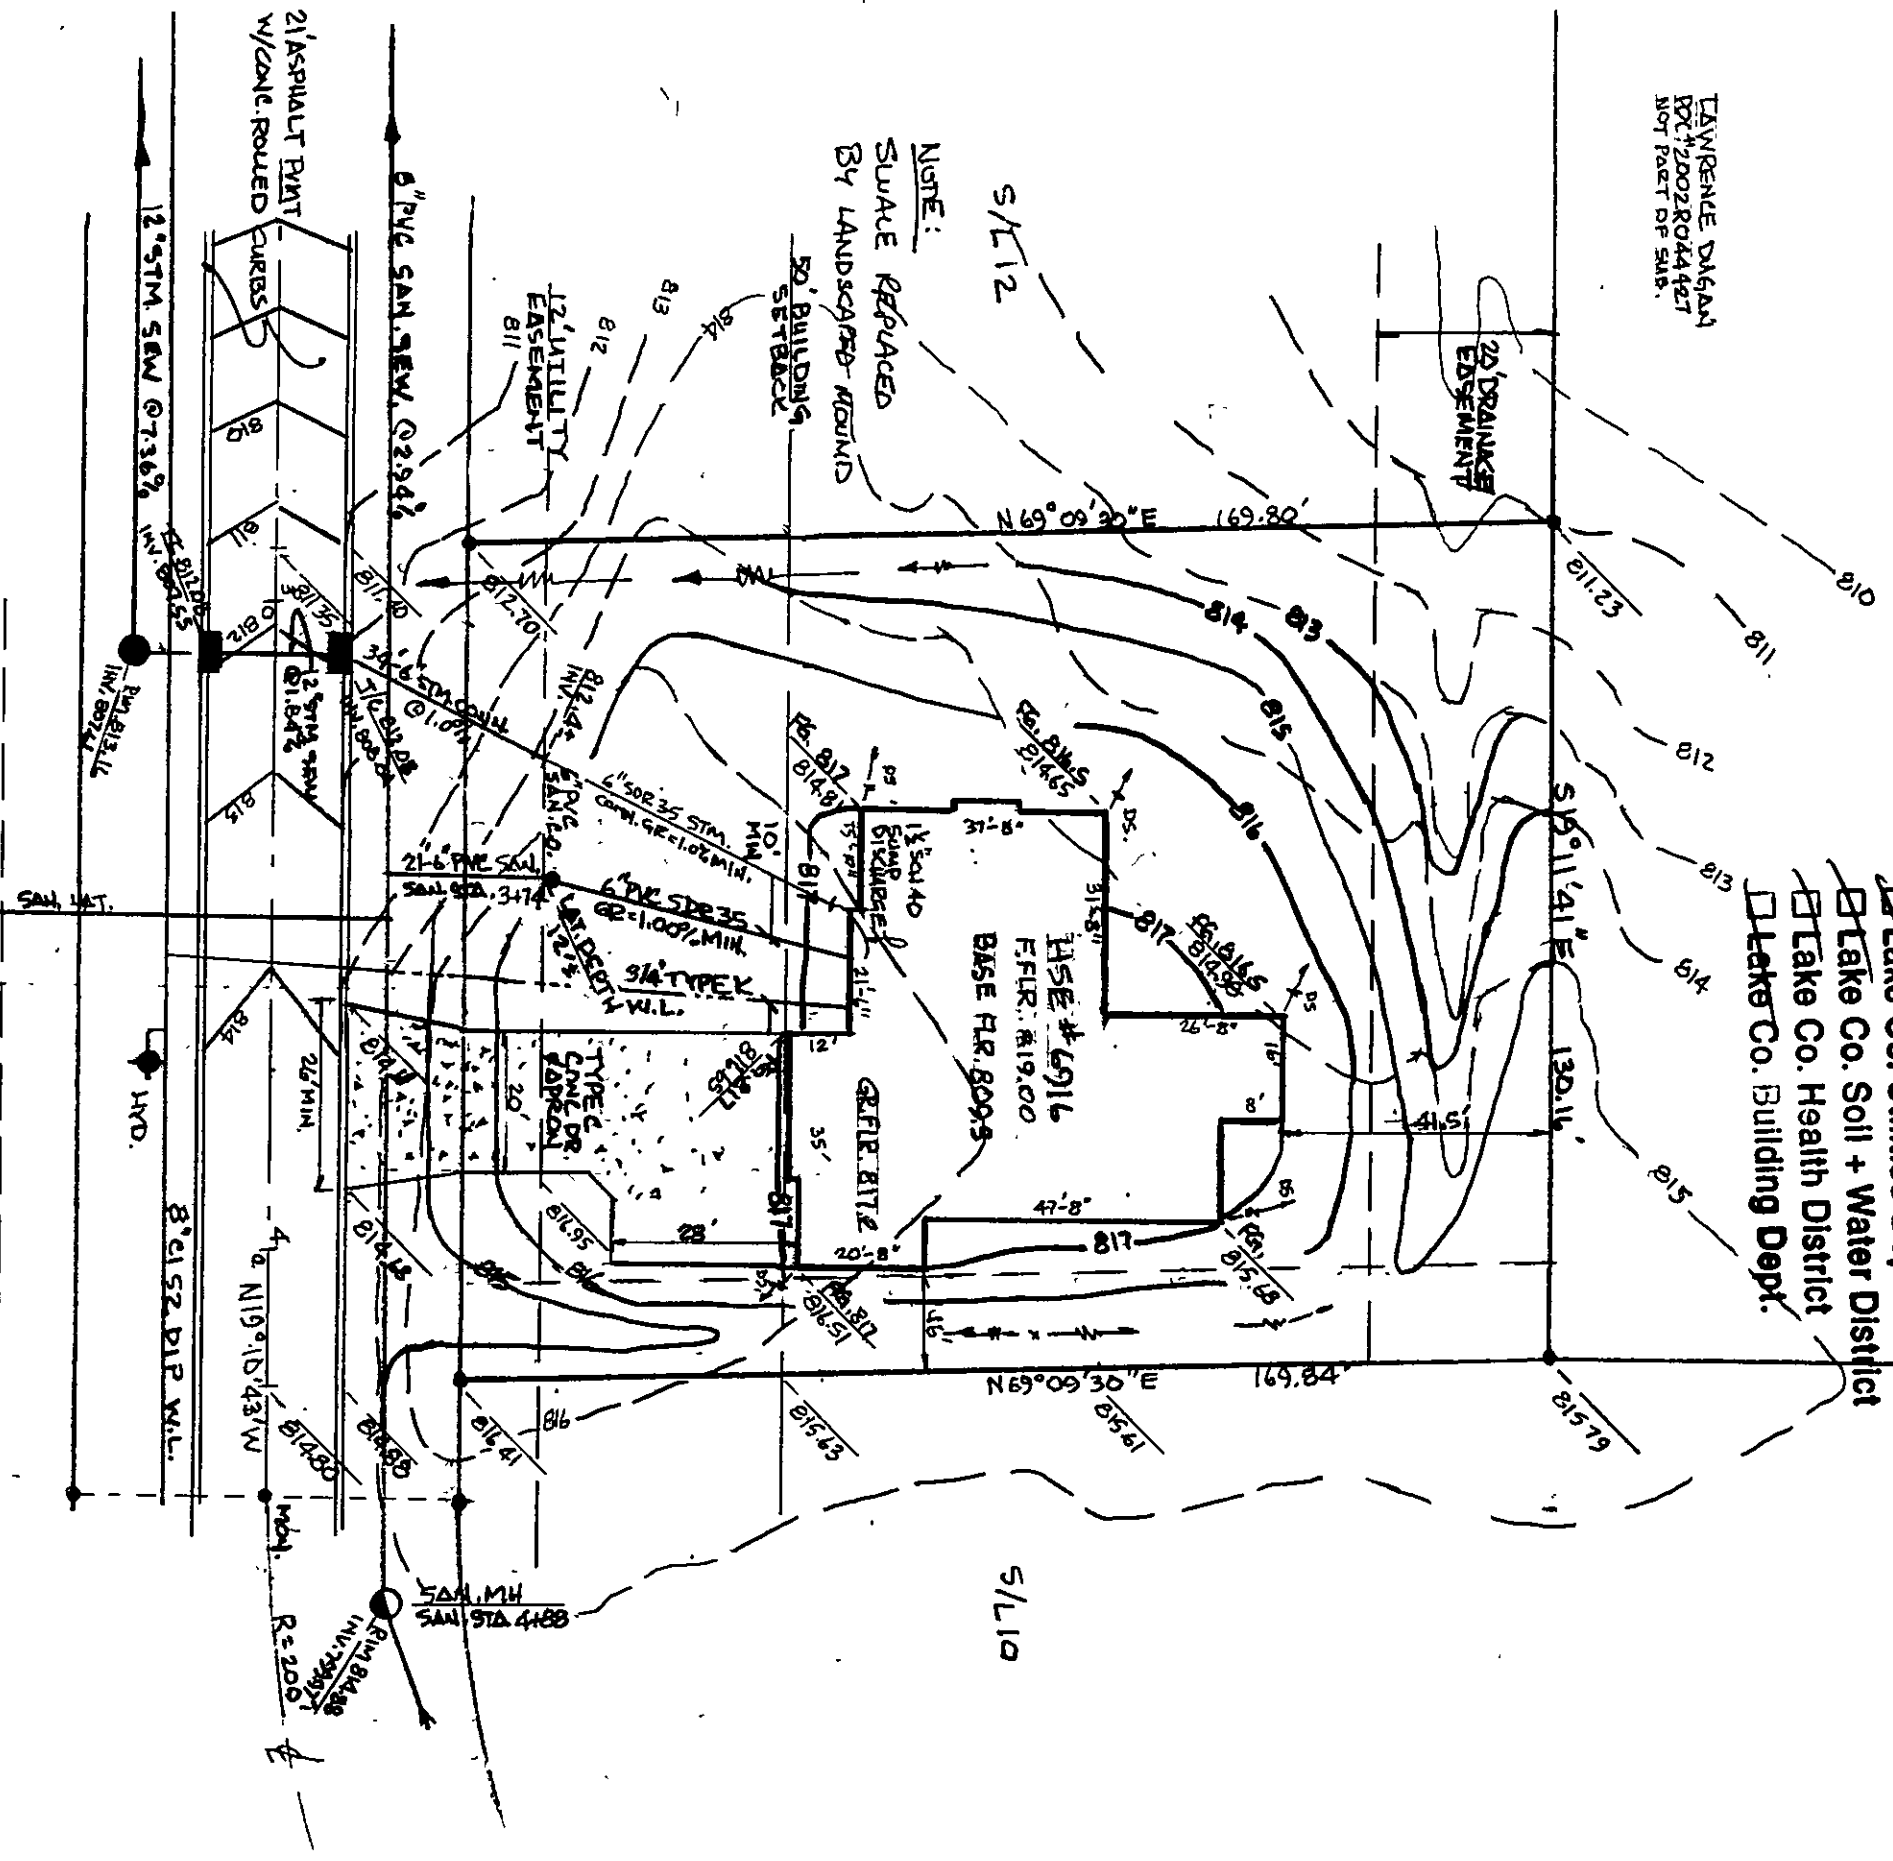

LEGEND
STORM M
SANITARY M
WATERLINE CON.
EXISTING CONTOURS
PROPOSED CONTOURS
PROPOSED ELEV. 10000
EXISTING ELEV. 10000
DIRECTION OF SURFACE DRAINAGE

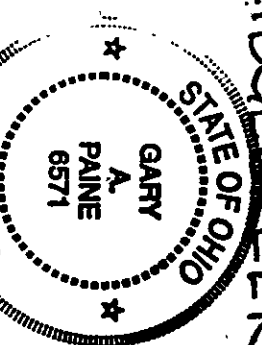

SURVEYOR
THIS PLAN WAS PREPARED BY
ME AND IS SUBJECT TO THE BEST
OF MY KNOWLEDGE AND BELIEF
GARY A. PAINE REG. SURVEYOR
NO. 6571


BRIDGE CREEK DRIVE ~ 60'

Stormwater Management Plan
Approved as shown and/or noted
JAMES R. GILLS, P.E.
County Drainage Engineer
By A.S. Date 5/15/08


SITE PLAN
FOR: COUNTRYSIDE HOMES
8236 WESTVIEW NOVELTY, OHIO
SUBJECT NO. BRIDGE CREEK ESTATES 50 3
CONCORD LAKES VOL. 14
CITY/TOWNSHIP COUNTY STATE

UNDERGROUND UTILITIES
THE SIZE AND LOCATION, HORIZONTAL AND VERTICAL, OF THE UNDERGROUND UTILITIES SHOWN HEREON HAVE BEEN OBTAINED FROM AVAILABLE RECORDS, VERIFICATION BY FIELD OBSERVATION HAS BEEN CONDUCTED WHERE PRACTICABLE. HOWEVER, NEITHER THE COMPLETENESS NOR THE ACCURACY ARE GUARANTEED. THE CONTRACTOR SHALL VERIFY DEPTH AND LOCATION OF UTILITY CONNECTIONS. OUP's: 1-800-362-2764

NOTE:
ALL EROSION AND SEDIMENT CONTROL SPECIFICATIONS ARE TO BE IN ACCORDANCE WITH THE LAKE COUNTY EROSION AND SEDIMENT CONTROL RULES AS ADOPTED DECEMBER 21, 1999
*SEE ATTACHED PLAN.

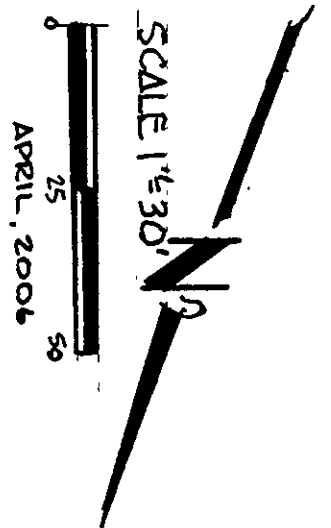


LAWRENCE DIAGAN
PC#2002R044421
NOT PART OF S&B.

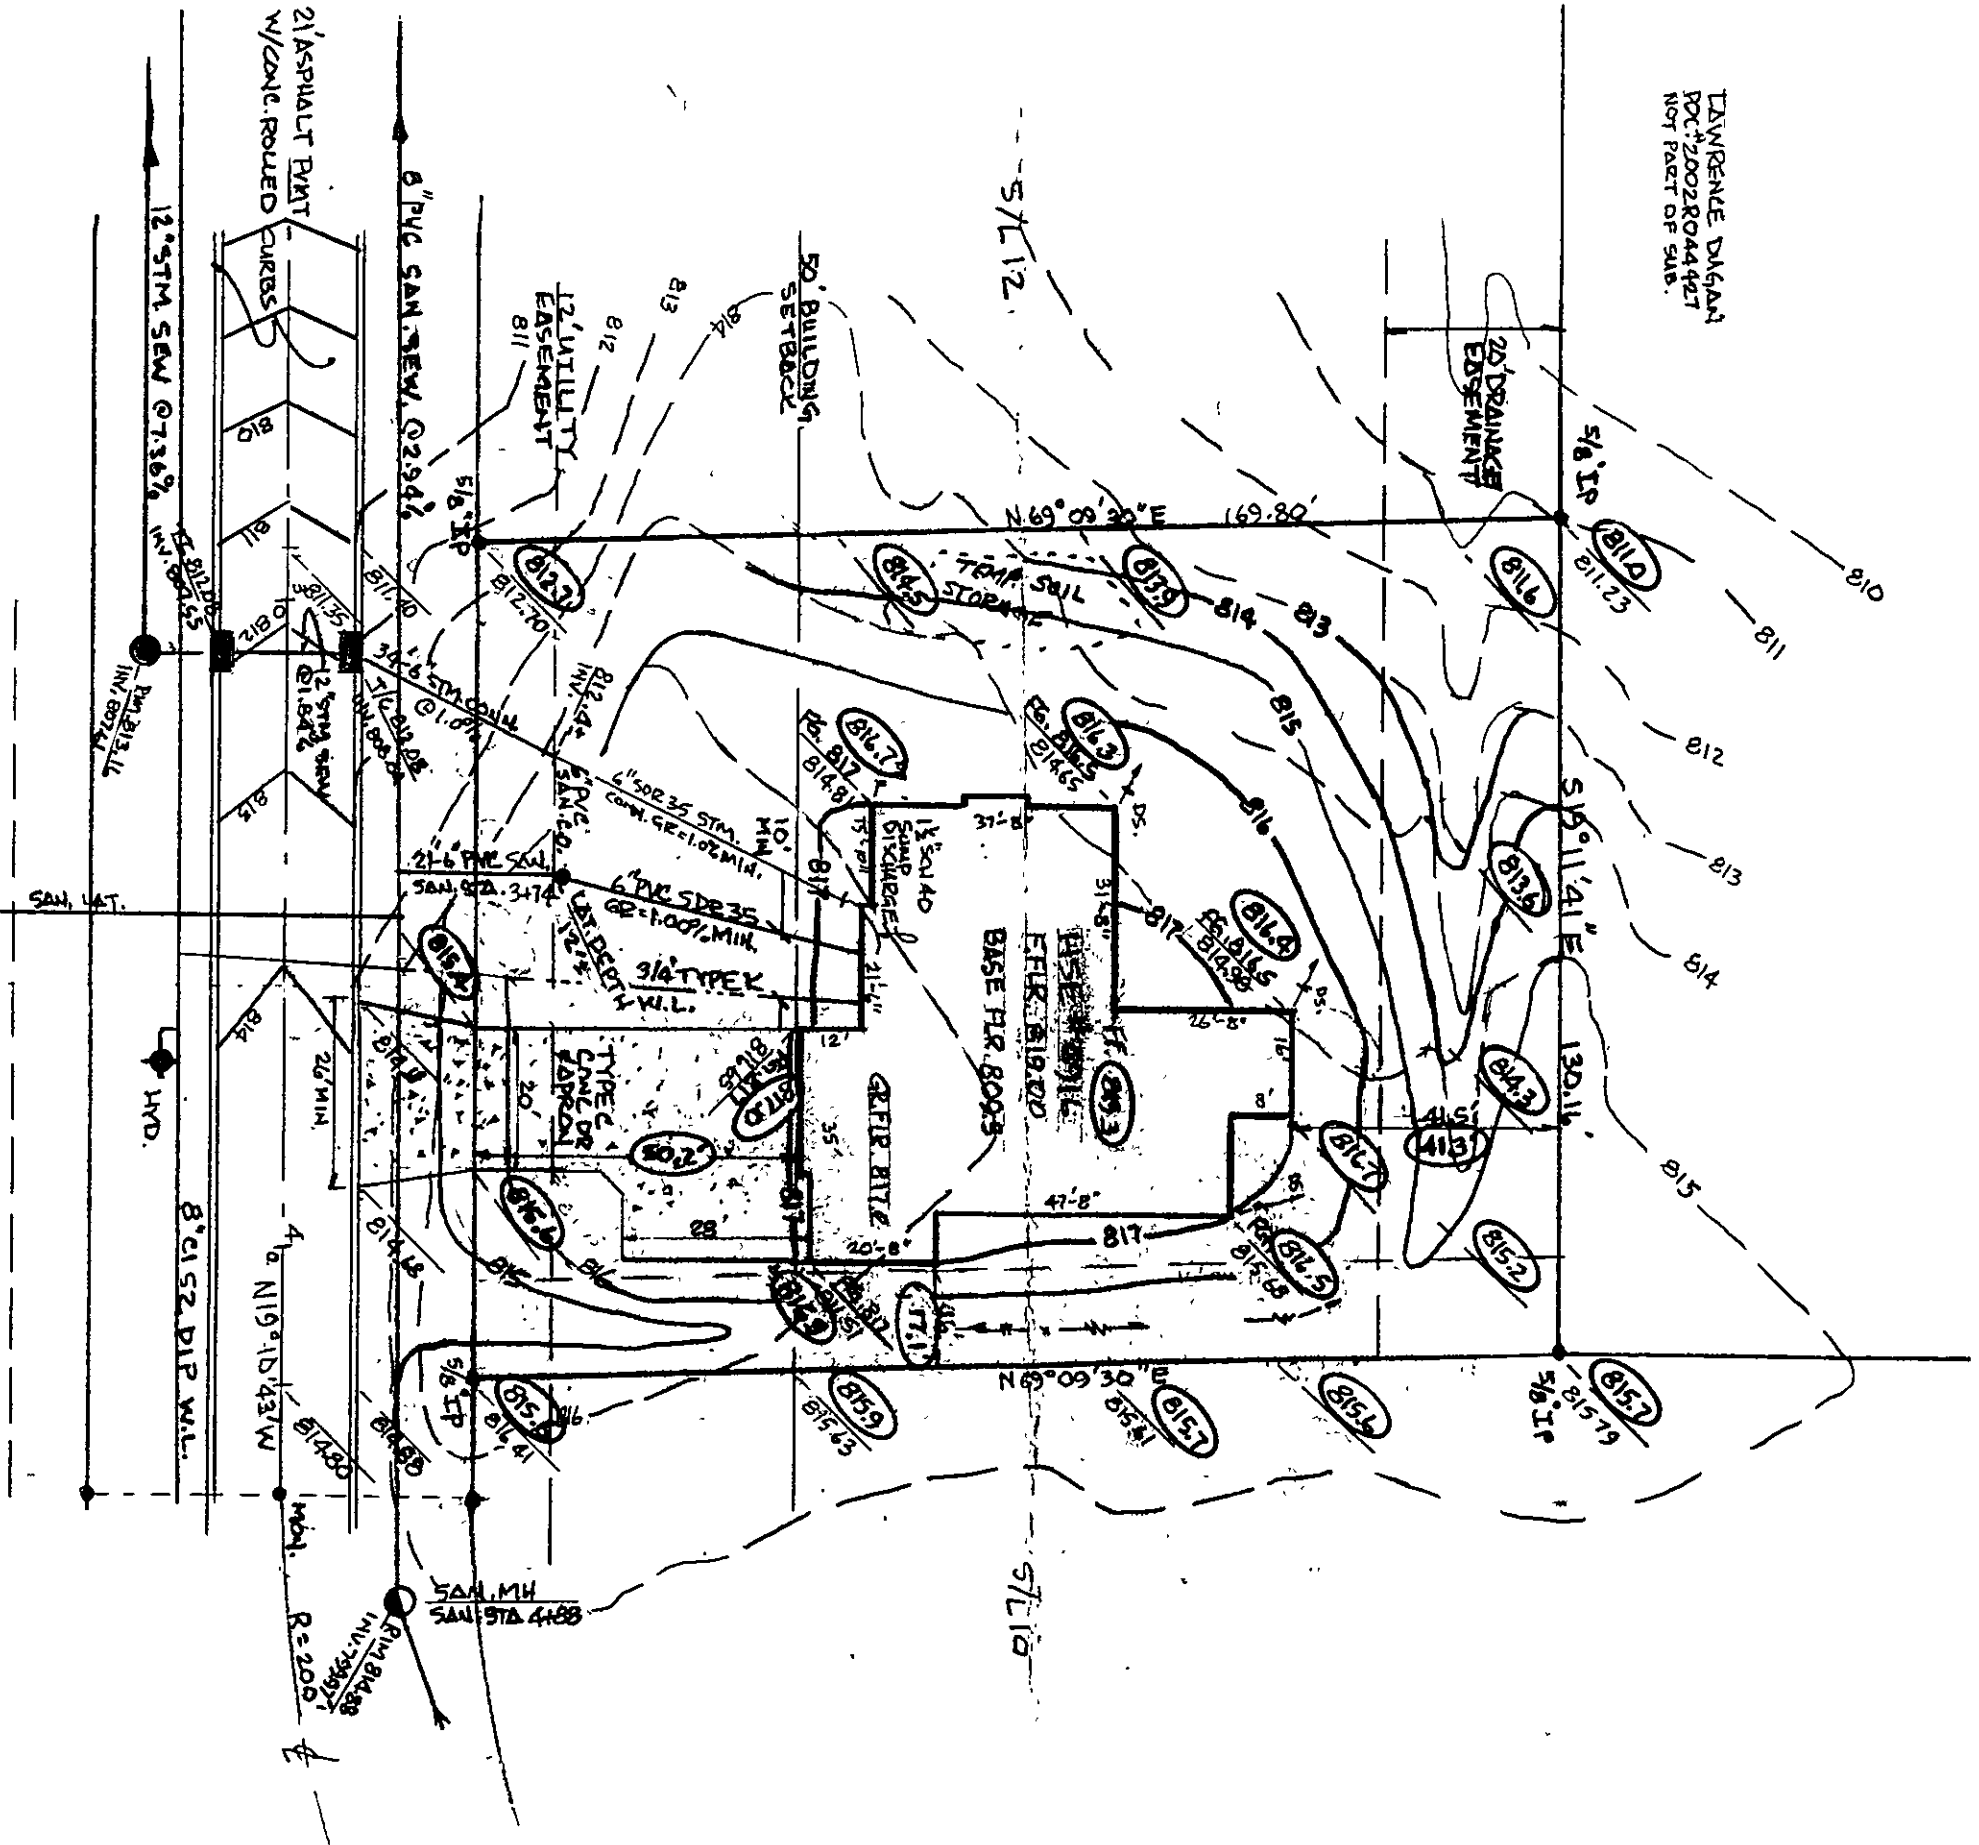

BRIDGE CREEK DRIVE ~ 60'

LEGEND
STORM M
SANITARY M
WATERLINE CONN.
EXISTING CONTOURS
PROPOSED CONTOURS
PROPOSED ELEV. E.g. 1000.0
EXISTING ELEV. 1000.0
AS-BUILT INFORMATION
DIRECTION OF SURFACE - W

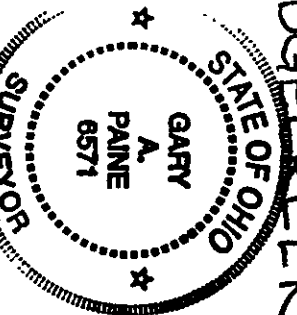

SUPERVISOR
THIS PLAN WAS PREPARED BY ME AND IS CORRECT TO THE BEST OF MY KNOWLEDGE AND BELIEF
GARY A. PAINE REG. SURVEYOR
NO. 6571

"AS BUILT" CERTIFICATION
I HEREBY CERTIFY THAT THE CIRCLED INFORMATION IS EXISTING AS OBTAINED ON THE SITE IN 2009 AND IS CORRECT TO THE BEST OF MY KNOWLEDGE AND BELIEF
NAME: GARY A. PAINE # 6571

SITE PLAN
FOR: COUNTRYSIDE HOMES
8236 WESTRIVER NOVELTY OHIO
SUBDIVISION NO. BRIDGE CREEK ESTATES SD 3
CONCORD LAKES VOL. 15
CITY/TOWNSHIP COUNTY STATE
P41.08-A-014-E-00-011-0 STATE